

**LGD WELL PAD
WELL NO. 201
ARSENAL RESOURCES**

RECEIVED
Office of Oil and Gas

JUL 23 2025

WV Department of
Environmental Protection

T.H. LATITUDE 39°17'30"
B.H. LATITUDE 39°15'00"

CURVE	RADIUS	ARC LENGTH	CHORD LENGTH	CHORD BEARING
C1	325.83'	78.49'	78.30'	S 13°13' W
C2	179.62'	45.02'	44.90'	S 01°01' E
C3	800.60'	184.52'	184.12'	S 14°48' E
C4	3196.64'	475.26'	474.83'	S 25°39' E
C5	2189.22'	332.53'	332.21'	S 34°12' E
C6	919.50'	100.03'	99.98'	S 41°39' E
C7	2951.29'	299.94'	299.81'	S 47°41' E
C8	5517.85'	399.94'	399.85'	S 48°31' E
C9	1840.78'	299.89'	299.56'	S 38°12' E
C10	1636.87'	399.98'	398.98'	S 26°57' E
C11	1901.43'	239.64'	239.48'	S 22°39' E
C12	331505.67'	799.84'	799.84'	S 28°46' E
C13	1916.71'	499.90'	498.49'	S 18°07' E
C14	36612.86'	899.88'	899.85'	S 11°40' E
C15	2192.52'	401.29'	400.73'	S 14°57' E

T.H. LONGITUDE 80°20'00"
B.H. LONGITUDE 80°20'00"

LEGEND

LEASE LINE
SURFACE LINE
WELL LATERAL
500' OFFSET LINE
TIE LINE
CREEK
ROAD
COUNTY ROUTE
PROPOSED WELL
EXISTING WELL
PERMITTED WELL
TAX MAP-PARCEL
SURFACE OWNER (SEE TABLE)
LEASE # (SEE WW-6A1)

(S.P.C. NORTH ZONE) (UTM(M) ZONE 17)

NAD'83 S.P.C.(FT) N. 279,286.90 E. 1,723,448.56
NAD'83 GEO. LAT-(N) 39.263552 LONG-(W) 80.365497
NAD'83 UTM (M) N. 4,346,215.68 E. 554,738.58

LANDING POINT

NAD'83 S.P.C.(FT) N. 277,582.7 E. 1,723,558.5
NAD'83 GEO. LAT-(N) 39.258903 LONG-(W) 80.365051
NAD'83 UTM (M) N. 4,345,700.1 E. 554,780.7

BOTTOM HOLE

NAD'83 S.P.C.(FT) N. 259,342.0 E. 1,730,513.5
NAD'83 GEO. LAT-(N) 39.208978 LONG-(W) 80.339887
NAD'83 UTM (M) N. 4,340,175.1 E. 556,992.1

**AS DRILLED COORDINATES
FOR WELL NO. 201**

(S.P.C. NORTH ZONE) (UTM(M) ZONE 17)

NAD'83 S.P.C.(FT) N. 279,286.90 E. 1,723,448.56
NAD'83 GEO. LAT-(N) 39.263552 LONG-(W) 80.365497
NAD'83 UTM (M) N. 4,346,215.68 E. 554,738.58

LANDING POINT

NAD'83 S.P.C.(FT) N. 277,582.7 E. 1,723,548.0
NAD'83 GEO. LAT-(N) 39.258901 LONG-(W) 80.365089
NAD'83 UTM (M) N. 4,345,709.8 E. 554,777.3

BOTTOM HOLE

NAD'83 S.P.C.(FT) N. 259,331.8 E. 1,730,539.9
NAD'83 GEO. LAT-(N) 39.208981 LONG-(W) 80.339793
NAD'83 UTM (M) N. 4,340,172.1 E. 557,000.2




12 Venhorn Drive | P.O. Box 150 | Glenville, WV 26351 | 304.462.5634
1412 Kanawha Boulevard, East | Charleston, WV 25301 | 304.346.3952
254 East Beckley Bypass | Beckley, WV 25801 | 304.255.5296
slsww.com

NOTES ON SURVEY

1. NO WATER WELLS WERE FOUND WITHIN 250' OF PROPOSED GAS WELL. NO AGRICULTURAL BUILDINGS > 2500 SQ. FT. OR DWELLINGS WERE FOUND WITHIN 625' OF THE CENTER OF PROPOSED WELL PAD.
2. WELL SPOT CIRCLE & TOPO MARK SCALE ARE 1" = 2000'.
3. AS-DRILLED DATA PROVIDED BY ARSENAL RESOURCES
4. PLAT UPDATED TO SHOW AS-DRILLED PATH.


REFERENCES

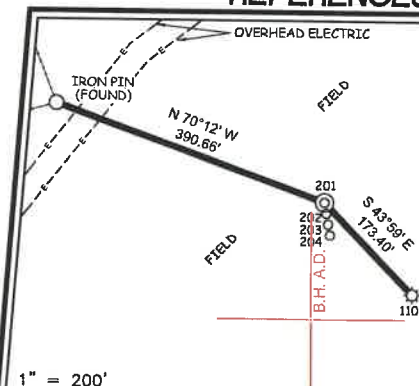

I THE UNDERSIGNED, HEREBY CERTIFY THAT THIS PLAT IS CORRECT TO THE BEST OF MY KNOWLEDGE AND BELIEF AND SHOWS ALL THE INFORMATION REQUIRED BY LAW AND THE REGULATIONS ISSUED AND PRESCRIBED BY THE DIVISION OF ENVIRONMENTAL PROTECTION.

P.S.
677

Gregory A. Smith

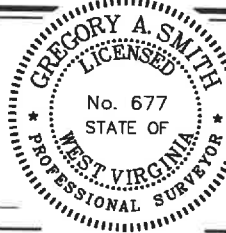

(+) DENOTES LOCATION OF WELL ON UNITED STATES TOPOGRAPHIC MAPS

DATE SEPTEMBER 11, 20 24

REVISED JUNE 1, 20 25

OPERATORS WELL NO. 201

API WELL NO. 47-033-06023
STATE COUNTY PERMIT

MINIMUM DEGREE OF ACCURACY 1/2500 FILE NO. 9423P201AD.dwg

HORIZONTAL & VERTICAL SCALE 1" = 2000'
CONTROL DETERMINED BY: DGPS (SURVEY GRADE TIE TO CORS NETWORK)

STATE OF WEST VIRGINIA
DIVISION OF ENVIRONMENTAL PROTECTION
OFFICE OF OIL AND GAS



WELL TYPE: OIL GAS ☒ LIQUID WASTE IF INJECTION DISPOSAL "GAS" PRODUCTION ☒ STORAGE DEEP SHALLOW ☒

LOCATION: ELEVATION 1,007.60' WATERSHED WEST FORK RIVER

DISTRICT CLARK COUNTY HARRISON

SURFACE OWNER LAURA GOFF DAVIS

ROYALTY OWNER LAURA GOFF DAVIS, ET AL

PROPOSED WORK:

DRILL ☒ CONVERT DRILL DEEPER REDRILL FRACTURE OR STIMULATE ☒ PLUG OFF OLD

FORMATION PERFORATE NEW FORMATION PLUG AND ABANDON CLEAN OUT AND REPLUG OTHER

PHYSICAL CHANGE IN WELL (SPECIFY) TARGET FORMATION MARCELLUS
ESTIMATED DEPTH TMD 27,290.00' / TVD 7,130.27'

WELL OPERATOR ARSENAL RESOURCES

DESIGNATED AGENT ERIC MORRIS

ADDRESS 6031 WALLACE RD. EXT. SUITE 200
WEXFORD, PA 15090

ADDRESS 633 WEST MAIN STREET
BRIDGEPORT, WV 26330


09/19/2025

RECEIVED
Office of Oil and Gas

JUL 23 2025

WV Department of
Environmental Protection

FORM WW 6 - SHEET 2 OF 3

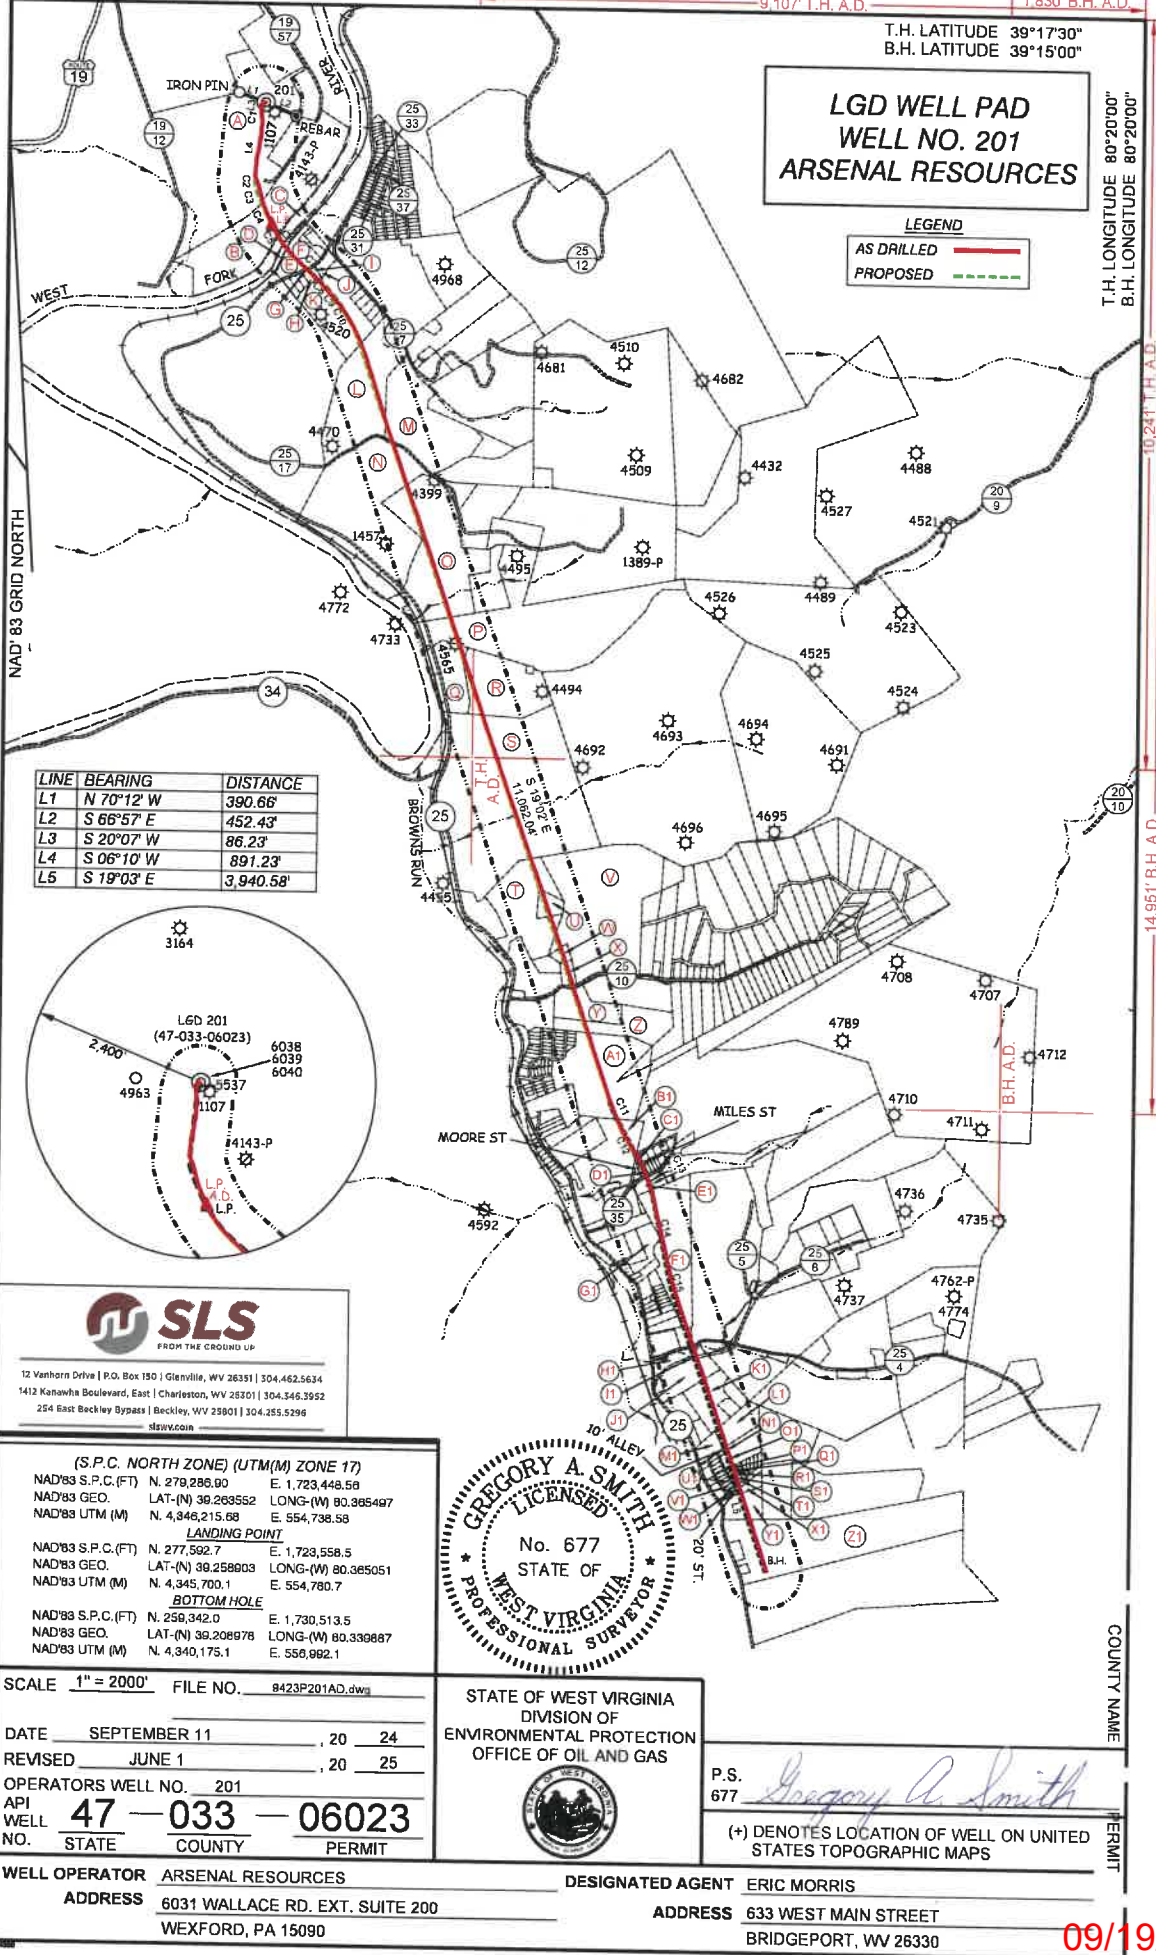

**LGD WELL PAD
WELL NO. 201
ARSENAL RESOURCES**



12 Vanhorn Drive | P.O. Box 150 | Glenville, WV 26351 | 304.482.5634
1412 Kanawha Boulevard, East | Charleston, WV 25301 | 304.346.1952
254 East Beckley Bypass | Beckley, WV 25801 | 304.255.5298
sllwv.com

TAG	PARCEL	SURFACE OWNER	ACREAGE
A	1-326-37	LAURA GOFF DAVIS	161.22
ROAD	N/A	COUNTY ROUTE 19/57-ARMORY ROAD	N/A
B	1-326-38.1	WEW REAL ESTATE HOLDING LLC	37.65
C	N/A	WEST FORK RIVER	N/A
D	1-326-102	W.V. STATE RAIL AUTHORITY	108.47
E	1-326-78	MICHAEL F & CECELIA DAUGHERTY	2.43
F	1-326-55	WILLIAM H & CHRISTY S SMITH	3.12
G	N/A	STATE OF W.V. (WESTON-FAIRMONT TURNPIKE)	N/A
H	1-326-78.11	MICKEY G PETITTO	0.38
I	1-326-78.2	ROBERT R WAGNER II	0.458
J	1-326-56	ROBERT R WAGNER II	1.22
K	1-326-78.1	HILARION V CANN ET AL	16.71
L	1-326-80	ROGER L & SANDRA CHILDERS	28.36
M	1-346-36	LESTER G ANDERSON JR	25.4
ROAD	N/A	COUNTY ROUTE 25/17- RED DOG ROAD	N/A
N	1-346-35	HILARION V CANN ET AL	40.942
O	1-346-63	HILARION V CANN ET AL	35.11
P	1-347-29	KURT SKASIK	60.8
Q	1-346-85	MARK A SKASIK	14.17
R	1-347-30	KURT SKASIK	16.76
S	12-347-31	W VA DNR	91.747
T	12-347-41	ROBERT CLUTTER	19.66
U	12-347-41.2	SHARON LOUISE CAIN (LE)	2.35
V	12-347-41.6	TOMMY FORNASH	47.71
W	12-347-65.4	TOMMY D & FORNASH ET AL	4.57
X	12-347-41.7	CRYSTAL CROPP	1.52
ROAD	N/A	COUNTY ROUTE 25/10-MT CLARE & NORWOOD RD.	N/A
Y	12-367-4	CLIFTON RAWLINGS	9
Z	12-367-6	HOWARD LEE SPARKS JR	9
A1	12-367-33	GDS WV HOLDINGS LLC	22.92
B1	12-367-34.1	LISA FLOWERS ET AL	18.04
ROAD	N/A	MOORE ST OF A.A. KNIGHT LOTS	N/A
C1	12-2008-11	LISA FLOWERS & GARY STUTLER	LOT 10
ROAD	N/A	MILES ST OF A.A. KNIGHT LOTS	N/A
D1	12-2008-19	DEBRA ANN MCCUTCHEON	LOT 3
ROAD	N/A	CO. RT. 25/35-KNIGHT ST OF A.A. KNIGHT LOTS	N/A
E1	12-2008-30	DEBRA ANN MCCUTCHEON	1.82
F1	12-367-40	BRIAN D & MELISSA D GALLOWAY	22.28
G1	12-367-84	ROBERT H CORK	4.95
ROAD	N/A	COUNTY ROUTE 25/4-CHUBB RUN RD.	N/A
H1	12-367-53	JOSHUA I DEAN	3
I1	12-2010-61	PATRICK CUNNINGHAM DBA	0.7
J1	12-367-69	GEORGE STEPHEN ROGERS	4.12
K1	12-367-69.1	GEORGE STEPHEN ROGERS	6.98
L1	12-387-4.1	MICHAEL GLENN HARDMAN	4.62
M1	12-387-4	TIMMY LEE SEARCEY	2.26
ROAD	N/A	10' ALLEY HOLDEN ADDITION OF MT CLARE	N/A
N1	12-2012-16	GUY & VERNIE RUSSELL ESTATE	LOT 9
O1	12-2012-13	JO ANN HILEMAN	LOTS 10-12
ROAD	N/A	HARP ROAD 927	N/A
P1	12-2012-35	AMANDA RAE SNIDER	LOT 23
Q1	12-2012-34	NAJ LLC	LOT 24
R1	12-2012-33	EARL PATRICK FRAZIER JR	LOT 25
S1	12-2012-32	EARL PATRICK FRAZIER JR	LOT 26
T1	12-2012-31	EARL PATRICK FRAZIER JR	LOT 27
U1	12-2012-29	EARL PATRICK FRAZIER JR	LOT 19
V1	12-2012-30	EARL PATRICK FRAZIER JR	LOT 18
ROAD	N/A	20' ALLEY HOLDEN ADD. OF MT CLARE(CHERRY HILL ROAD)	N/A
W1	12-2012-20	KRISTINA MARIE CHRISTIAN	0.26
X1	12-387-6	ALTA MARIE SKIDMORE ET AL	1.26
Y1	12-387-7	CHARLES S MILLER	4.84
Z1	12-387-22	RONALD H ROGERS	49.74

RECEIVED
Office of Oil and Gas

JUL 23 2025

WV Department of
Environmental Protection

FILE NO. 9423P201AD.dwg			STATE OF WEST VIRGINIA DIVISION OF ENVIRONMENTAL PROTECTION OFFICE OF OIL AND GAS 	COUNTY NAME	
DATE SEPTEMBER 11, 2024	REVISED JUNE 1, 2025			P.S. 677 	PERMIT
OPERATORS WELL NO. 201					
API WELL NO. 47	STATE 051				
WELL OPERATOR ARSENAL RESOURCES		DESIGNATED AGENT ERIC MORRIS			
ADDRESS 6031 WALLACE RD. EXT. SUITE 200 WEXFORD, PA 15090		ADDRESS 633 WEST MAIN STREET BRIDGEPORT, WV 26330			


09/19/2025

**LGD WELL PAD
WELL NO. 201
ARSENAL RESOURCES**T.H. LATITUDE 39°17'30"
B.H. LATITUDE 39°15'00"

CURVE	RADIUS	ARC LENGTH	CHORD LENGTH	CHORD BEARING
C1	325.83'	78.49'	78.30'	S 13°13' W
C2	179.62'	45.02'	44.90'	S 01°01' E
C3	800.60'	184.52'	184.12'	S 14°48' E
C4	3196.64'	475.26'	474.83'	S 25°39' E
C5	2189.22'	332.53'	332.21'	S 34°12' E
C6	919.50'	100.03'	99.98'	S 41°39' E
C7	2951.29'	299.94'	299.81'	S 47°41' E
C8	5517.85'	399.94'	399.85'	S 48°31' E
C9	1840.78'	299.89'	299.56'	S 39°12' E
C10	1636.87'	399.98'	398.98'	S 26°57' E
C11	1901.43'	239.64'	239.48'	S 22°39' E
C12	331505.67'	799.84'	799.84'	S 28°46' E
C13	1916.71'	499.90'	498.49'	S 18°07' E
C14	36612.86'	899.88'	899.85'	S 11°40' E
C15	2192.52'	401.29'	400.73'	S 14°57' E

T.H. LONGITUDE 80°20'00"
B.H. LONGITUDE 80°20'00"**LEGEND**


LEASE LINE	---
SURFACE LINE	----
WELL LATERAL	----
500' OFFSET LINE	----
TIE LINE	----
CREEK	----
ROAD	----
COUNTY ROUTE	----
PROPOSED WELL	⊙
EXISTING WELL	⊙
PERMITTED WELL	⊙
TAX MAP-PARCEL	00-00
SURFACE OWNER (SEE TABLE)	⊙
LEASE # (SEE WW-6A1)	⊙

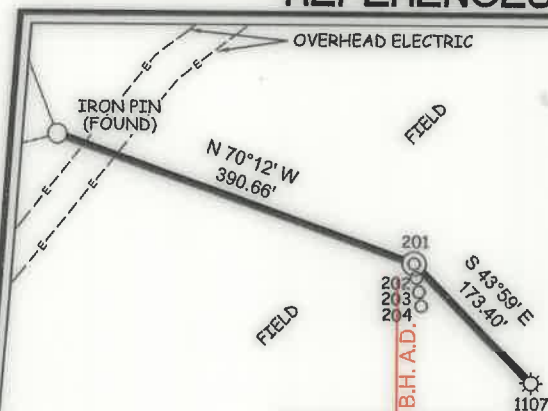**AS DRILLED COORDINATES
FOR WELL NO. 201****(S.P.C. NORTH ZONE) (UTM(M) ZONE 17)**NAD'83 S.P.C.(FT) N. 279,286.90 E. 1,723,448.56
NAD'83 GEO. LAT-(N) 39.263552 LONG-(W) 80.365497
NAD'83 UTM (M) N. 4,346,215.68 E. 554,738.58**LANDING POINT**NAD'83 S.P.C.(FT) N. 277,624.8 E. 1,723,548.0
NAD'83 GEO. LAT-(N) 39.258991 LONG-(W) 80.365089
NAD'83 UTM (M) N. 4,345,709.8 E. 554,777.3**BOTTOM HOLE**NAD'83 S.P.C.(FT) N. 259,331.8 E. 1,730,539.9
NAD'83 GEO. LAT-(N) 39.208951 LONG-(W) 80.339793
NAD'83 UTM (M) N. 4,340,172.1 E. 557,000.2**(S.P.C. NORTH ZONE) (UTM(M) ZONE 17)**NAD'83 S.P.C.(FT) N. 279,286.90 E. 1,723,448.56
NAD'83 GEO. LAT-(N) 39.263552 LONG-(W) 80.365497
NAD'83 UTM (M) N. 4,346,215.68 E. 554,738.58**LANDING POINT**NAD'83 S.P.C.(FT) N. 277,592.7 E. 1,723,558.5
NAD'83 GEO. LAT-(N) 39.258903 LONG-(W) 80.365051
NAD'83 UTM (M) N. 4,345,700.1 E. 554,780.7**BOTTOM HOLE**NAD'83 S.P.C.(FT) N. 259,342.0 E. 1,730,513.5
NAD'83 GEO. LAT-(N) 39.208978 LONG-(W) 80.339887
NAD'83 UTM (M) N. 4,340,175.1 E. 556,992.1**REFERENCES****NOTES ON SURVEY**

1. NO WATER WELLS WERE FOUND WITHIN 250' OF PROPOSED GAS WELL. NO AGRICULTURAL BUILDINGS > 2500 SQ. FT. OR DWELLINGS WERE FOUND WITHIN 625' OF THE CENTER OF PROPOSED WELL PAD.
2. WELL SPOT CIRCLE & TOPO MARK SCALE ARE 1"=2000'.
3. AS-DRILLED DATA PROVIDED BY ARSENAL RESOURCES
4. PLAT UPDATED TO SHOW AS-DRILLED PATH.

12 Vanhara Drive | P.O. Box 150 | Glenville, WV 26351 | 304.462.5634
1412 Kanawha Boulevard, East | Charleston, WV 25301 | 304.346.3952
254 East Beckley Bypass | Beckley, WV 25801 | 304.255.5296
slls.com

I THE UNDERSIGNED, HEREBY CERTIFY THAT THIS PLAT IS CORRECT TO THE BEST OF MY KNOWLEDGE AND BELIEF AND SHOWS ALL THE INFORMATION REQUIRED BY LAW AND THE REGULATIONS ISSUED AND PRESCRIBED BY THE DIVISION OF ENVIRONMENTAL PROTECTION.

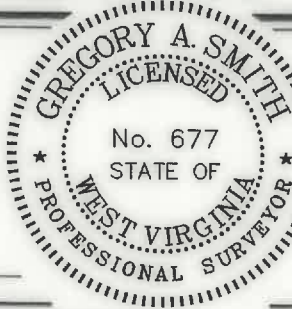P.S.
677

(+) DENOTES LOCATION OF WELL ON UNITED STATES TOPOGRAPHIC MAPS

DATE SEPTEMBER 11, 2024

REVISED JUNE 1, 2025

OPERATORS WELL NO. 201

API WELL NO. 47-033-06023
STATE COUNTY PERMIT

MINIMUM DEGREE OF ACCURACY 1 / 2500 FILE NO. 9423P201AD.dwg

HORIZONTAL & VERTICAL SCALE 1" = 2000'
CONTROL DETERMINED BY: DGPS (SURVEY GRADE TIE TO CORS NETWORK)STATE OF WEST VIRGINIA
DIVISION OF ENVIRONMENTAL PROTECTION
OFFICE OF OIL AND GAS

WELL TYPE: OIL GAS X LIQUID INJECTION WASTE DISPOSAL IF "GAS" PRODUCTION X STORAGE DEEP SHALLOW X

LOCATION:

ELEVATION 1,007.60' WATERSHED WEST FORK RIVER

DISTRICT CLARK COUNTY HARRISON

QUADRANGLE CLARKSBURG

SURFACE OWNER LAURA GOFF DAVIS

ACREAGE 161.22±

ROYALTY OWNER LAURA GOFF DAVIS, ET AL

ACREAGE 400±

PROPOSED WORK:

LEASE NO. SEE WW-6A1

DRILL X CONVERT DRILL DEEPER REDRILL FRACTURE OR STIMULATE X PLUG OFF OLD

FORMATION PERFORATE NEW FORMATION PLUG AND ABANDON CLEAN OUT AND REPLUG OTHER

PHYSICAL CHANGE IN WELL (SPECIFY) TARGET FORMATION MARCELLUS

ESTIMATED DEPTH TMD 27,290.00' / TVD 7,130.27'

WELL OPERATOR ARSENAL RESOURCES

DESIGNATED AGENT ERIC MORRIS

ADDRESS 6031 WALLACE RD. EXT. SUITE 200
WEXFORD, PA 15090ADDRESS 633 WEST MAIN STREET
BRIDGEPORT, WV 26330

COUNTY NAME

PERMIT

T.H. LATITUDE 39°17'30"
B.H. LATITUDE 39°15'00"

LGD WELL PAD
WELL NO. 201
ARSENAL RESOURCES

LEGEND


AS DRILLED ———
PROPOSED - - - - -

T.H. LONGITUDE 80°20'00"
B.H. LONGITUDE 80°20'00"

10,241' T.H. A.D.


14,951' B.H. A.D.

LINE	BEARING	DISTANCE
L1	N 70°12' W	390.66'
L2	S 66°57' E	452.43'
L3	S 20°07' W	86.23'
L4	S 06°10' W	891.23'
L5	S 19°03' E	3,940.58'

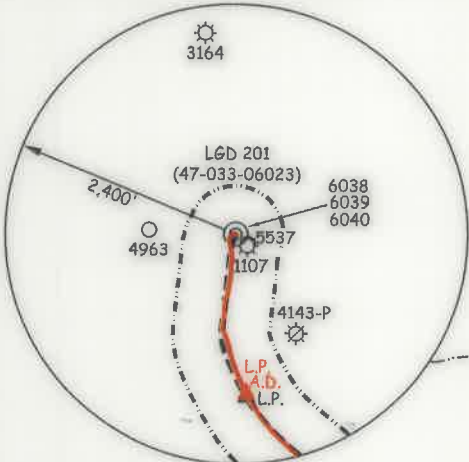

12 Venhorn Drive | P.O. Box 150 | Glenville, WV 26351 | 304.462.5634
1412 Kanawha Boulevard, East | Charleston, WV 25301 | 304.346.3952
254 East Beckley Bypass | Beckley, WV 25801 | 304.255.5295
sls.wv.com

(S.P.C. NORTH ZONE) (UTM(M) ZONE 17)
NAD'83 S.P.C.(FT) N. 279,286.90 E. 1,723,448.56
NAD'83 GEO. LAT-(N) 39.263552 LONG-(W) 80.365497
NAD'83 UTM (M) N. 4,346,215.68 E. 554,738.58
LANDING POINT
NAD'83 S.P.C.(FT) N. 277,592.7 E. 1,723,558.5
NAD'83 GEO. LAT-(N) 39.258903 LONG-(W) 80.365051
NAD'83 UTM (M) N. 4,345,700.1 E. 554,780.7
BOTTOM HOLE
NAD'83 S.P.C.(FT) N. 259,342.0 E. 1,730,513.5
NAD'83 GEO. LAT-(N) 39.208978 LONG-(W) 80.339887
NAD'83 UTM (M) N. 4,340,175.1 E. 556,992.1

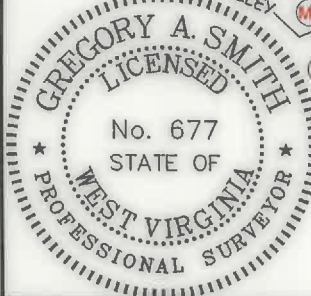

SCALE 1" = 2000' FILE NO. 9423P201AD.dwg

DATE SEPTEMBER 11, 2024
REVISED JUNE 1, 2025

OPERATORS WELL NO. 201
API WELL NO. 47 — 033 — 06023
STATE COUNTY PERMIT

STATE OF WEST VIRGINIA
DIVISION OF
ENVIRONMENTAL PROTECTION
OFFICE OF OIL AND GAS



09/19/2025

P.S. 677 Gregory A. Smith

(+) DENOTES LOCATION OF WELL ON UNITED STATES TOPOGRAPHIC MAPS

WELL OPERATOR ARSENAL RESOURCES
ADDRESS 6031 WALLACE RD. EXT. SUITE 200
WEXFORD, PA 15090

DESIGNATED AGENT ERIC MORRIS
ADDRESS 633 WEST MAIN STREET
BRIDGEPORT, WV 26330

COUNTY NAME

PERMIT

LGD WELL PAD
WELL NO. 201
ARSENAL RESOURCES



12 Vanborn Drive | P.O. Box 150 | Glenville, WV 26351 | 304.462.5634
1412 Kanawha Boulevard, East | Charleston, WV 25301 | 304.346.3952
254 East Beckley Bypass | Beckley, WV 25801 | 304.255.5296
slswv.com

TAG	PARCEL	SURFACE OWNER	ACREAGE
A	1-326-37	LAURA GOFF DAVIS	161.22
ROAD	N/A	COUNTY ROUTE 19/57-ARMORY ROAD	N/A
B	1-326-38.1	WEW REAL ESTATE HOLDING LLC	37.65
C	N/A	WEST FORK RIVER	N/A
D	1-326-102	W.V. STATE RAIL AUTHORITY	108.47
E	1-326-78	MICHAEL F & CECELIA DAUGHERTY	2.43
F	1-326-55	WILLIAM H & CHRISTY S SMITH	3.12
G	N/A	STATE OF W.V. (WESTON-FAIRMONT TURNPIKE)	N/A
H	1-326-78.11	MICKEY G PETITTO	0.38
I	1-326-78.2	ROBERT R WAGNER II	0.458
J	1-326-56	ROBERT R WAGNER II	1.22
K	1-326-78.1	HILARION V CANN ET AL	16.71
L	1-326-80	ROGER L & SANDRA CHILDERS	28.36
M	1-346-36	LESTER G ANDERSON JR	25.4
ROAD	N/A	COUNTY ROUTE 25/17- RED DOG ROAD	N/A
N	1-346-35	HILARION V CANN ET AL	40.942
O	1-346-63	HILARION V CANN ET AL	35.11
P	1-347-29	KURT SKASIK	60.8
Q	1-346-85	MARK A SKASIK	14.17
R	1-347-30	KURT SKASIK	16.76
S	12-347-31	W VA DNR	91.747
T	12-347-41	ROBERT CLUTTER	19.66
U	12-347-41.2	SHARON LOUISE CAIN (LE)	2.35
V	12-347-41.6	TOMMY FORNASH	47.71
W	12-347-65.4	TOMMY D & FORNASH ET AL	4.57
X	12-347-41.7	CRYSTAL CROPP	1.52
ROAD	N/A	COUNTY ROUTE 25/10-MT CLARE & NORWOOD RD.	N/A
Y	12-367-4	CLIFTON RAWLINGS	9
Z	12-367-6	HOWARD LEE SPARKS JR	9
A1	12-367-33	GDS WV HOLDINGS LLC	22.92
B1	12-367-34.1	LISA FLOWERS ET AL	18.04
ROAD	N/A	MOORE ST OF A.A. KNIGHT LOTS	N/A
C1	12-2008-11	LISA FLOWERS & GARY STUTLER	LOT 10
ROAD	N/A	MILES ST OF A.A. KNIGHT LOTS	N/A
D1	12-2008-19	DEBRA ANN MCCUTCHEON	LOT 3
ROAD	N/A	CO. RT. 25/35-KNIGHT ST OF A.A. KNIGHT LOTS	N/A
E1	12-2008-30	DEBRA ANN MCCUTCHEON	1.82
F1	12-367-40	BRIAN D & MELISSA D GALLOWAY	22.28
G1	12-367-84	ROBERT H CORK	4.95
ROAD	N/A	COUNTY ROUTE 25/4-CHUBB RUN RD.	N/A
H1	12-367-53	JOSHUA I DEAN	3
I1	12-2010-61	PATRICK CUNNINGHAM DBA	0.7
J1	12-367-69	GEORGE STEPHEN ROGERS	4.12
K1	12-367-69.1	GEORGE STEPHEN ROGERS	6.98
L1	12-387-4.1	MICHAEL GLENN HARDMAN	4.62
M1	12-387-4	TIMMY LEE SEARCEY	2.26
ROAD	N/A	10' ALLEY HOLDEN ADDITION OF MT CLARE	N/A
N1	12-2012-16	GUY & VERNIE RUSSELL ESTATE	LOT 9
O1	12-2012-13	JO ANN HILEMAN	LOTS 10-12
ROAD	N/A	HARP ROAD 927	N/A
P1	12-2012-35	AMANDA RAE SNIDER	LOT 23
Q1	12-2012-34	NAJ LLC	LOT 24
R1	12-2012-33	EARL PATRICK FRAZIER JR	LOT 25
S1	12-2012-32	EARL PATRICK FRAZIER JR	LOT 26
T1	12-2012-31	EARL PATRICK FRAZIER JR	LOT 27
U1	12-2012-29	EARL PATRICK FRAZIER JR	LOT 19
V1	12-2012-30	EARL PATRICK FRAZIER JR	LOT 18
ROAD	N/A	20' ALLEY HOLDEN ADD. OF MT CLARE(CHERRY HILL ROAD)	N/A
W1	12-2012-20	KRISTINA MARIE CHRISTIAN	0.26
X1	12-387-6	ALTA MARIE SKIDMORE ET AL	1.26
Y1	12-387-7	CHARLES S MILLER	4.84
Z1	12-387-22	RONALD H ROGERS	49.74

FILE NO. 9423P201AD.dwg

DATE SEPTEMBER 11, 2024

REVISED JUNE 1, 2025

OPERATORS WELL NO. 201

API WELL NO. 47 — 051 — 06023

STATE COUNTY PERMIT



STATE OF WEST VIRGINIA
DIVISION OF ENVIRONMENTAL PROTECTION
OFFICE OF OIL AND GAS

09/19/2025

P.S. 677 Gregory A. Smith

WELL OPERATOR ARSENAL RESOURCES

DESIGNATED AGENT ERIC MORRIS

ADDRESS 6031 WALLACE RD. EXT. SUITE 200

ADDRESS 633 WEST MAIN STREET

WEXFORD, PA 15090

BRIDGEPORT, WV 26330