

LGD WELL PAD WELL NO. 203 ARSENAL RESOURCES

T.H. LATITUDE 39°17'30"
B.H. LATITUDE 39°15'00"

CURVE	RADIUS	ARC LENGTH	CHORD LENGTH	CHORD BEARING
C1	1330.08'	186.88'	186.72'	N 68°20' E
C2	214.73'	180.35'	175.10'	S 88°20' E
C3	544.76'	255.87'	253.52'	S 51°25' E
C4	1249.43'	448.09'	445.69'	S 28°43' E

NOTES ON SURVEY

1. NO WATER WELLS WERE FOUND WITHIN 250' OF PROPOSED GAS WELL. NO AGRICULTURAL BUILDINGS > 2500 SQ. FT. OR DWELLINGS WERE FOUND WITHIN 625' OF THE CENTER OF PROPOSED WELL PAD.
2. WELL SPOT CIRCLE & TOPO MARK SCALE ARE 1"=2000'.
3. AS-DRILLED DATA PROVIDED BY ARSENAL RESOURCES
4. PLAT UPDATED TO SHOW AS-DRILLED PATH.

LINE	BEARING	DISTANCE
L1	N 79°55' E	151.98'
L2	N 65°18' E	1878.34'
L3	S 19°02' E	20037.37'
L4	N 66°30' W	406.19'
L5	S 70°16' E	437.02'

(S.P.C. NORTH ZONE) (UTM(M) ZONE 17)			
NAD'83 S.P.C.(FT)	N. 279,257.32	E. 1,723,453.52	
NAD'83 GEO.	LAT-(N) 39.263471	LONG-(W) 80.365478	
NAD'83 UTM (M)	N. 4,346,206.69	E. 554,740.24	
LANDING POINT			
NAD'83 S.P.C.(FT)	N. 279,583.7	E. 1,726,070.5	
NAD'83 GEO.	LAT-(N) 39.264436	LONG-(W) 80.356247	
NAD'83 UTM (M)	N. 4,346,319.4	E. 555,535.9	
BOTTOM HOLE			
NAD'83 S.P.C.(FT)	N. 260,641.4	E. 1,732,603.8	
NAD'83 GEO.	LAT-(N) 39.212599	LONG-(W) 80.332553	
NAD'83 UTM (M)	N. 4,340,581.6	E. 557,622.3	

AS DRILLED COORDINATES FOR WELL NO. 203

(S.P.C. NORTH ZONE) (UTM(M) ZONE 17)			
NAD'83 S.P.C.(FT)	N. 279,257.32	E. 1,723,453.52	
NAD'83 GEO.	LAT-(N) 39.263471	LONG-(W) 80.365478	
NAD'83 UTM (M)	N. 4,346,206.69	E. 554,740.24	
LANDING POINT			
NAD'83 S.P.C.(FT)	N. 279,573.5	E. 1,726,067.1	
NAD'83 GEO.	LAT-(N) 39.264407	LONG-(W) 80.356258	
NAD'83 UTM (M)	N. 4,346,316.3	E. 555,534.9	
BOTTOM HOLE			
NAD'83 S.P.C.(FT)	N. 260,585.5	E. 1,732,601.6	
NAD'83 GEO.	LAT-(N) 39.212448	LONG-(W) 80.332559	
NAD'83 UTM (M)	N. 4,340,584.5	E. 557,621.9	

RECEIVED
Office of Oil and Gas


JUL 23 2025

WV Department of
Environmental Protection



12 Vanhorn Drive | P.O. Box 150 | Glenville, WV 26351 | 304.462.5634
1412 Kanawha Boulevard, East | Charleston, WV 25301 | 304.346.3952
254 East Beckley Bypass | Beckley, WV 25801 | 304.255.5296
sls.wv.com


REFERENCES

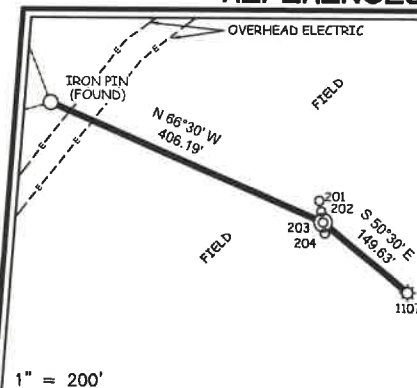

I THE UNDERSIGNED, HEREBY CERTIFY THAT THIS PLAT IS CORRECT TO THE BEST OF MY KNOWLEDGE AND BELIEF AND SHOWS ALL THE INFORMATION REQUIRED BY LAW AND THE REGULATIONS ISSUED AND PRESCRIBED BY THE DIVISION OF ENVIRONMENTAL PROTECTION.

P.S.
677

Gregory A. Smith

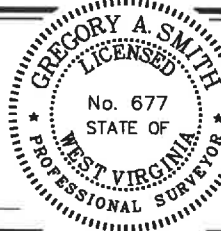

(+) DENOTES LOCATION OF WELL ON UNITED STATES TOPOGRAPHIC MAPS

DATE MAY 20, 20 24

REVISED JUNE 1, 20 25

OPERATORS WELL NO. 203

API WELL NO. 47 — 033 — 06038
STATE COUNTY PERMIT

MINIMUM DEGREE OF ACCURACY 1 / 2500 FILE NO. 9423P203AD.dwg
HORIZONTAL & VERTICAL SCALE 1" = 2000'
CONTROL DETERMINED BY: DGPS (SURVEY GRADE TIE TO CORS NETWORK)

STATE OF WEST VIRGINIA
DIVISION OF ENVIRONMENTAL PROTECTION
OFFICE OF OIL AND GAS



WELL TYPE: OIL GAS ☒ LIQUID INJECTION ☐ WASTE DISPOSAL ☐ IF "GAS" PRODUCTION ☒ STORAGE ☐ DEEP ☐ SHALLOW ☒

LOCATION:

ELEVATION 1,007.60' WATERSHED WEST FORK RIVER

DISTRICT CLARK COUNTY HARRISON QUADRANGLE CLARKSBURG

SURFACE OWNER LAURA GOFF DAVIS ACREAGE 161.22±

ROYALTY OWNER LAURA GOFF DAVIS, ET AL ACREAGE 400±

PROPOSED WORK: LEASE NO. SEE WW-6A1

DRILL ☒ CONVERT ☐ DRILL DEEPER ☐ REDRILL ☐ FRACTURE OR STIMULATE ☒ PLUG OFF OLD

FORMATION PERFORATE NEW FORMATION ☐ PLUG AND ABANDON ☐ CLEAN OUT AND REPLUG ☐ OTHER ☐

PHYSICAL CHANGE IN WELL (SPECIFY) TARGET FORMATION MARCELLUS

ESTIMATED DEPTH TMD 28,210.00' / TVD 7,120.99'

WELL OPERATOR ARSENAL RESOURCES

DESIGNATED AGENT ERIC MORRIS

ADDRESS 6031 WALLACE RD. EXT. SUITE 200
WEXFORD, PA 15090


ADDRESS 633 WEST MAIN STREET
BRIDGEPORT, WV 26330

09/19/2025

RECEIVED
Office of Oil and Gas

JUL 23 2025

WV Department of
Environmental Protection


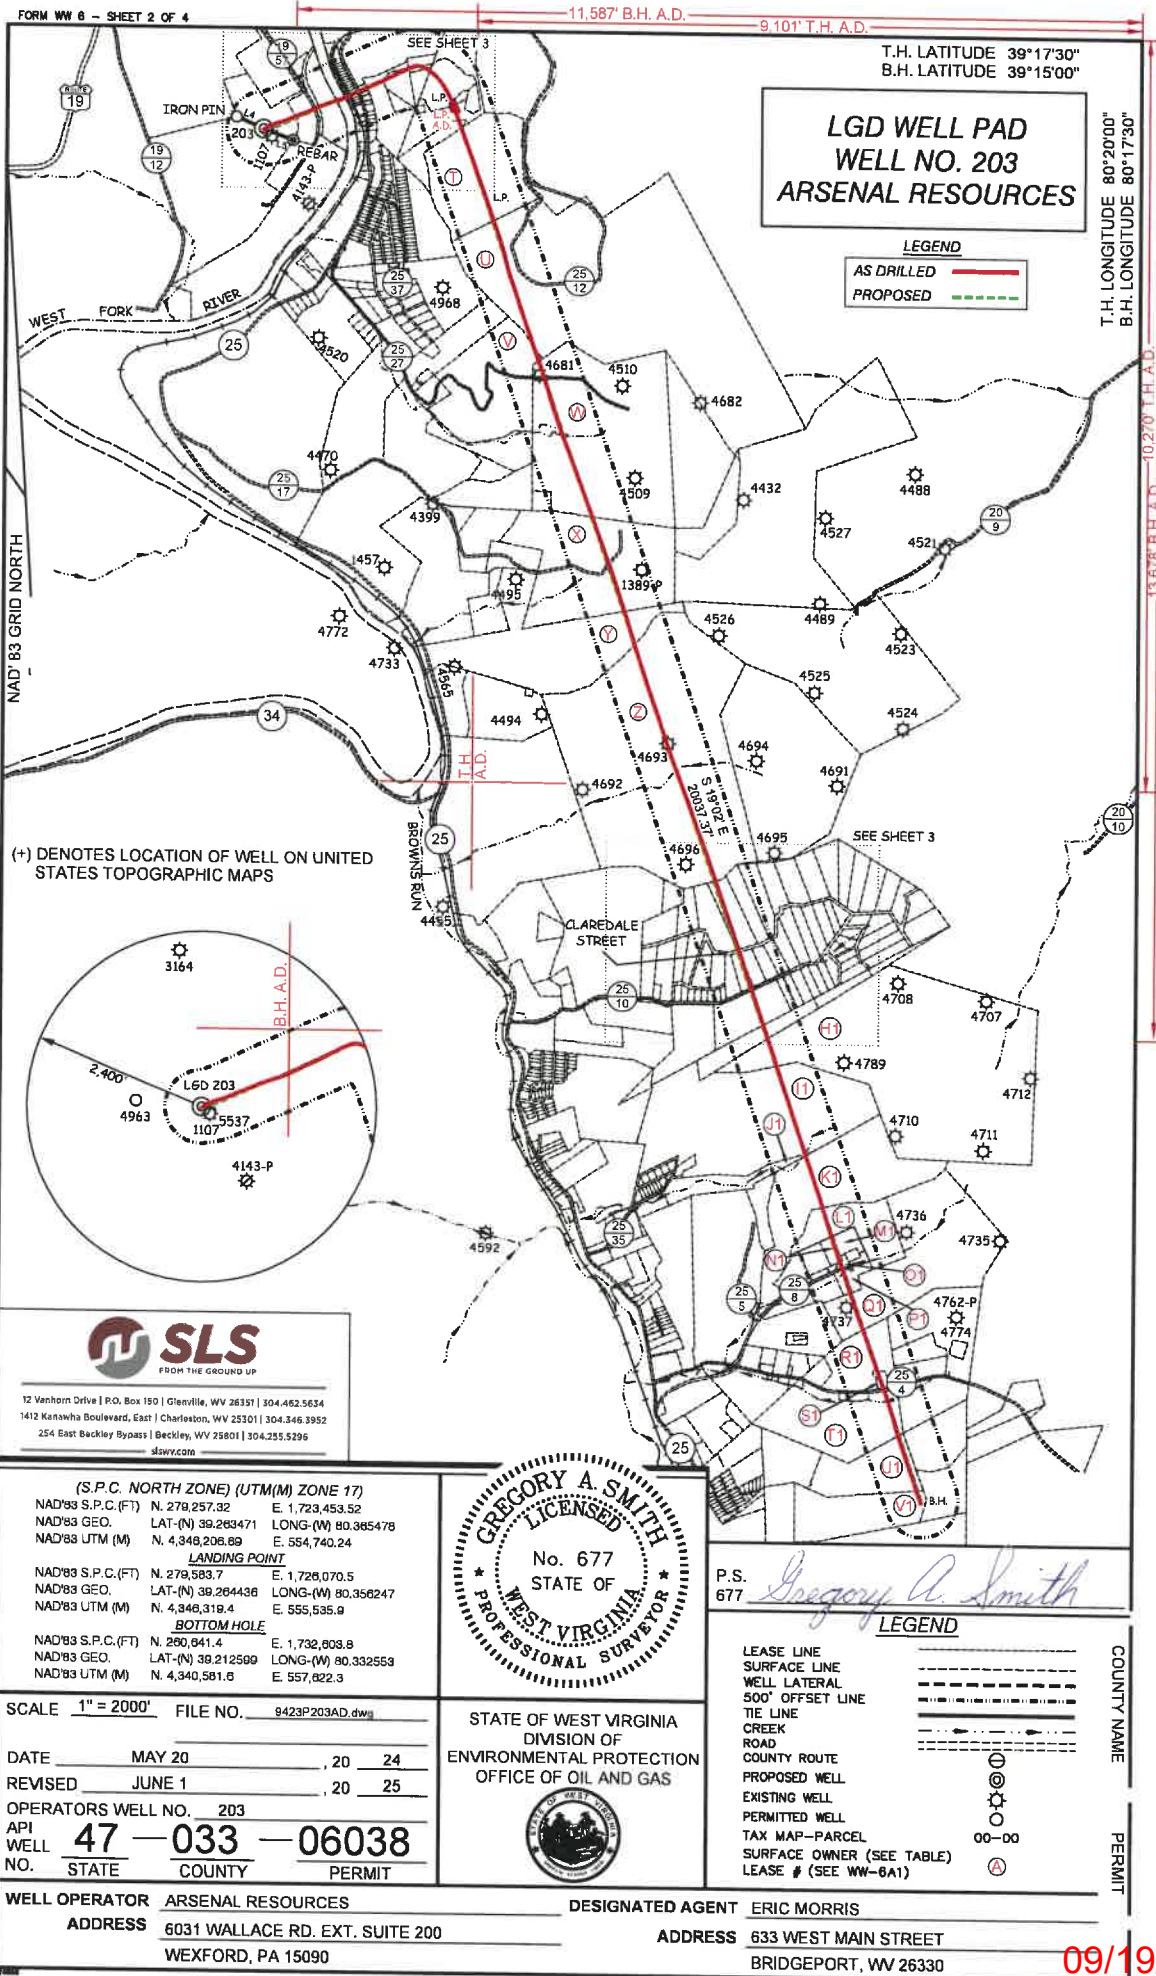


09/19/2025

**LGD WELL PAD
WELL NO. 203
ARSENAL RESOURCES**



12 Vanhorn Drive | P.O. Box 150 | Glenville, WV 26351 | 304.462.5634
1412 Kanawha Boulevard, East | Charleston, WV 25301 | 304.346.3952
254 East Beckley Bypass | Beckley, WV 25801 | 304.255.5296
slowv.com

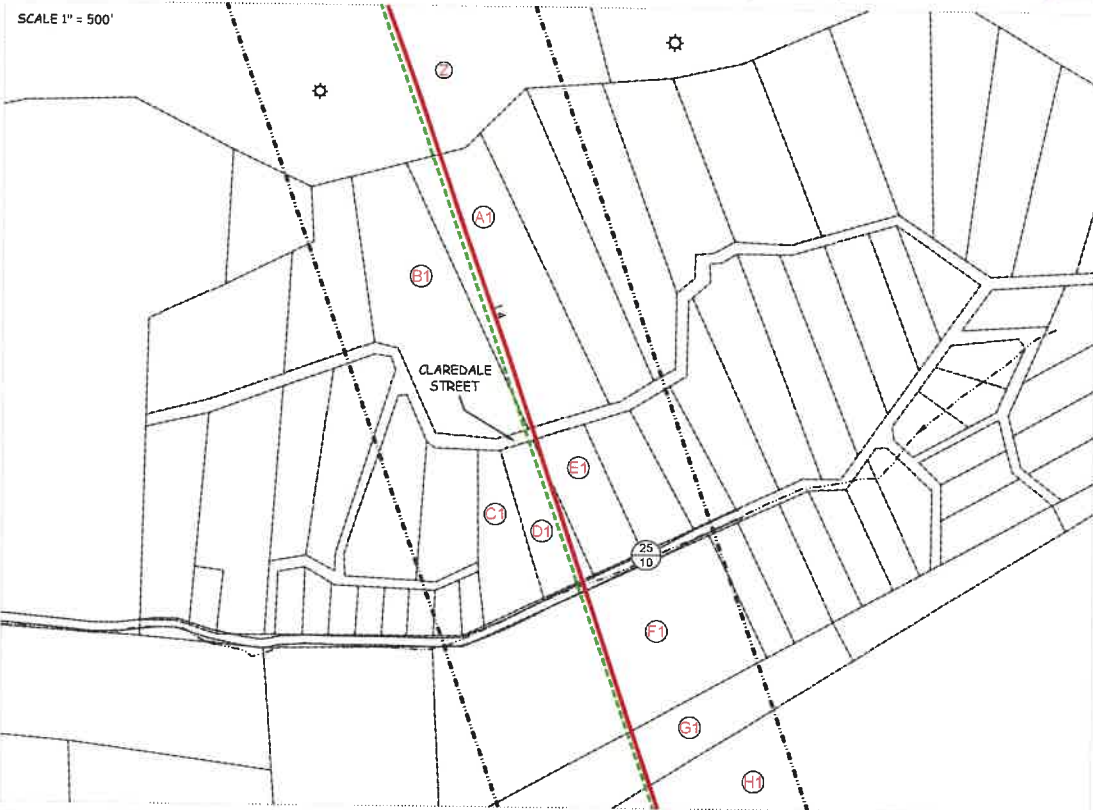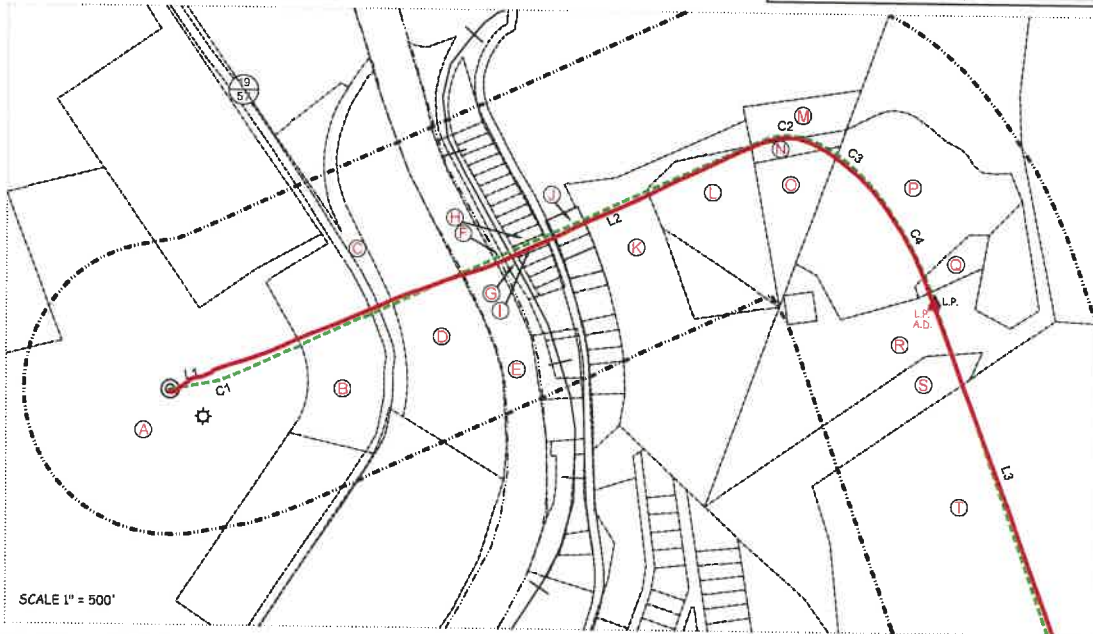


FILE NO. 9423P203AD.dwg

DATE MAY 20, 2024

REVISED JUNE 1, 2025

OPERATORS WELL NO. 203

API WELL NO. 47 — 033 — 06038
STATE COUNTY PERMIT

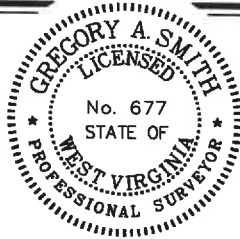

STATE OF WEST VIRGINIA
DIVISION OF
ENVIRONMENTAL PROTECTION
OFFICE OF OIL AND GAS



P.S. 677

Gregory A. Smith

WELL OPERATOR ARSENAL RESOURCES
ADDRESS 6031 WALLACE RD. EXT. SUITE 200
WEXFORD, PA 15090

DESIGNATED AGENT ERIC MORRIS
ADDRESS 633 WEST MAIN STREET
BRIDGEPORT, WV 26330

COUNTY NAME

PERMIT

09/19/2025

RECEIVED
Office of Oil and Gas

JUL 23 2025

WV Department of
Environmental Protection

**LGD WELL PAD
WELL NO. 203
ARSENAL RESOURCES**



12 Vanhorn Drive | P.O. Box 150 | Glenville, WV 26351 | 304.462.5634
1412 Kanawha Boulevard, East | Charleston, WV 25301 | 304.346.3952
254 East Beckley Bypass | Beckley, WV 25801 | 304.255.5296
slsvv.com

TAG	PARCEL	SURFACE OWNER/ROAD/RIVER	ACREAGE
A	1-326-37	LAURA GOFF DAVIS	161.22
B	1-326-37.3	SHAFFER ENTERPRISES INC	3.82
ROAD	N/A	COUNTY ROUTE 19/57-ARMORY ROAD	N/A
C	1-326-85	GENERAL CORPORATION	1.45
D	1-326-38	GENERAL CORPORATION	8.21
E	N/A	WEST FORK RIVER	N/A
F	1-115-14	MINNIE REED WHALEY	LOT 1
G	1-326-102	W.V. STATE RAIL AUTHORITY	108.47
H	1-115-20	MICHAEL W & PAMELA J HARRIS	LOT 11
I	1-115-22	PAMELA J HARRIS	LOT 12
ROAD	N/A	COUNTY ROUTE 25-WESTON FAIRMONT TURNPIKE	N/A
J	1-115-21	MICHAEL W & PAMELA J HARRIS	LOT 100 X 120
K	1-326-84.2	CHARLES & DEBRA MCCLUNG	9.3
L	1-326-43.3	MICHAEL J & MARTA L HODGE	3.07
M	1-326-43.6	LISA D & JASON B MENENDEZ	1.11
N	1-326-43.5	LISA D MENENDEZ ET AL	0.43
O	1-326-43.2	LISA D MENENDEZ ET AL	1.69
P	1-326-44.5	AMY MACCOLEMAN	7.88
Q	1-326-44.14	JOHNNA LEE POST & T SCOTT AUSTIN	0.547
R	1-326-44	WVTD LLC	11.58
S	1-326-44.7	MARK A & HAZEL L CARDER	5.63
T	1-327-12	GENESIS YOUTH CRISIS INC.	40.4
U	3-326-26	HARRISON COUNTY BOARD OF EDUCATION	185.84
V	1-326-82	DIANA LYNN BARNETT	40
W	1-347-5	MICHAEL E & MELISSA L WHITE	94.4
ROAD	N/A	COUNTY ROUTE 25/27- DOLL RUN ROAD	N/A
X	1-347-4	MARK A SKASIK	62.42
Y	1-347-29	KURT SKASIK	60.8
Z	12-347-32	WV DNR	245.15
A1	12-347-44	MICHAEL W & MARY M BALL	LOT 46
B1	12-347-43	I F MAXWELL	LOT 47
C1	12-347-81	MICHAEL W & MARY M BALL	LOT 66
ROAD	N/A	STREET IN CLAREDALE SUBDIVISION	N/A
D1	12-347-82	MICHAEL W & MARY M BALL	LOT 67
E1	12-347-83	MICHAEL W & MARY M BALL	LOT 68
ROAD	N/A	COUNTY ROUTE 25/10-MT CLARE & NORWOOD RD.	N/A
F1	12-367-8	GEORGE E BENYA	12
G1	12-367-9	MICHAEL W & MARY M BALL	10.46
H1	1-367-37	WV DNR	160
I1	12-367-36.1	PERRY H ALLEN ETAL	79
J1	12-367-35	DEBRA MCCUTCHEON	9.64
K1	12-367-43	KENNETH W MONEYPENNY	51.415
L1	12-367-46	DEBORAH CUNNINGHAM ET AL	17.39
M1	12-2013-4	CHARLES LEE FRYE	2.51
N1	12-2013-3	ROBERT LEE FRYE ET AL	1.48
O1	12-2013-6	PERRY & DONNA JENKINS	LOT P/O 6,7,1,2,
ROAD	N/A	COUNTY ROUTE 25/8-FLORENCE HOLLOW RD.	N/A
P1	12-2013-10.1	DONNA JENKINS ETAL	2.53
Q1	12-367-55.1	MARK S & MARCIE G BRAGG	56.81
R1	12-367-55.2	TIMBER CREST DEVELOPMENT LLC	14.89
S1	12-367-55.4	TIMBER CREST DEVELOPMENT LLC	0.91
ROAD	N/A	COUNTY ROUTE 25/4-CHUBB RUN RD.	N/A
T1	12-367-55	RUDY D LARRY & RONALD D LARRY	36.76
U1	12-387-10	RONALD H ROGERS	19.36
V1	12-387-11	RONALD H ROGERS	22.83

RECEIVED
Office of Oil and Gas

JUL 23 2025

WV Department of
Environmental Protection


FILE NO. 9423P203AD.dwg

DATE MAY 20 , 20 24

REVISED JUNE 1 , 20 25

OPERATORS WELL NO. 203

API WELL NO. 47 — 033 — 06038
STATE COUNTY PERMIT

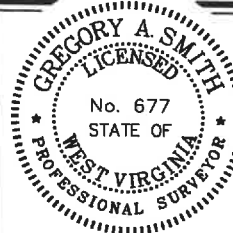

STATE OF WEST VIRGINIA
DIVISION OF
ENVIRONMENTAL PROTECTION
OFFICE OF OIL AND GAS



P.S.
677

Gregory A. Smith

WELL OPERATOR ARSENAL RESOURCES
ADDRESS 6031 WALLACE RD. EXT. SUITE 200
WEXFORD, PA 15090

DESIGNATED AGENT ERIC MORRIS
ADDRESS 633 WEST MAIN STREET
BRIDGEPORT, WV 26330

COUNTY NAME

PERMIT

09/19/2025

**LGD WELL PAD
WELL NO. 203
ARSENAL RESOURCES**T.H. LATITUDE 39°17'30"
B.H. LATITUDE 39°15'00"**NOTES ON SURVEY**

1. NO WATER WELLS WERE FOUND WITHIN 250' OF PROPOSED GAS WELL. NO AGRICULTURAL BUILDINGS > 2500 SQ. FT. OR DWELLINGS WERE FOUND WITHIN 625' OF THE CENTER OF PROPOSED WELL PAD.
2. WELL SPOT CIRCLE & TOPO MARK SCALE ARE 1"=2000'.
3. AS-DRILLED DATA PROVIDED BY ARSENAL RESOURCES
4. PLAT UPDATED TO SHOW AS-DRILLED PATH.

CURVE	RADIUS	ARC LENGTH	CHORD LENGTH	CHORD BEARING
C1	1330.08'	186.88'	186.72'	N 68°20' E
C2	214.73'	180.35'	175.10'	S 88°20' E
C3	544.76'	255.87'	253.52'	S 51°25' E
C4	1249.43'	448.09'	445.69'	S 28°43' E

T.H. LONGITUDE 80°20'00"
B.H. LONGITUDE 80°17'30"


LINE	BEARING	DISTANCE
L1	N 79°55' E	151.98'
L2	N 65°18' E	1878.34'
L3	S 19°02' E	20037.37'
L4	N 66°30' W	406.19'
L5	S 70°16' E	437.02'

**AS DRILLED COORDINATES
FOR WELL NO. 203**


(S.P.C. NORTH ZONE) (UTM(M) ZONE 17)

NAD'83 S.P.C.(FT)	N. 279,257.32	E. 1,723,453.52
NAD'83 GEO.	LAT-(N) 39.263471	LONG-(W) 80.365478
NAD'83 UTM (M)	N. 4,346,206.69	E. 554,740.24
LANDING POINT		
NAD'83 S.P.C.(FT)	N. 279,573.5	E. 1,726,067.1
NAD'83 GEO.	LAT-(N) 39.264407	LONG-(W) 80.356258
NAD'83 UTM (M)	N. 4,346,316.3	E. 555,534.9
BOTTOM HOLE		
NAD'83 S.P.C.(FT)	N. 260,585.5	E. 1,732,601.6
NAD'83 GEO.	LAT-(N) 39.212446	LONG-(W) 80.332559
NAD'83 UTM (M)	N. 4,340,564.5	E. 557,621.9

(S.P.C. NORTH ZONE) (UTM(M) ZONE 17)		
NAD'83 S.P.C.(FT)	N. 279,257.32	E. 1,723,453.52
NAD'83 GEO.	LAT-(N) 39.263471	LONG-(W) 80.365478
NAD'83 UTM (M)	N. 4,346,206.69	E. 554,740.24
LANDING POINT		
NAD'83 S.P.C.(FT)	N. 279,583.7	E. 1,726,070.5
NAD'83 GEO.	LAT-(N) 39.264436	LONG-(W) 80.356247
NAD'83 UTM (M)	N. 4,346,319.4	E. 555,535.9
BOTTOM HOLE		
NAD'83 S.P.C.(FT)	N. 260,641.4	E. 1,732,603.8
NAD'83 GEO.	LAT-(N) 39.212599	LONG-(W) 80.332553
NAD'83 UTM (M)	N. 4,340,581.6	E. 557,622.3

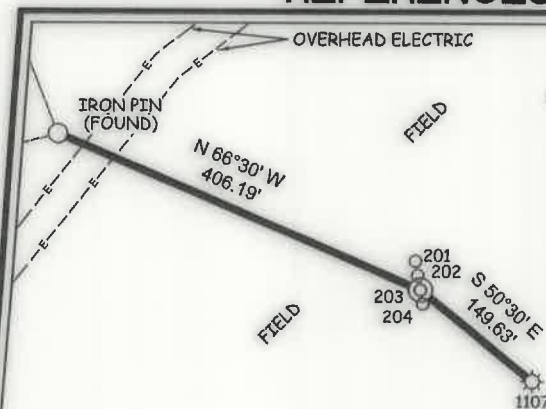REFERENCES12 Vanhorn Drive | P.O. Box 150 | Glenville, WV 26351 | 304.462.8034
1412 Kanawha Boulevard, East | Charleston, WV 25301 | 304.346.3952
254 East Beckley Bypass | Beckley, WV 25801 | 304.255.5296
slswv.com

I THE UNDERSIGNED, HEREBY CERTIFY THAT THIS PLAT IS CORRECT TO THE BEST OF MY KNOWLEDGE AND BELIEF AND SHOWS ALL THE INFORMATION REQUIRED BY LAW AND THE REGULATIONS ISSUED AND PRESCRIBED BY THE DIVISION OF ENVIRONMENTAL PROTECTION.

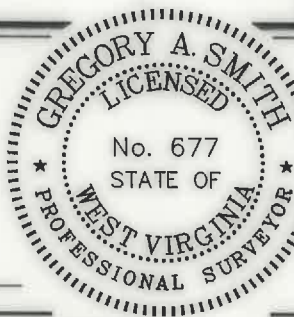P.S.
677

(+) DENOTES LOCATION OF WELL ON UNITED STATES TOPOGRAPHIC MAPS

DATE MAY 20, 20 24

REVISED JUNE 1, 20 25

OPERATORS WELL NO. 203

API WELL NO. 47 - 033 - 06038
STATE COUNTY PERMIT

MINIMUM DEGREE OF ACCURACY 1 / 2500 FILE NO. 9423P203AD.dwg

HORIZONTAL & VERTICAL SCALE 1" = 2000'
CONTROL DETERMINED BY: DGPS (SURVEY GRADE TIE TO CORS NETWORK)STATE OF WEST VIRGINIA
DIVISION OF ENVIRONMENTAL PROTECTION
OFFICE OF OIL AND GASWELL TYPE: OIL _____ LIQUID GAS ☒ INJECTION _____ WASTE DISPOSAL _____ IF "GAS" PRODUCTION ☒ STORAGE _____ DEEP _____ SHALLOW ☒**LOCATION:**

ELEVATION 1,007.60' WATERSHED WEST FORK RIVER

DISTRICT CLARK COUNTY HARRISON QUADRANGLE CLARKSBURG

SURFACE OWNER LAURA GOFF DAVIS

ACREAGE 161.22±

ROYALTY OWNER LAURA GOFF DAVIS, ET AL

ACREAGE 400±

PROPOSED WORK:

LEASE NO. SEE WW-6A1

DRILL ☒ CONVERT _____ DRILL DEEPER _____ REDRILL _____ FRACTURE OR STIMULATE ☒ PLUG OFF OLD FORMATION _____ PERFORATE NEW FORMATION _____ PLUG AND ABANDON _____ CLEAN OUT AND REPLUG _____ OTHER _____

PHYSICAL CHANGE IN WELL (SPECIFY) _____ TARGET FORMATION MARCELLUS

ESTIMATED DEPTH TMD 28,210.00' / TVD 7,120.99'

WELL OPERATOR ARSENAL RESOURCES
ADDRESS 6031 WALLACE RD. EXT. SUITE 200
WEXFORD, PA 15090DESIGNATED AGENT ERIC MORRIS
ADDRESS 633 WEST MAIN STREET
BRIDGEPORT, WV 26330

COUNTY NAME


PERMIT

LGD WELL PAD
WELL NO. 203
ARSENAL RESOURCES

LEGEND

AS DRILLED
PROPOSED

(+) DENOTES LOCATION OF WELL ON UNITED STATES TOPOGRAPHIC MAPS

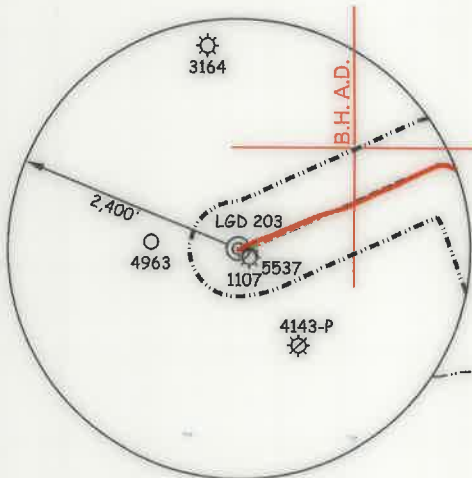

12 Vanhorn Drive | P.O. Box 150 | Glenville, WV 26351 | 304.462.5634
1412 Kanawha Boulevard, East | Charleston, WV 25301 | 304.346.3952
254 East Beckley Bypass | Beckley, WV 25801 | 304.295.5296

(S.P.C. NORTH ZONE) (UTM(M) ZONE 17)

NAD'83 S.P.C.(FT) N. 279,257.32 E. 1,723,453.52
NAD'83 GEO. LAT-(N) 39.263471 LONG-(W) 80.365478
NAD'83 UTM (M) N. 4,346,206.69 E. 554,740.24

LANDING POINT

NAD'83 S.P.C.(FT) N. 279,583.7 E. 1,726,070.5
NAD'83 GEO. LAT-(N) 39.264436 LONG-(W) 80.356247
NAD'83 UTM (M) N. 4,346,319.4 E. 555,535.9

BOTTOM HOLE


NAD'83 S.P.C.(FT) N. 260,641.4 E. 1,732,603.8
NAD'83 GEO. LAT-(N) 39.212599 LONG-(W) 80.332553
NAD'83 UTM (M) N. 4,340,581.6 E. 557,622.3

SCALE 1" = 2000' FILE NO. 9423P203AD.dwg

DATE MAY 20, 2024
REVISED JUNE 1, 2025

OPERATORS WELL NO. 203
API WELL NO. 47-033-06038
STATE COUNTY PERMIT

WELL OPERATOR ARSENAL RESOURCES
ADDRESS 6031 WALLACE RD. EXT. SUITE 200
WEXFORD, PA 15090

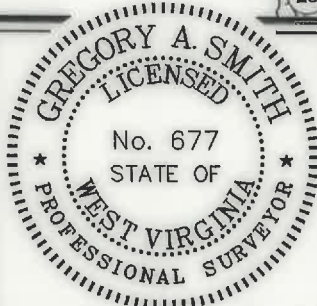

STATE OF WEST VIRGINIA
DIVISION OF
ENVIRONMENTAL PROTECTION
OFFICE OF OIL AND GAS



P.S.
677

Gregory A. Smith

LEGEND

LEASE LINE
SURFACE LINE
WELL LATERAL
500' OFFSET LINE
TIE LINE
CREEK
ROAD
COUNTY ROUTE
PROPOSED WELL
EXISTING WELL
PERMITTED WELL
TAX MAP-PARCEL
SURFACE OWNER (SEE TABLE)
LEASE # (SEE WW-6A1)

09/19/2025

COUNTY NAME

PERMIT



DESIGNATED AGENT ERIC MORRIS

ADDRESS 633 WEST MAIN STREET
BRIDGEPORT, WV 26330

LGD WELL PAD
WELL NO. 203
ARSENAL RESOURCES



12 Vanhorn Drive | P.O. Box 150 | Glenville, WV 26351 | 304.462.5634
1412 Kanawha Boulevard, East | Charleston, WV 25301 | 304.346.3952
254 East Beckley Bypass | Beckley, WV 25801 | 304.255.5296
slewv.com

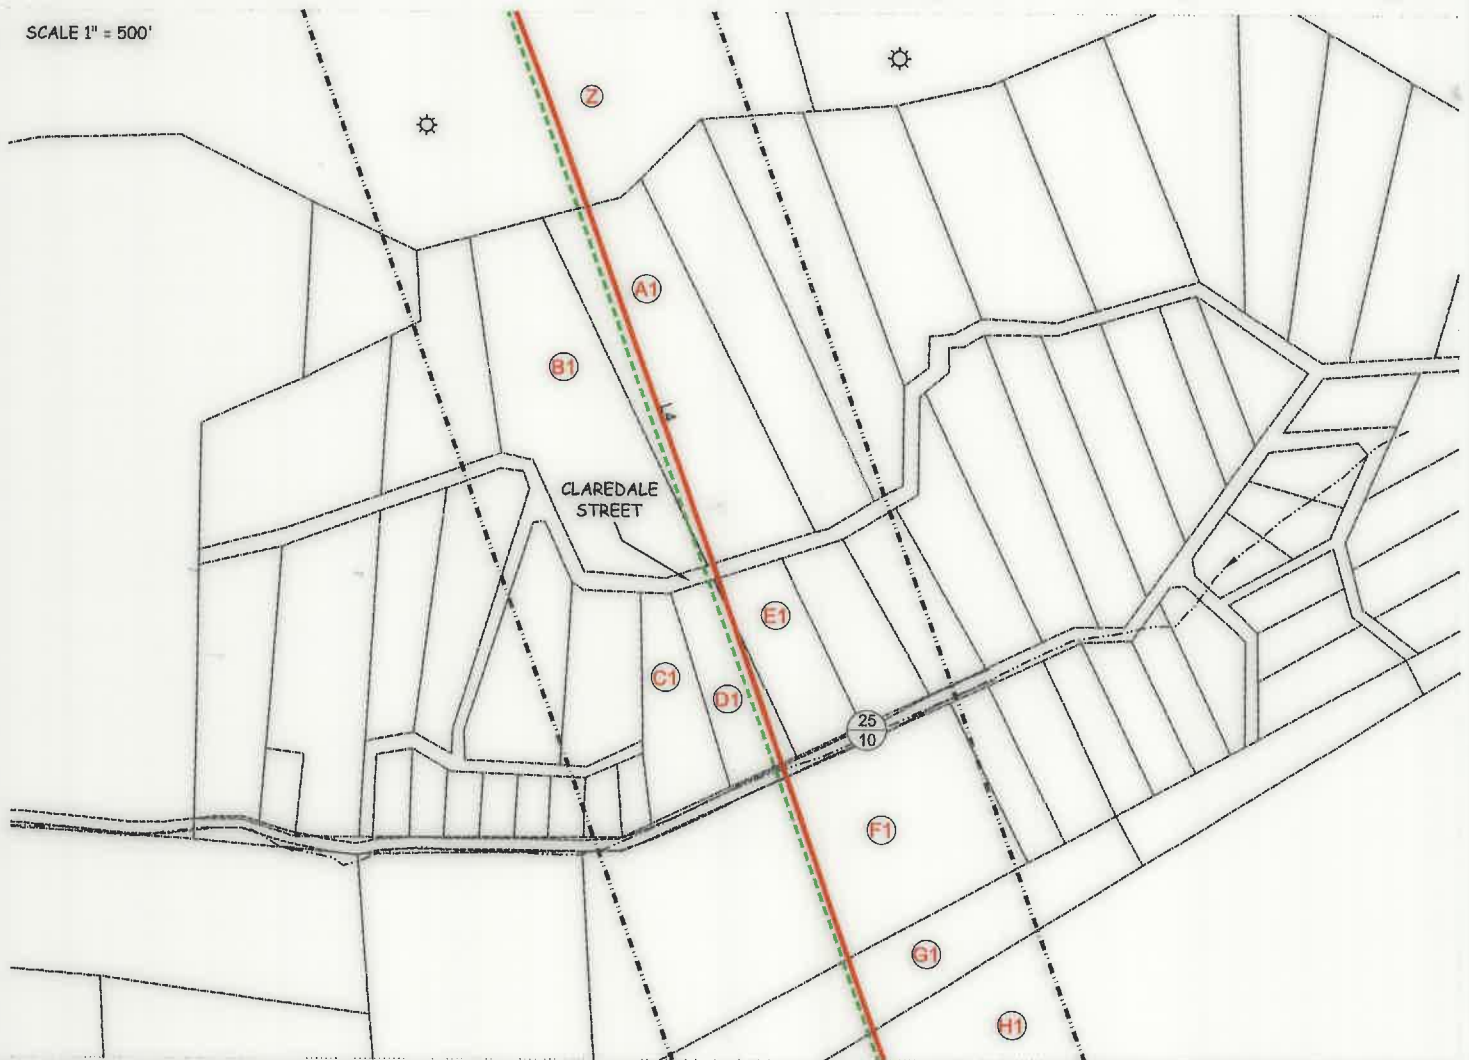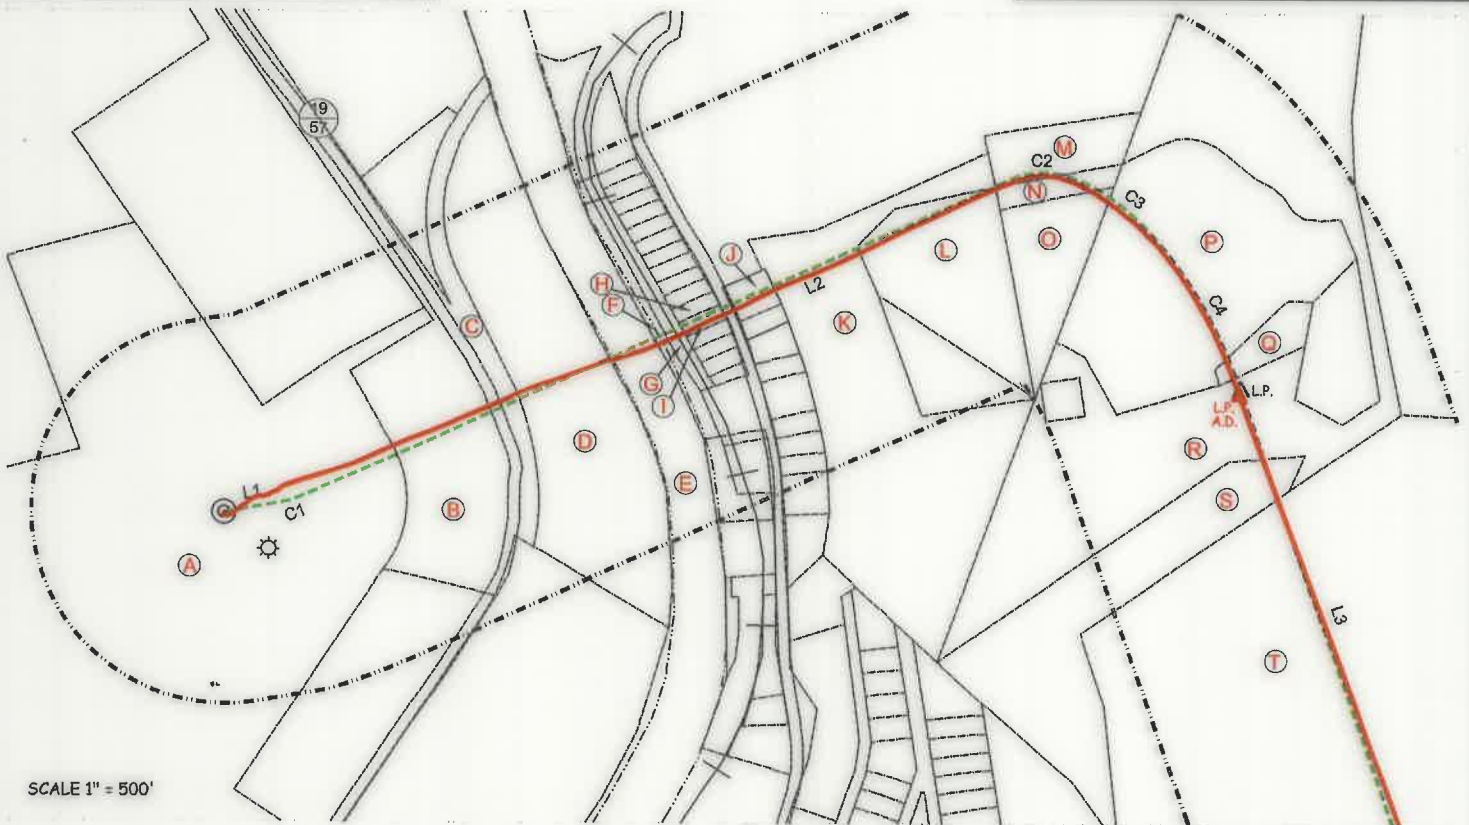

FILE NO. 9423P203AD.dwg

DATE MAY 20, 2024

REVISED JUNE 1, 2025

OPERATORS WELL NO. 203

API WELL NO. 47 — 033 — 06038
STATE COUNTY PERMIT



STATE OF WEST VIRGINIA
DIVISION OF ENVIRONMENTAL PROTECTION
OFFICE OF OIL AND GAS



P.S. 677

Gregory A. Smith

WELL OPERATOR ARSENAL RESOURCES
ADDRESS 6031 WALLACE RD. EXT. SUITE 200
WEXFORD, PA 15090

DESIGNATED AGENT ERIC MORRIS
ADDRESS 633 WEST MAIN STREET
BRIDGEPORT, WV 26330

COUNTY NAME

PERMIT

LGD WELL PAD
WELL NO. 203
ARSENAL RESOURCES



12 Vanhorn Drive | P.O. Box 150 | Glenville, WV 26351 | 304.462.5634
1412 Kanawha Boulevard, East | Charleston, WV 25301 | 304.346.3952
254 East Beckley Bypass | Beckley, WV 25801 | 304.265.5296
slewv.com

TAG	PARCEL	SURFACE OWNER/ROAD/RIVER	ACREAGE
A	1-326-37	LAURA GOFF DAVIS	161.22
B	1-326-37.3	SHAFFER ENTERPRISES INC	3.82
ROAD	N/A	COUNTY ROUTE 19/57-ARMORY ROAD	N/A
C	1-326-85	GENERAL CORPORATION	1.45
D	1-326-38	GENERAL CORPORATION	8.21
E	N/A	WEST FORK RIVER	N/A
F	1-115-14	MINNIE REED WHALEY	LOT 1
G	1-326-102	W.V. STATE RAIL AUTHORITY	108.47
H	1-115-20	MICHAEL W & PAMELA J HARRIS	LOT 11
I	1-115-22	PAMELA J HARRIS	LOT 12
ROAD	N/A	COUNTY ROUTE 25-WESTON FAIRMONT TURNPIKE	N/A
J	1-115-21	MICHAEL W & PAMELA J HARRIS	LOT 100 X 120
K	1-326-84.2	CHARLES & DEBRA MCCLUNG	9.3
L	1-326-43.3	MICHAEL J & MARTA L HODGE	3.07
M	1-326-43.6	LISA D & JASON B MENENDEZ	1.11
N	1-326-43.5	LISA D MENENDEZ ET AL	0.43
O	1-326-43.2	LISA D MENENDEZ ET AL	1.69
P	1-326-44.5	AMY MACCOLEMAN	7.88
Q	1-326-44.14	JOHNNA LEE POST & T SCOTT AUSTIN	0.547
R	1-326-44	WVTD LLC	11.58
S	1-326-44.7	MARK A & HAZEL L CARDER	5.63
T	1-327-12	GENESIS YOUTH CRISIS INC.	40.4
U	3-326-26	HARRISON COUNTY BOARD OF EDUCATION	185.84
V	1-326-82	DIANA LYNN BARNETT	40
W	1-347-5	MICHAEL E & MELISSA L WHITE	94.4
ROAD	N/A	COUNTY ROUTE 25/27- DOLL RUN ROAD	N/A
X	1-347-4	MARK A SKASIK	62.42
Y	1-347-29	KURT SKASIK	60.8
Z	12-347-32	WV DNR	245.15
A1	12-347-44	MICHAEL W & MARY M BALL	LOT 46
B1	12-347-43	I F MAXWELL	LOT 47
C1	12-347-81	MICHAEL W & MARY M BALL	LOT 66
ROAD	N/A	STREET IN CLAREDALE SUBDIVISION	N/A
D1	12-347-82	MICHAEL W & MARY M BALL	LOT 67
E1	12-347-83	MICHAEL W & MARY M BALL	LOT 68
ROAD	N/A	COUNTY ROUTE 25/10-MT CLARE & NORWOOD RD.	N/A
F1	12-367-8	GEORGE E BENYA	12
G1	12-367-9	MICHAEL W & MARY M BALL	10.46
H1	1-367-37	WV DNR	160
I1	12-367-36.1	PERRY H ALLEN ETAL	79
J1	12-367-35	DEBRA MCCUTCHEON	9.64
K1	12-367-43	KENNETH W MONEYPENNY	51.415
L1	12-367-46	DEBORAH CUNNINGHAM ET AL	17.39
M1	12-2013-4	CHARLES LEE FRYE	2.51
N1	12-2013-3	ROBERT LEE FRYE ET AL	1.48
O1	12-2013-6	PERRY & DONNA JENKINS	LOT P/O 6,7,1,2,
ROAD	N/A	COUNTY ROUTE 25/8-FLORENCE HOLLOW RD.	N/A
P1	12-2013-10.1	DONNA JENKINS ETAL	2.53
Q1	12-367-55.1	MARK S & MARCIE G BRAGG	56.81
R1	12-367-55.2	TIMBER CREST DEVELOPMENT LLC	14.89
S1	12-367-55.4	TIMBER CREST DEVELOPMENT LLC	0.91
ROAD	N/A	COUNTY ROUTE 25/4-CHUBB RUN RD.	N/A
T1	12-367-55	RUDY D LARRY & RONALD D LARRY	36.76
U1	12-387-10	RONALD H ROGERS	19.36
V1	12-387-11	RONALD H ROGERS	22.83

FILE NO. 9423P203AD.dwg


DATE MAY 20, 2024

REVISED JUNE 1, 2025

OPERATORS WELL NO. 203

API WELL NO. 47 — 033 — 06038

STATE COUNTY PERMIT

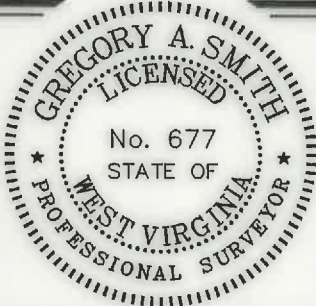

STATE OF WEST VIRGINIA
DIVISION OF ENVIRONMENTAL PROTECTION
OFFICE OF OIL AND GAS



P.S. 677

Gregory A. Smith

WELL OPERATOR ARSENAL RESOURCES
ADDRESS 6031 WALLACE RD. EXT. SUITE 200
WEXFORD, PA 15090

DESIGNATED AGENT ERIC MORRIS
ADDRESS 633 WEST MAIN STREET
BRIDGEPORT, WV 26330

COUNTY NAME

PERMIT