

LGD WELL PAD WELL NO. 202 ARSENAL RESOURCES

T.H. LATITUDE 39°17'30"
B.H. LATITUDE 39°15'00"

CURVE	RADIUS	ARC LENGTH	CHORD LENGTH	CHORD BEARING
C1	367.89'	86.99'	86.78'	N 75°09' E
C2	73.13'	110.70'	100.43'	S 60°53' E
C3	22787.48'	1274.69'	1274.52'	S 20°10' E

NOTES ON SURVEY

1. NO WATER WELLS WERE FOUND WITHIN 250' OF PROPOSED GAS WELL. NO AGRICULTURAL BUILDINGS > 2500 SQ. FT. OR DWELLINGS WERE FOUND WITHIN 825' OF THE CENTER OF PROPOSED WELL PAD.
2. WELL SPOT CIRCLE & TOPO MARK SCALE ARE 1"=2000'.
3. AS-DRILLED DATA PROVIDED BY ARSENAL RESOURCES.
4. PLAT UPDATED TO SHOW AS-DRILLED PATH.

(S.P.C. NORTH ZONE) (UTM(M) ZONE 17)			
NAD'83 S.P.C.(FT)	N. 279,272.11	E. 1,723,451.04	
NAD'83 GEO.	LAT-(N) 39.263511	LONG-(W) 80.365487	
NAD'83 UTM (M)	N. 4,348,211.19	E. 554,739.41	
LANDING POINT			
NAD'83 S.P.C.(FT)	N. 278,870.9	E. 1,725,047.5	
NAD'83 GEO.	LAT-(N) 39.262452	LONG-(W) 80.359836	
NAD'83 UTM (M)	N. 4,348,097.0	E. 555,227.8	
BOTTOM HOLE			
NAD'83 S.P.C.(FT)	N. 259,885.3	E. 1,731,671.5	
NAD'83 GEO.	LAT-(N) 39.209900	LONG-(W) 80.335811	
NAD'83 UTM (M)	N. 4,340,279.5	E. 557,343.3	

LINE	BEARING	DISTANCE
L1	N 50°02' E	90.49'
L2	N 80°00' E	1167.14'
L3	S 17°22' E	324.52'
L4	S 18°32' E	343.64'
L5	N 68°19' W	398.22'
L6	S 68°35' E	444.54'

AS DRILLED COORDINATES FOR WELL NO. 202

(S.P.C. NORTH ZONE) (UTM(M) ZONE 17)			
NAD'83 S.P.C.(FT)	N. 279,272.11	E. 1,723,451.04	
NAD'83 GEO.	LAT-(N) 39.263511	LONG-(W) 80.365487	
NAD'83 UTM (M)	N. 4,348,211.19	E. 554,739.41	
LANDING POINT			
NAD'83 S.P.C.(FT)	N. 278,788.2	E. 1,725,098.8	
NAD'83 GEO.	LAT-(N) 39.262171	LONG-(W) 80.359659	
NAD'83 UTM (M)	N. 4,348,066.0	E. 555,243.3	
BOTTOM HOLE			
NAD'83 S.P.C.(FT)	N. 259,670.5	E. 1,731,676.7	
NAD'83 GEO.	LAT-(N) 39.209911	LONG-(W) 80.335793	
NAD'83 UTM (M)	N. 4,340,281.2	E. 557,344.8	

LEGEND	
LEASE LINE	---
SURFACE LINE	---
WELL LATERAL	---
500' OFFSET LINE	---
TIE LINE	---
CREEK	---
ROAD	---
COUNTY ROUTE	---
PROPOSED WELL	⊙
EXISTING WELL	⊙
PERMITTED WELL	⊙
TAX MAP--PARCEL	00-00
SURFACE OWNER (SEE TABLE)	---
LEASE # (SEE WW-6A1)	---




12 Vanborn Drive | P.O. Box 150 | Glenview, WV 26351 | 304.462.5634
1412 Kanawha Boulevard, East | Charleston, WV 25301 | 304.348.3952
254 East Beckley Bypass | Beckley, WV 25801 | 304.255.5296
slls.com

RECEIVED
Office of Oil and Gas

JUL 23 2025


WV Department of
Environmental Protection

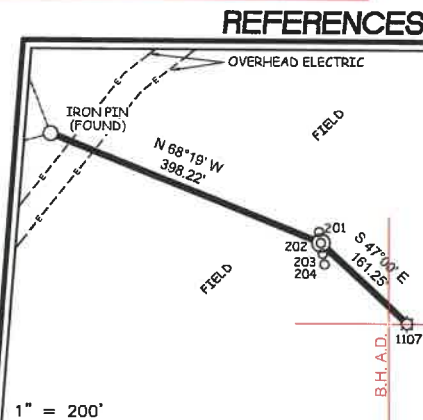

I THE UNDERSIGNED, HEREBY CERTIFY THAT THIS PLAT IS CORRECT TO THE BEST OF MY KNOWLEDGE AND BELIEF AND SHOWS ALL THE INFORMATION REQUIRED BY LAW AND THE REGULATIONS ISSUED AND PRESCRIBED BY THE DIVISION OF ENVIRONMENTAL PROTECTION.

P.S.
677

Gregory A. Smith

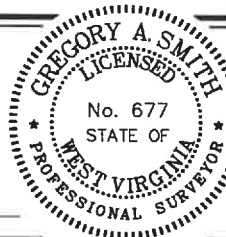

(+) DENOTES LOCATION OF WELL ON UNITED STATES TOPOGRAPHIC MAPS

DATE SEPTEMBER 11, 20 24

REVISED JUNE 1, 20 25

OPERATORS WELL NO. 202

API WELL NO. 47-033-06039

STATE COUNTY PERMIT

MINIMUM DEGREE OF ACCURACY 1/2500 FILE NO. 9423P202AD.dwg

HORIZONTAL & VERTICAL SCALE 1" = 2000'
CONTROL DETERMINED BY: DGPS (SURVEY GRADE TIE TO CORS NETWORK)

STATE OF WEST VIRGINIA
DIVISION OF ENVIRONMENTAL PROTECTION
OFFICE OF OIL AND GAS



WELL TYPE: OIL ☐ GAS ☒ LIQUID WASTE IF "GAS" PRODUCTION ☒ STORAGE ☐ DEEP ☐ SHALLOW ☒

LOCATION: ELEVATION 1,007.60' WATERSHED WEST FORK RIVER

DISTRICT CLARK COUNTY HARRISON QUADRANGLE CLARKSBURG

SURFACE OWNER LAURA GOFF DAVIS ACREAGE 161.22±

ROYALTY OWNER LAURA GOFF DAVIS, ET AL ACREAGE 400±

PROPOSED WORK: LEASE NO. SEE WW-6A1

DRILL ☒ CONVERT ☐ DRILL DEEPER ☐ REDRILL ☐ FRACTURE OR STIMULATE ☒ PLUG OFF OLD

FORMATION ☐ PERFORATE NEW FORMATION ☐ PLUG AND ABANDON ☐ CLEAN OUT AND REPLUG ☐ OTHER ☐

PHYSICAL CHANGE IN WELL (SPECIFY) TARGET FORMATION MARCELLUS

ESTIMATED DEPTH TMD 28,045.00' / TVD 7,127.58'

WELL OPERATOR ARSENAL RESOURCES DESIGNATED AGENT ERIC MORRIS

ADDRESS 6031 WALLACE RD. EXT. SUITE 200 ADDRESS 633 WEST MAIN STREET

WEXFORD, PA 15090 BRIDGEPORT, WV 26330

09/19/2025

RECEIVED
Office of Oil and Gas
JUL 23 2025
WV Department of
Environmental Protection

FORM WW 6 - SHEET 2 OF 5

9,104' T.H. A.D. 697' B.H. A.D.

T.H. LATITUDE 39°17'30"
B.H. LATITUDE 39°15'00"

LGD WELL PAD
WELL NO. 202
ARSENAL RESOURCES

LEGEND
AS DRILLED
PROPOSED

T.H. LONGITUDE 80°05'00"
B.H. LONGITUDE 80°05'00"

14,602' B.H. A.D. 10,225' T.H. A.D.

Map showing well pad location, roads, and survey points. Includes a detailed inset of the well pad area.

12 Vanhorn Drive | P.O. Box 150 | Glenville, WV 26331 | 304.462.5634
1412 Kanawha Boulevard, East | Charleston, WV 25301 | 304.346.3952
254 East Beckley Bypass | Beckley, WV 25801 | 304.255.5296
slswv.com

(S.P.C. NORTH ZONE) (UTM(M) ZONE 17)

NAD'83 S.P.C. (F.T)	N. 279,272.11	E. 1,723,451.04
NAD'83 GEO.	LAT-(N) 39.263511	LONG-(W) 80.395467
NAD'83 UTM (M)	N. 4,346,211.19	E. 554,730.41

LANDING POINT

NAD'83 S.P.C. (F.T)	N. 278,870.9	E. 1,725,047.5
NAD'83 GEO.	LAT-(N) 39.262452	LONG-(W) 80.359836
NAD'83 UTM (M)	N. 4,346,067.0	E. 555,227.8

BOTTOM HOLE

NAD'83 S.P.C. (F.T)	N. 259,885.3	E. 1,731,671.5
NAD'83 GEO.	LAT-(N) 39.209800	LONG-(W) 80.335811
NAD'83 UTM (M)	N. 4,340,279.5	E. 557,343.3

SCALE 1" = 2000' FILE NO. 9423P202AD.dwg

DATE SEPTEMBER 11, 2024
REVISED JUNE 1, 2025

OPERATORS WELL NO. 202
API WELL NO. 47-033-06039
STATE COUNTY PERMIT

STATE OF WEST VIRGINIA
DIVISION OF
ENVIRONMENTAL PROTECTION
OFFICE OF OIL AND GAS

WELL OPERATOR ARSENAL RESOURCES
ADDRESS 6031 WALLACE RD. EXT. SUITE 200
WEXFORD, PA 15090

DESIGNATED AGENT ERIC MORRIS
ADDRESS 633 WEST MAIN STREET
BRIDGEPORT, WV 26330

COUNTY NAME

PERMIT

P.S. 677 Gregory A. Smith


(+) DENOTES LOCATION OF WELL ON UNITED STATES TOPOGRAPHIC MAPS

09/19/2025

**LGD WELL PAD
WELL NO. 202
ARSENAL RESOURCES**



12 Vanhorn Drive | P.O. Box 150 | Glenville, WV 26351 | 304.462.5634
1412 Kanawha Boulevard, East | Charleston, WV 25301 | 304.346.5952
254 East Beckley Bypass | Beckley, WV 25801 | 304.255.5296
slswv.com

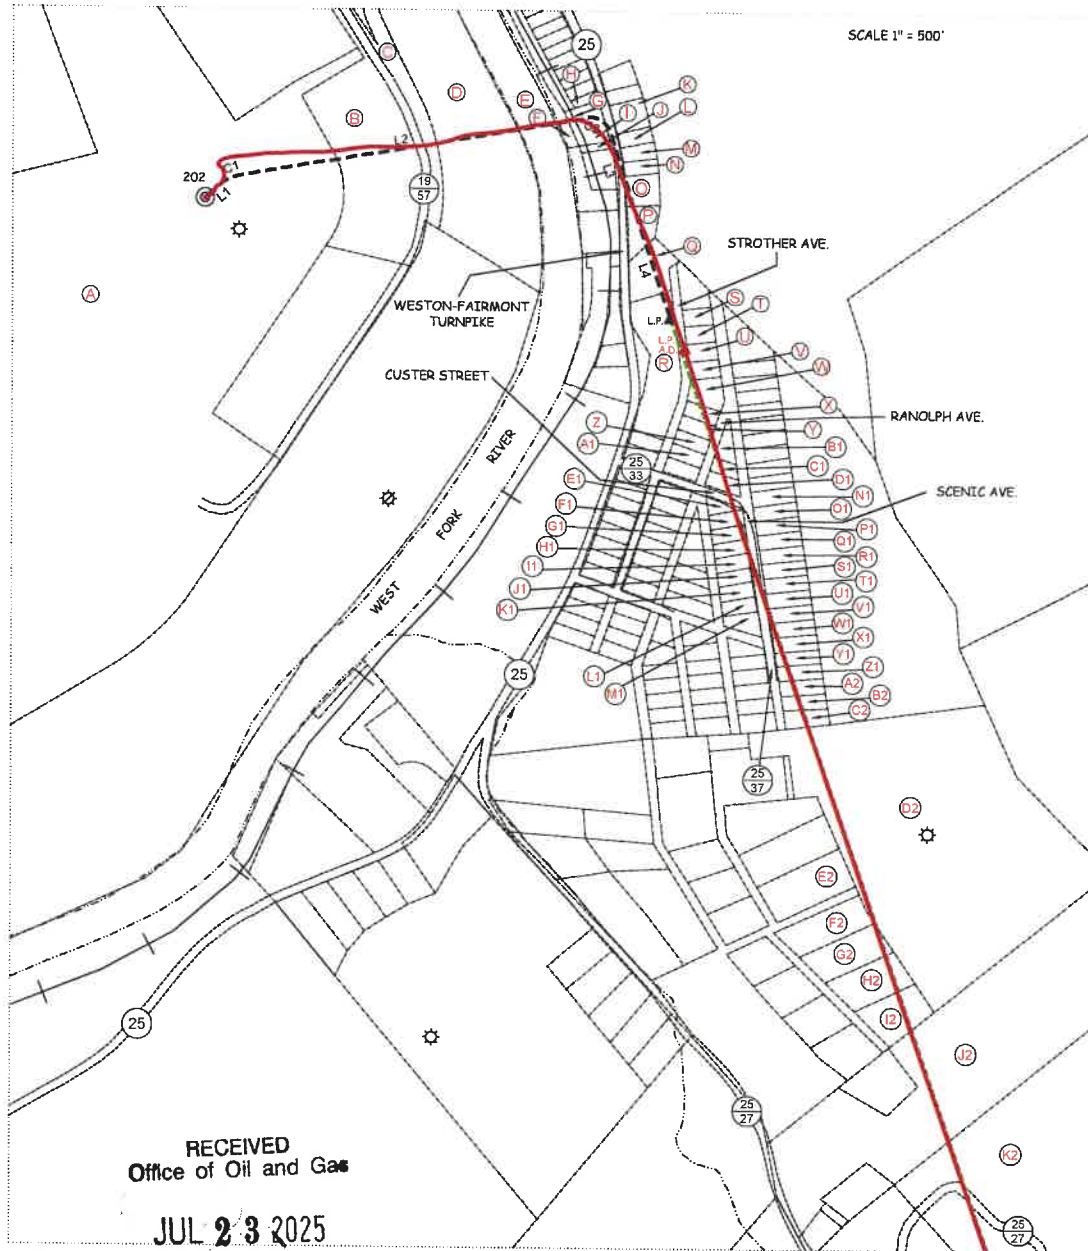


RECEIVED
Office of Oil and Gas

JUL 23 2025

WV Department of
Environmental Protection

FILE NO. 9423P202AD.dwg
DATE SEPTEMBER 11, 2024
REVISED JUNE 1, 2025
OPERATORS WELL NO. 202
API WELL NO. 47 — 033 — 06039
STATE COUNTY PERMIT

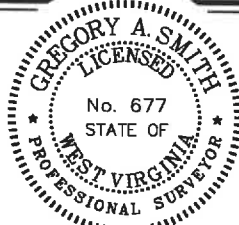

STATE OF WEST VIRGINIA
DIVISION OF
ENVIRONMENTAL PROTECTION
OFFICE OF OIL AND GAS



P.S.
677

Gregory A. Smith

WELL OPERATOR ARSENAL RESOURCES
ADDRESS 6031 WALLACE RD. EXT. SUITE 200
WEXFORD, PA 15090

DESIGNATED AGENT ERIC MORRIS
ADDRESS 633 WEST MAIN STREET
BRIDGEPORT, WV 26330

COUNTY NAME

PERMIT

09/19/2025

**LGD WELL PAD
WELL NO. 202
ARSENAL RESOURCES**



12 Vanhorn Drive | P.O. Box 150 | Glenville, WV 26351 | 304.462.5634
1412 Kanawha Boulevard, East | Charleston, WV 25301 | 304.546.3952
254 East Beckley Bypass | Beckley, WV 25801 | 304.255.5296
slsvv.com

TAG	PARCEL	SURFACE OWNER/ROAD/RIVER	ACREAGE
A	1-326-37	LAURA GOFF DAVIS	161.22
B	1-326-37.3	SHAFFER ENTERPRISES INC	3.82
ROAD	N/A	COUNTY ROUTE 19/57-ARMORY ROAD	N/A
C	1-326-85	GENERAL CORPORATION	1.45
D	1-326-38	GENERAL CORPORATION	8.21
E	N/A	WEST FORK RIVER	N/A
F	1-115-14	MINNIE REED WHALEY	LOT
G	1-326-102	W.V. STATE RAIL AUTHORITY	108.47
H	1-115-26	RICHARD A & EDITH M BENNETT	LOTS 14,15,16
I	1-115-38	BARBARA BLAKE ET AL	LOT
J	1-115-29	BARBARA BLAKE ET AL	LOT
ROAD	N/A	COUNTY ROUTE 25-WESTON FAIRMONT TURNPIKE	N/A
K	1-115-30	RICHARD A & EDITH M BENNETT	LOT 100 X 120
L	1-115-32	BMJ LIVING TRUST	LOT 50 X 100
M	115-33	RICHARD A BENNETT	LOT 50 X 120
N	115-35	RICHARD A BENNETT	LOT 50 X 120
O	1-115-36	RICHARD A & EDITH M BENNETT	LOT
P	1-115-36.1	JUDITH ANN BEVERLIN	LOT (0.69 AC)
Q	1-109-1	JUDITH ANN BEVERLIN	LOTS 1-3
R	1-109-7	TIMOTHY C & MARTHA WAGNER	LOTS 4-12
ROAD	N/A	STROTHER AVE.	N/A
S	1-109-8	ROBIN E MCSHANE ET AL	LOT 49
T	1-109-10	ROBIN E MCSHANE ET AL	LOT 48
U	1-109-12	ROBIN E MCSHANE ET AL	LOT 47
V	1-109-15	ROBIN E MCSHANE ET AL	LOT 46
W	1-109-18	ROBIN E MCSHANE ET AL	LOT 45
X	1-109-21	ROBIN E MCSHANE ET AL	LOT 44
Y	1-109-24	ROBIN E MCSHANE ET AL	LOT 43
ROAD	N/A	RANDOLPH AVE.	N/A
Z	1-109-27	ROBIN E MCSHANE ET AL	LOT 42
A1	1-109-31	SARRA N MARTIN	LOT 41
B1	1-109-28	ROBIN E MCSHANE ET AL	LOT 69
C1	1-109-33	ROBIN E MCSHANE ET AL	LOT 70
D1	1-109-34	ROBIN E MCSHANE ET AL	LOT 71
ROAD	N/A	CUSTER STREET-COUNTY ROUTE 25/37	N/A
E1	1-109-41	ROBIN E MCSHANE ET AL	LOT 72
F1	1-109-45	ROBIN E MCSHANE ET AL	LOT 73
G1	1-109-49	ROBIN E MCSHANE ET AL	LOT 74
H1	1-109-53	ROBIN E MCSHANE ET AL	LOT 75
I1	1-109-58	ROBIN E MCSHANE ET AL	LOT 76
ROAD	N/A	SCENIC AVE. -COUNTY ROUTE 25/37	N/A
J1	1-109-63	ROBIN E MCSHANE ET AL	LOT 77
K1	1-109-68	ROBIN E MCSHANE ET AL	LOT 78
L1	1-109-73	ROBIN E MCSHANE ET AL	LOT 79
M1	1-109-74	DAVID J BARNETT JR	LOT 80
N1	1-109-42	ROBIN E MCSHANE ET AL	LOT 102
O1	1-109-46	ROBIN E MCSHANE ET AL	LOT 101
P1	1-109-50	ROBIN E MCSHANE ET AL	LOT 100
Q1	1-109-54	MICHAEL & LORI LEMASTERS	LOT 99
R1	1-109-59	MICHAEL & LORI LEMASTERS	LOT 98
S1	1-109-64	MICHAEL & LORI LEMASTERS	LOT 97
T1	1-109-69	SANDRA MORRIS ETAL	LOT 96
U1	1-109-75	ROBERT ERIC SUMMERFIELD ET AL	LOT 95
V1	1-109-76	ROBERT ERIC SUMMERFIELD ET AL	LOT 94
W1	1-109-77	LUCINDA MCGINNIS (LE)	LOT 93
X1	1-109-85	LUCINDA MCGINNIS (LE)	LOT 92

RECEIVED
Office of Oil and Gas

JUL 23 2025

WV Department of
Environmental Protection


FILE NO. 9423P202AD.dwg

DATE SEPTEMBER 11, 20 24

REVISED JUNE 1, 20 25

OPERATORS WELL NO. 202

API WELL NO. 47 — 033 — 06039
STATE COUNTY PERMIT

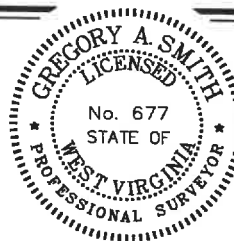

STATE OF WEST VIRGINIA
DIVISION OF
ENVIRONMENTAL PROTECTION
OFFICE OF OIL AND GAS



P.S.
677

Gregory A. Smith

COUNTY NAME

PERMIT

WELL OPERATOR ARSENAL RESOURCES
ADDRESS 6031 WALLACE RD. EXT. SUITE 200
WEXFORD, PA 15090

DESIGNATED AGENT ERIC MORRIS
ADDRESS 633 WEST MAIN STREET
BRIDGEPORT, WV 26330

09/19/2025

**LGD WELL PAD
WELL NO. 202
ARSENAL RESOURCES**



12 Vanhorn Drive | P.O. Box 150 | Glenville, WV 26351 | 304.462.5634
1412 Kanawha Boulevard, East | Charleston, WV 25301 | 304.346.3952
254 East Beckley Bypass | Beckley, WV 25801 | 304.255.5296
slsvw.com

Y1	1-109-95	LUCINDA MCGINNIS (LE)	LOT 91
Z1	1-109-100	MICHAEL & LORI LEMASTERS	LOT 90
A2	1-109-105	MICHAEL & LORI LEMASTERS	LOT 89
B2	1-109-114	MICHAEL & LORI LEMASTERS	LOT 88
C2	1-109-115	MICHAEL & LORI LEMASTERS	LOT 87
D2	1-326-79.2	ROBERT SCOTT WAGNER ET AL	14.67
E2	1-117-19	SCOTT L & TERESA R BIGELOW ET AL	0.99
ROAD	N/A	POPLAR AVE.	N/A
F2	1-117-24	JAMES & RHONDA LYON ET AL	0.73
G2	1-117-25	SCOTT L HENSLEY	0.74
H2	1-117-26	SCOTT L HENSLEY	0.75
I2	1-117-27	SCOTT L HENSLEY	0.73
J2	1-326-81.1	ROBERT SCOTT WAGNER ET AL	11.75
ROAD	N/A	COUNTY ROUTE 25/27-DOLL RUN ROAD	N/A
K2	1-326-82	DIANA LYNN BARNETT	L2+A17:D73
L2	1-347-1.2	ANGELA R ANDERSON	9.32
M2	1-347-1	LESTER G ANDERSON JR	2.4
N2	1-347-1.1	MICHAEL E & MELISSA L WHITE	11.54
O2	1-347-2	KURT SKASIK	10.75
P2	1-347-4	MARK A SKASIK	62.42
Q2	1-347-3	KURT SKASIK	5.12
ROAD	N/A	COUNTY ROUTE 25/17-RED DOG ROAD	N/A
R2	1-347-29	KURT SKASIK	60.8
S2	12-347-32	WV DNR	245.15
T2	12-347-41.6	TOMMY FORNASH	47.71
U2	12-347-67	HAROLD W & TINA M VANHORN	7.52
ROAD	N/A	STREET IN CLAREDALE SUBDIVISION	N/A
V2	12-347-66	HAROLD W & TINA M VANHORN	3.09
W2	12-347-67.1	HAROLD W & TINA M VANHORN	0.68
ROAD	N/A	COUNTY ROUTE 25/10-MT CLARE & NORWOOD RD.	N/A
X2	12-367-5	JASON CHARLES & MESSENGER	9
Y2	12-367-6	HOWARD LEE SPARKS JR	9
Z2	12-367-7	JOHNNY GENE LEARY JR	12
A3	12-367-36.1	PERRY H ALLEN ETAL	79
B3	12-367-35	DEBRA MCCUTCHEON	9.64
C3	12-367-41	ROBERT H & DONNA J CORK	58.97
ROAD	N/A	COUNTY ROUTE 25/5-FLORENCE HOLLOW RD.	N/A
D3	12-367-43	KENNETH W MONEYPENNY	51.415
E3	12-2013-8	TMP PROPERTIES LLC	0.275
ROAD	N/A	COUNTY ROUTE 25/8-FLORENCE HOLLOW RD.	N/A
F3	12-2013-9	CASANDRA & LEANNE KEENER	2.885
G3	12-2013-14	BARRY SINCLAIR	1.56
ROAD	N/A	COUNTY ROUTE 25/4-CHUBB RUN RD.	N/A
H3	12-2013-15	REBECCA KETELSEN	0.202
I3	12-2013-16	RONALD D LARRY	1.68
J3	12-2013-18.1	MICHAEL D STADIN	0.32
K3	12-2013-19	RONALD D LARRY	0.25
L3	12-2013-20	RONALD D LARRY	0.33
M3	12-2013-21	RONALD D LARRY	15 POLES
N3	12-367-70.1	RUDY D LARRY	9.64
O3	12-367-55	RUDY D LARRY & RONALD D LARRY	36.76
P3	12-387-9	RONALD LARRY	10.5
Q3	12-387-10	RONALD H ROGERS	19.36
R3	12-387-11	RONALD H ROGERS	22.83
S3	12-387-22	RONALD H ROGERS	49.74

RECEIVED
Office of Oil and Gas

JUL 23 2025

WV Department of
Environmental Protection


FILE NO. 9423P202AD.dwg

DATE SEPTEMBER 11, 2024

REVISED JUNE 1, 2025

OPERATORS WELL NO. 202

API WELL NO. 47 — 033 — 06039
STATE COUNTY PERMIT

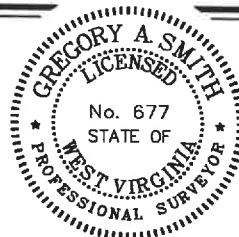

STATE OF WEST VIRGINIA
DIVISION OF
ENVIRONMENTAL PROTECTION
OFFICE OF OIL AND GAS



P.S.
677

Gregory A. Smith

WELL OPERATOR ARSENAL RESOURCES
ADDRESS 6031 WALLACE RD. EXT. SUITE 200
WEXFORD, PA 15090

DESIGNATED AGENT ERIC MORRIS
ADDRESS 633 WEST MAIN STREET
BRIDGEPORT, WV 26330

09/19/2025

**LGD WELL PAD
WELL NO. 202
ARSENAL RESOURCES**T.H. LATITUDE 39°17'30"
B.H. LATITUDE 39°15'00"**NOTES ON SURVEY**

1. NO WATER WELLS WERE FOUND WITHIN 250' OF PROPOSED GAS WELL. NO AGRICULTURAL BUILDINGS > 2500 SQ. FT. OR DWELLINGS WERE FOUND WITHIN 625' OF THE CENTER OF PROPOSED WELL PAD.
2. WELL SPOT CIRCLE & TOPO MARK SCALE ARE 1"=2000'.
3. AS-DRILLED DATA PROVIDED BY ARSENAL RESOURCES
4. PLAT UPDATED TO SHOW AS-DRILLED PATH.


CURVE	RADIUS	ARC LENGTH	CHORD LENGTH	CHORD BEARING
C1	367.89'	86.99'	86.78'	N 75°09' E
C2	73.13'	110.70'	100.43'	S 60°53' E
C3	22787.48'	1274.69'	1274.52'	S 20°10' E

(S.P.C. NORTH ZONE) (UTM(M) ZONE 17)NAD'83 S.P.C.(FT) N. 279,272.11 E. 1,723,451.04
NAD'83 GEO. LAT-(N) 39.263511 LONG-(W) 80.365487
NAD'83 UTM (M) N. 4,346,211.19 E. 554,739.41**LANDING POINT**NAD'83 S.P.C.(FT) N. 278,870.9 E. 1,725,047.5
NAD'83 GEO. LAT-(N) 39.262452 LONG-(W) 80.359836
NAD'83 UTM (M) N. 4,346,097.0 E. 555,227.8**BOTTOM HOLE**NAD'83 S.P.C.(FT) N. 259,665.3 E. 1,731,671.5
NAD'83 GEO. LAT-(N) 39.209900 LONG-(W) 80.335811
NAD'83 UTM (M) N. 4,340,279.5 E. 557,343.3


LINE	BEARING	DISTANCE
L1	N 50°02' E	90.49'
L2	N 80°00' E	1167.14'
L3	S 17°22' E	324.52'
L4	S 18°32' E	343.64'
L5	N 68°19' W	398.22'
L6	S 68°35' E	444.54'

**AS DRILLED COORDINATES
FOR WELL NO. 202****(S.P.C. NORTH ZONE) (UTM(M) ZONE 17)**NAD'83 S.P.C.(FT) N. 279,272.11 E. 1,723,451.04
NAD'83 GEO. LAT-(N) 39.263511 LONG-(W) 80.365487
NAD'83 UTM (M) N. 4,346,211.19 E. 554,739.41**LANDING POINT**NAD'83 S.P.C.(FT) N. 278,768.2 E. 1,725,096.6
NAD'83 GEO. LAT-(N) 39.262171 LONG-(W) 80.359859
NAD'83 UTM (M) N. 4,346,066.0 E. 555,243.3**BOTTOM HOLE**NAD'83 S.P.C.(FT) N. 259,670.8 E. 1,731,676.7
NAD'83 GEO. LAT-(N) 39.209911 LONG-(W) 80.335793
NAD'83 UTM (M) N. 4,340,281.2 E. 557,344.8**LEGEND**

LEASE LINE	---
SURFACE LINE	----
WELL LATERAL	-----
500' OFFSET LINE	-----
TIE LINE	-----
CREEK	~~~~~
ROAD	-----
COUNTY ROUTE	-----
PROPOSED WELL	◎
EXISTING WELL	⊙
PERMITTED WELL	○
TAX MAP-PARCEL	00-00
SURFACE OWNER (SEE TABLE)	
LEASE # (SEE WW-6A1)	A

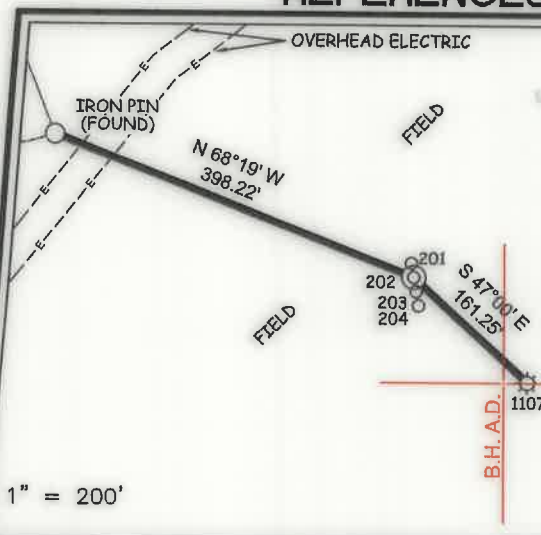12 Vanhorn Drive | P.O. Box 150 | Glenville, WV 26351 | 304.462.5634
1412 Kanawha Boulevard, East | Charleston, WV 25301 | 304.346.3952
254 East Beckley Bypass | Beckley, WV 25801 | 304.255.5296
slsww.com**REFERENCES**

I THE UNDERSIGNED, HEREBY CERTIFY THAT THIS PLAT IS CORRECT TO THE BEST OF MY KNOWLEDGE AND BELIEF AND SHOWS ALL THE INFORMATION REQUIRED BY LAW AND THE REGULATIONS ISSUED AND PRESCRIBED BY THE DIVISION OF ENVIRONMENTAL PROTECTION.

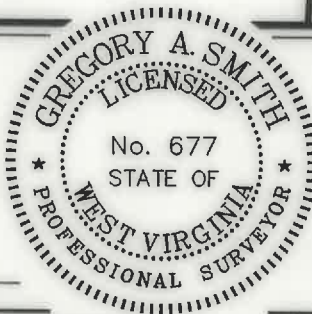P.S.
677

(+) DENOTES LOCATION OF WELL ON UNITED STATES TOPOGRAPHIC MAPS

DATE SEPTEMBER 11, 20 24

REVISED JUNE 1, 20 25

OPERATORS WELL NO. 202

API WELL NO. 47 - 033 - 06039
STATE COUNTY PERMIT

MINIMUM DEGREE OF ACCURACY 1 / 2500 FILE NO. 9423P202AD.dwg

HORIZONTAL & VERTICAL SCALE 1" = 2000'
CONTROL DETERMINED BY: DGPS (SURVEY GRADE TIE TO CORS NETWORK)STATE OF WEST VIRGINIA
DIVISION OF ENVIRONMENTAL PROTECTION
OFFICE OF OIL AND GASWELL TYPE: OIL GAS ☒ LIQUID INJECTION WASTE DISPOSAL IF "GAS" PRODUCTION ☒ STORAGE DEEP SHALLOW ☒**LOCATION :**

ELEVATION 1,007.60' WATERSHED WEST FORK RIVER

DISTRICT CLARK COUNTY HARRISON QUADRANGLE CLARKSBURG

SURFACE OWNER LAURA GOFF DAVIS

ACREAGE 161.22±

ROYALTY OWNER LAURA GOFF DAVIS, ET AL

ACREAGE 400±

PROPOSED WORK :

LEASE NO. SEE WW-6A1

DRILL ☒ CONVERT DRILL DEEPER REDRILL FRACTURE OR STIMULATE ☒ PLUG OFF OLD

FORMATION PERFORATE NEW FORMATION PLUG AND ABANDON CLEAN OUT AND REPLUG OTHER

PHYSICAL CHANGE IN WELL (SPECIFY) TARGET FORMATION MARCELLUS

ESTIMATED DEPTH TMD 28,045.00' / TVD 7,127.58'

WELL OPERATOR ARSENAL RESOURCES

DESIGNATED AGENT ERIC MORRIS

ADDRESS 6031 WALLACE RD. EXT. SUITE 200

ADDRESS 633 WEST MAIN STREET

WEXFORD, PA 15090

BRIDGEPORT, WV 26330

T.H. LONGITUDE 80°20'00"
B.H. LONGITUDE 80°05'00"

10,225' T.H. A.D.

COUNTY NAME

PERMIT

T.H. LATITUDE 39°17'30"
B.H. LATITUDE 39°15'00"**LGD WELL PAD
WELL NO. 202
ARSENAL RESOURCES****LEGEND**

AS DRILLED


PROPOSED

T.H. LONGITUDE 80°20'00"
B.H. LONGITUDE 80°05'00"

14,602' B.H. A.D.

10,225' T.H. A.D.

B.H. A.D.

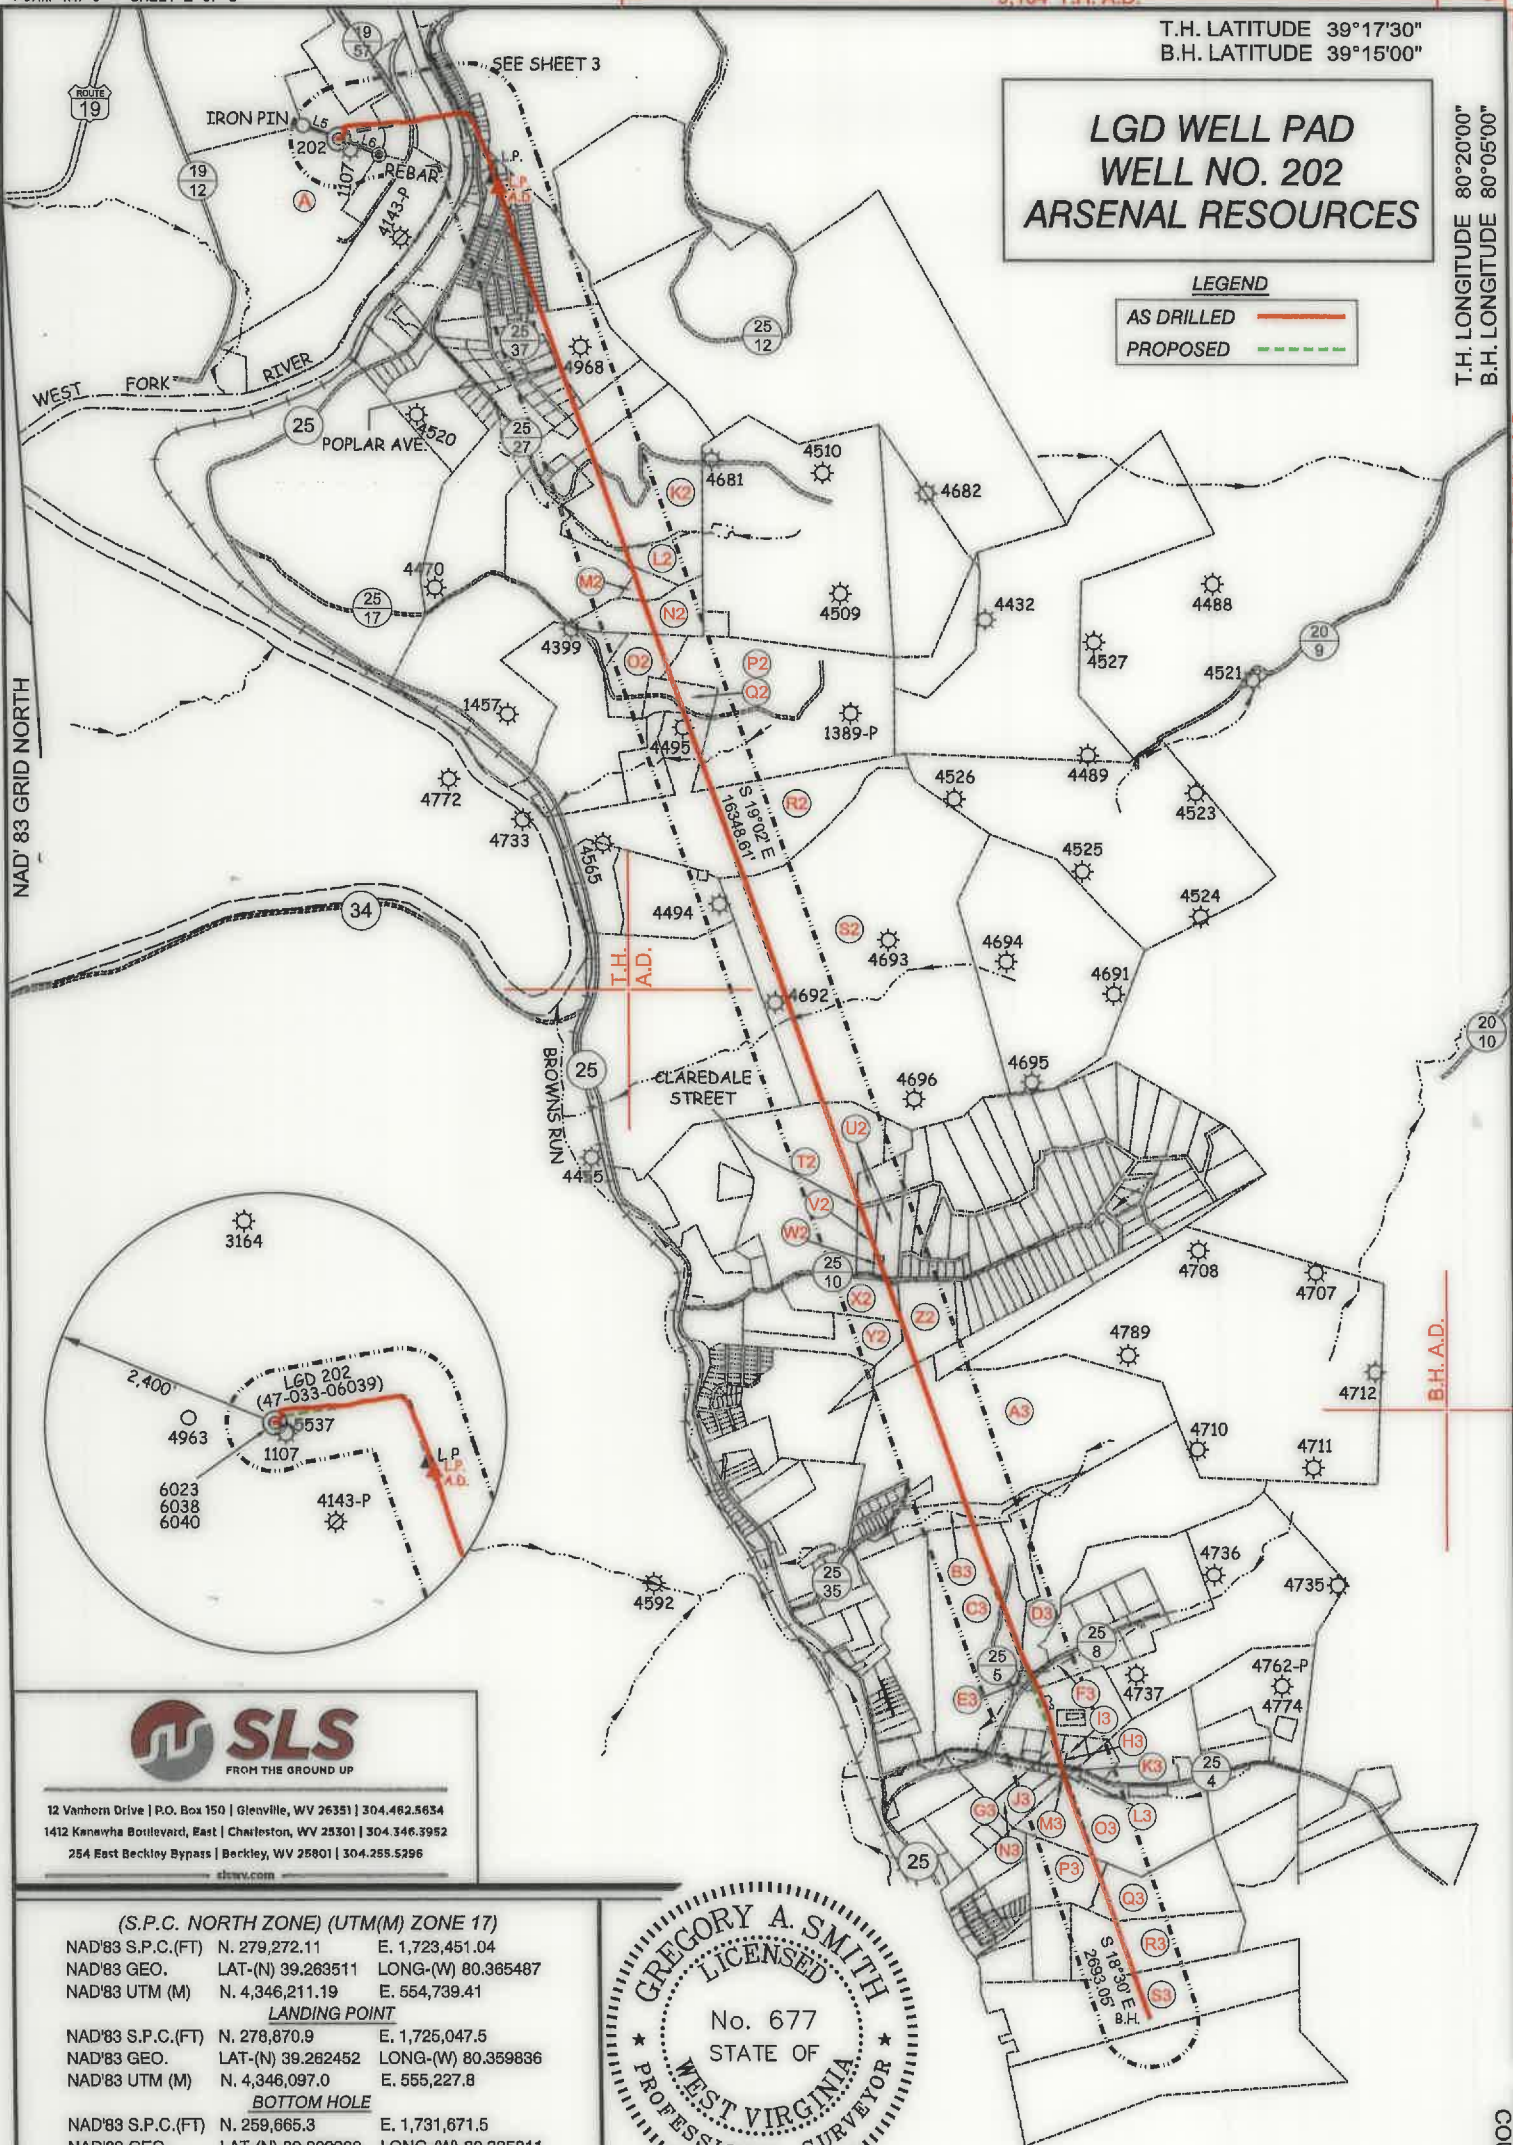

12 Vanhorn Drive | P.O. Box 150 | Glenville, WV 26351 | 304.462.5634
1412 Kanawha Boulevard, East | Charleston, WV 25301 | 304.346.3952
254 East Beckley Bypass | Beckley, WV 26801 | 304.255.5296
slswv.com

(S.P.C. NORTH ZONE) (UTM(M) ZONE 17)


NAD'83 S.P.C.(FT) N. 279,272.11 E. 1,723,451.04
NAD'83 GEO. LAT-(N) 39.263511 LONG-(W) 80.365487
NAD'83 UTM (M) N. 4,346,211.19 E. 554,739.41

LANDING POINT

NAD'83 S.P.C.(FT) N. 278,870.9 E. 1,725,047.5
NAD'83 GEO. LAT-(N) 39.262452 LONG-(W) 80.359836
NAD'83 UTM (M) N. 4,346,097.0 E. 555,227.8

BOTTOM HOLE

NAD'83 S.P.C.(FT) N. 259,665.3 E. 1,731,671.5
NAD'83 GEO. LAT-(N) 39.209900 LONG-(W) 80.335811
NAD'83 UTM (M) N. 4,340,279.5 E. 557,343.3

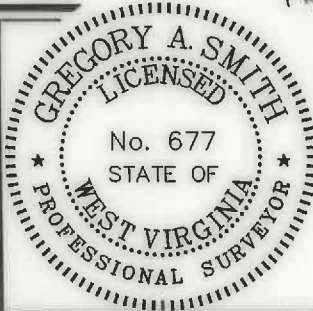

SCALE 1" = 2000' FILE NO. 9423P202AD.dwg

DATE SEPTEMBER 11, 20 24

REVISED JUNE 1, 20 25

OPERATORS WELL NO. 202

API WELL NO. 47 — 033 — 06039

WELL OPERATOR ARSENAL RESOURCES

ADDRESS 6031 WALLACE RD. EXT. SUITE 200
WEXFORD, PA 15090STATE OF WEST VIRGINIA
DIVISION OF
ENVIRONMENTAL PROTECTION
OFFICE OF OIL AND GAS

DESIGNATED AGENT ERIC MORRIS

ADDRESS 633 WEST MAIN STREET
BRIDGEPORT, WV 26330

09/19/2025

P.S.
677

(+) DENOTES LOCATION OF WELL ON UNITED STATES TOPOGRAPHIC MAPS

COUNTY NAME


PERMIT

LGD WELL PAD
WELL NO. 202
ARSENAL RESOURCES



12 Vanhorn Drive | P.O. Box 150 | Glenville, WV 26351 | 304.462.5834
1412 Kanawha Boulevard, East | Charleston, WV 25301 | 304.346.3952
254 East Beckley Bypass | Beckley, WV 25801 | 304.255.5296
slswv.com

SCALE 1" = 500'

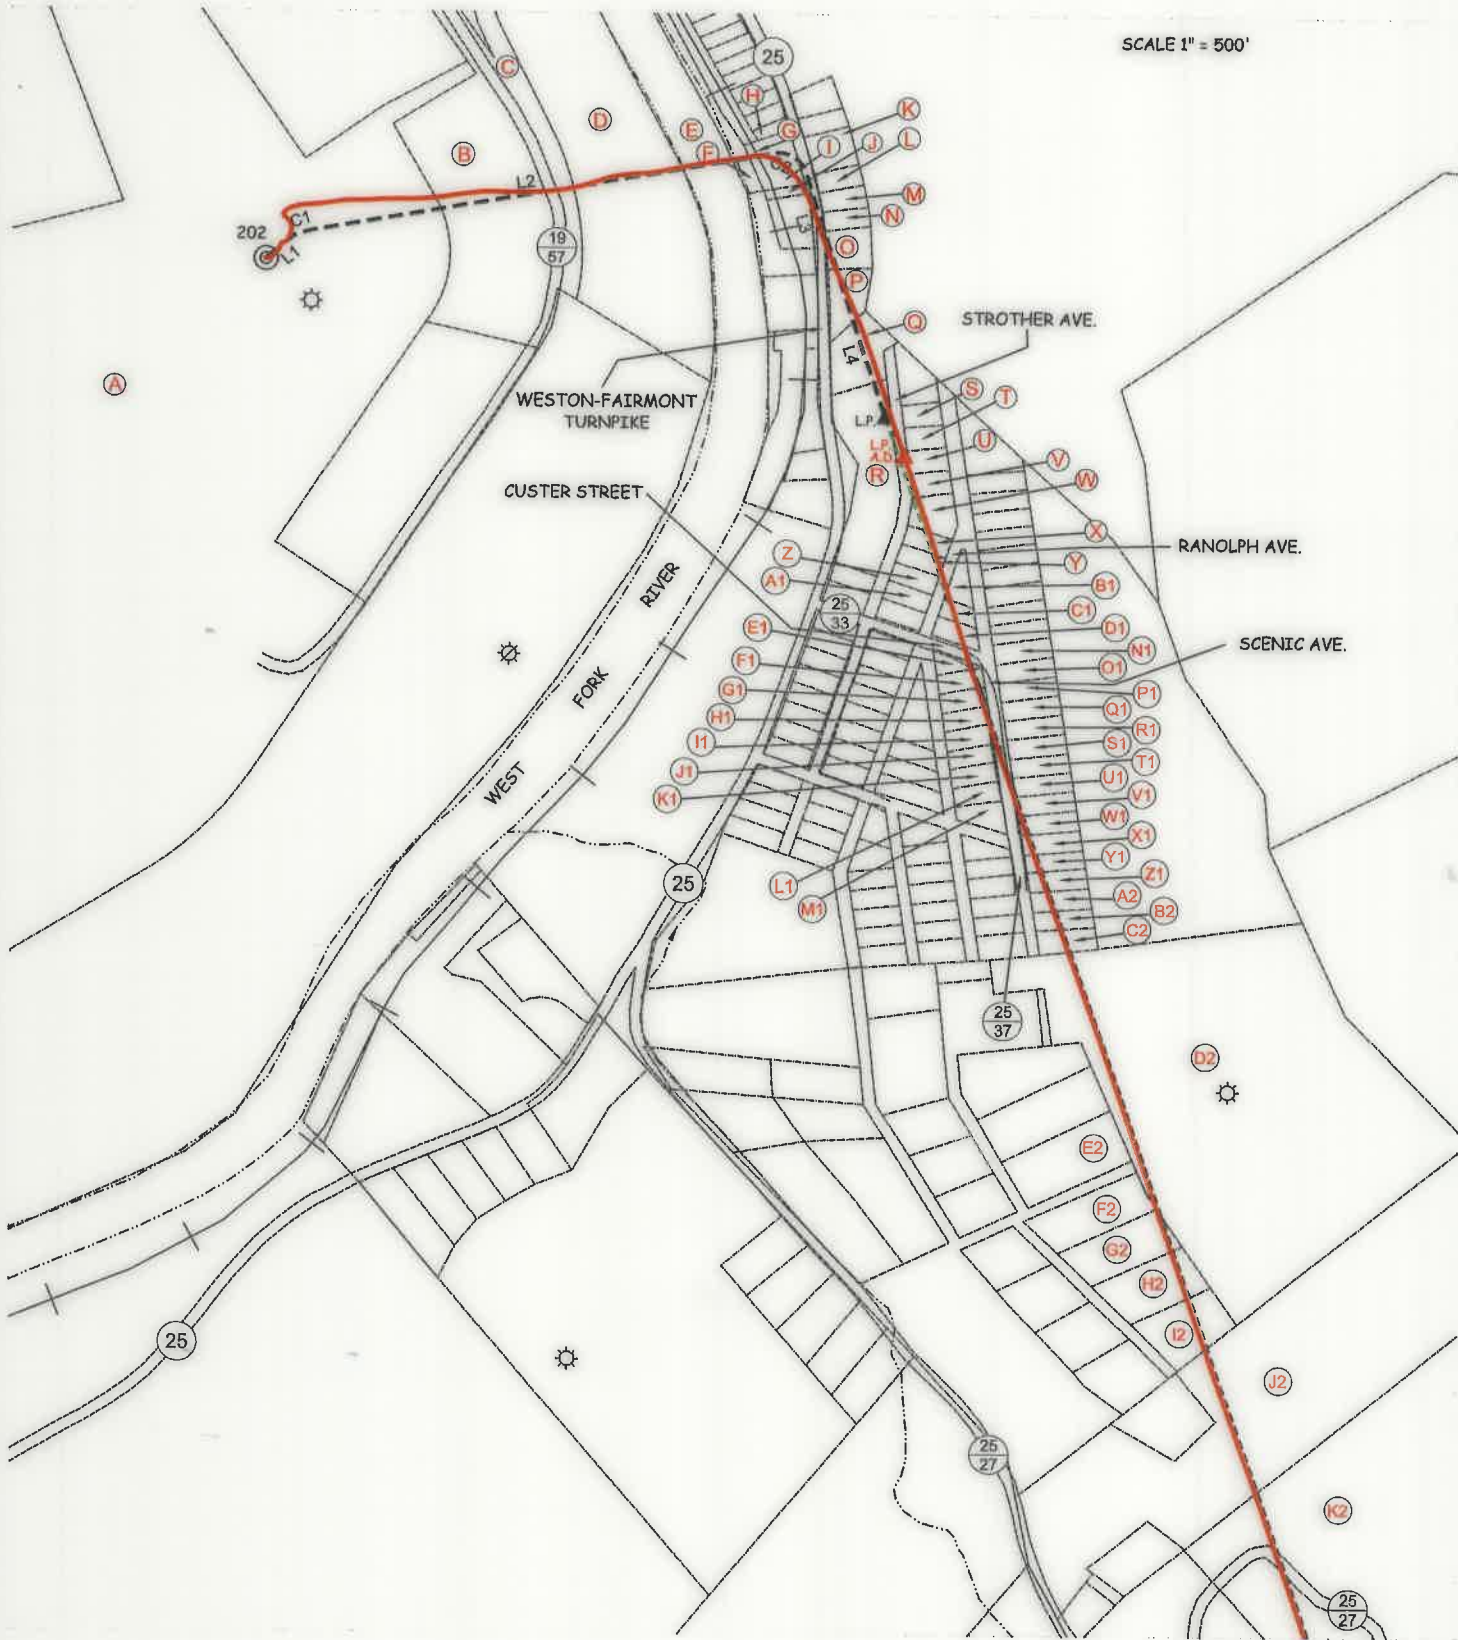

LGD WELL PAD
WELL NO. 202
ARSENAL RESOURCES



12 Vanhorn Drive | P.O. Box 150 | Glenville, WV 26351 | 304.462.5634
1412 Kanawha Boulevard, East | Charleston, WV 25301 | 304.346.3952
254 East Beckley Bypass | Beckley, WV 25801 | 304.255.5296
slswv.com

TAG	PARCEL	SURFACE OWNER/ROAD/RIVER	ACREAGE
A	1-326-37	LAURA GOFF DAVIS	161.22
B	1-326-37.3	SHAFFER ENTERPRISES INC	3.82
ROAD	N/A	COUNTY ROUTE 19/57-ARMORY ROAD	N/A
C	1-326-85	GENERAL CORPORATION	1.45
D	1-326-38	GENERAL CORPORATION	8.21
E	N/A	WEST FORK RIVER	N/A
F	1-115-14	MINNIE REED WHALEY	LOT
G	1-326-102	W.V. STATE RAIL AUTHORITY	108.47
H	1-115-26	RICHARD A & EDITH M BENNETT	LOTS 14,15,16
I	1-115-38	BARBARA BLAKE ET AL	LOT
J	1-115-29	BARBARA BLAKE ET AL	LOT
ROAD	N/A	COUNTY ROUTE 25-WESTON FAIRMONT TURNPIKE	N/A
K	1-115-30	RICHARD A & EDITH M BENNETT	LOT 100 X 120
L	1-115-32	BMJ LIVING TRUST	LOT 50 X 100
M	115-33	RICHARD A BENNETT	LOT 50 X 120
N	115-35	RICHARD A BENNETT	LOT 50 X 120
O	1-115-36	RICHARD A & EDITH M BENNETT	LOT
P	1-115-36.1	JUDITH ANN BEVERLIN	LOT (0.69 AC)
Q	1-109-1	JUDITH ANN BEVERLIN	LOTS 1-3
R	1-109-7	TIMOTHY C & MARTHA WAGNER	LOTS 4-12
ROAD	N/A	STROTHER AVE.	N/A
S	1-109-8	ROBIN E MCSHANE ET AL	LOT 49
T	1-109-10	ROBIN E MCSHANE ET AL	LOT 48
U	1-109-12	ROBIN E MCSHANE ET AL	LOT 47
V	1-109-15	ROBIN E MCSHANE ET AL	LOT 46
W	1-109-18	ROBIN E MCSHANE ET AL	LOT 45
X	1-109-21	ROBIN E MCSHANE ET AL	LOT 44
Y	1-109-24	ROBIN E MCSHANE ET AL	LOT 43
ROAD	N/A	RANDOLPH AVE.	N/A
Z	1-109-27	ROBIN E MCSHANE ET AL	LOT 42
A1	1-109-31	SARRA N MARTIN	LOT 41
B1	1-109-28	ROBIN E MCSHANE ET AL	LOT 69
C1	1-109-33	ROBIN E MCSHANE ET AL	LOT 70
D1	1-109-34	ROBIN E MCSHANE ET AL	LOT 71
ROAD	N/A	CUSTER STREET-COUNTY ROUTE 25/37	N/A
E1	1-109-41	ROBIN E MCSHANE ET AL	LOT 72
F1	1-109-45	ROBIN E MCSHANE ET AL	LOT 73
G1	1-109-49	ROBIN E MCSHANE ET AL	LOT 74
H1	1-109-53	ROBIN E MCSHANE ET AL	LOT 75
I1	1-109-58	ROBIN E MCSHANE ET AL	LOT 76
ROAD	N/A	SCENIC AVE. -COUNTY ROUTE 25/37	N/A
J1	1-109-63	ROBIN E MCSHANE ET AL	LOT 77
K1	1-109-68	ROBIN E MCSHANE ET AL	LOT 78
L1	1-109-73	ROBIN E MCSHANE ET AL	LOT 79
M1	1-109-74	DAVID J BARNETT JR	LOT 80
N1	1-109-42	ROBIN E MCSHANE ET AL	LOT 102
O1	1-109-46	ROBIN E MCSHANE ET AL	LOT 101
P1	1-109-50	ROBIN E MCSHANE ET AL	LOT 100
Q1	1-109-54	MICHAEL & LORI LEMASTERS	LOT 99
R1	1-109-59	MICHAEL & LORI LEMASTERS	LOT 98
S1	1-109-64	MICHAEL & LORI LEMASTERS	LOT 97
T1	1-109-69	SANDRA MORRIS ETAL	LOT 96
U1	1-109-75	ROBERT ERIC SUMMERFIELD ET AL	LOT 95
V1	1-109-76	ROBERT ERIC SUMMERFIELD ET AL	LOT 94
W1	1-109-77	LUCINDA MCGINNIS (LE)	LOT 93
X1	1-109-85	LUCINDA MCGINNIS (LE)	LOT 92

FILE NO. 9423P202AD.dwg

DATE SEPTEMBER 11, 2024

REVISED JUNE 1, 2025

OPERATORS WELL NO. 202

API WELL NO. 47 — 033 — 06039

STATE COUNTY PERMIT



STATE OF WEST VIRGINIA
DIVISION OF ENVIRONMENTAL PROTECTION
OFFICE OF OIL AND GAS



P.S. 677 Gregory A. Smith

WELL OPERATOR ARSENAL RESOURCES
ADDRESS 6031 WALLACE RD. EXT. SUITE 200
WEXFORD, PA 15090

DESIGNATED AGENT ERIC MORRIS
ADDRESS 633 WEST MAIN STREET
BRIDGEPORT, WV 26330

COUNTY NAME

PERMIT

LGD WELL PAD
WELL NO. 202
ARSENAL RESOURCES



12 Vanhorn Drive | P.O. Box 150 | Glenville, WV 26351 | 304.462.5534
1412 Kanawha Boulevard, East | Charleston, WV 25301 | 304.346.3952
254 East Beckley Bypass | Beckley, WV 25801 | 304.255.5295
slewwv.com

Y1	1-109-95	LUCINDA MCGINNIS (LE)	LOT 91
Z1	1-109-100	MICHAEL & LORI LEMASTERS	LOT 90
A2	1-109-105	MICHAEL & LORI LEMASTERS	LOT 89
B2	1-109-114	MICHAEL & LORI LEMASTERS	LOT 88
C2	1-109-115	MICHAEL & LORI LEMASTERS	LOT 87
D2	1-326-79.2	ROBERT SCOTT WAGNER ET AL	14.67
E2	1-117-19	SCOTT L & TERESA R BIGELOW ET AL	0.99
ROAD	N/A	POPLAR AVE.	N/A
F2	1-117-24	JAMES & RHONDA LYON ET AL	0.73
G2	1-117-25	SCOTT L HENSLEY	0.74
H2	1-117-26	SCOTT L HENSLEY	0.75
I2	1-117-27	SCOTT L HENSLEY	0.73
J2	1-326-81.1	ROBERT SCOTT WAGNER ET AL	11.75
ROAD	N/A	COUNTY ROUTE 25/27-DOLL RUN ROAD	N/A
K2	1-326-82	DIANA LYNN BARNETT	L2+A17:D73
L2	1-347-1.2	ANGELA R ANDERSON	9.32
M2	1-347-1	LESTER G ANDERSON JR	2.4
N2	1-347-1.1	MICHAEL E & MELISSA L WHITE	11.54
O2	1-347-2	KURT SKASIK	10.75
P2	1-347-4	MARK A SKASIK	62.42
Q2	1-347-3	KURT SKASIK	5.12
ROAD	N/A	COUNTY ROUTE 25/17-RED DOG ROAD	N/A
R2	1-347-29	KURT SKASIK	60.8
S2	12-347-32	WV DNR	245.15
T2	12-347-41.6	TOMMY FORNASH	47.71
U2	12-347-67	HAROLD W & TINA M VANHORN	7.52
ROAD	N/A	STREET IN CLAREDALE SUBDIVISION	N/A
V2	12-347-66	HAROLD W & TINA M VANHORN	3.09
W2	12-347-67.1	HAROLD W & TINA M VANHORN	0.68
ROAD	N/A	COUNTY ROUTE 25/10-MT CLARE & NORWOOD RD.	N/A
X2	12-367-5	JASON CHARLES & MESSENGER	9
Y2	12-367-6	HOWARD LEE SPARKS JR	9
Z2	12-367-7	JOHNNY GENE LEARY JR	12
A3	12-367-36.1	PERRY H ALLEN ETAL	79
B3	12-367-35	DEBRA MCCUTCHEON	9.64
C3	12-367-41	ROBERT H & DONNA J CORK	58.97
ROAD	N/A	COUNTY ROUTE 25/5-FLORENCE HOLLOW RD.	N/A
D3	12-367-43	KENNETH W MONEYPENNY	51.415
E3	12-2013-8	TMP PROPERTIES LLC	0.275
ROAD	N/A	COUNTY ROUTE 25/8-FLORENCE HOLLOW RD.	N/A
F3	12-2013-9	CASANDRA & LEANNE KEENER	2.885
G3	12-2013-14	BARRY SINCLAIR	1.56
ROAD	N/A	COUNTY ROUTE 25/4-CHUBB RUN RD.	N/A
H3	12-2013-15	REBECCA KETELSEN	0.202
I3	12-2013-16	RONALD D LARRY	1.68
J3	12-2013-18.1	MICHAEL D STADIN	0.32
K3	12-2013-19	RONALD D LARRY	0.25
L3	12-2013-20	RONALD D LARRY	0.33
M3	12-2013-21	RONALD D LARRY	15 POLES
N3	12-367-70.1	RUDY D LARRY	9.64
O3	12-367-55	RUDY D LARRY & RONALD D LARRY	36.76
P3	12-387-9	RONALD LARRY	10.5
Q3	12-387-10	RONALD H ROGERS	19.36
R3	12-387-11	RONALD H ROGERS	22.83
S3	12-387-22	RONALD H ROGERS	49.74

FILE NO. 9423P202AD.dwg

DATE SEPTEMBER 11, 2024

REVISED JUNE 1, 2025

OPERATORS WELL NO. 202

API WELL NO. 47 — 033 — 06039

STATE COUNTY PERMIT



STATE OF WEST VIRGINIA
DIVISION OF ENVIRONMENTAL PROTECTION
OFFICE OF OIL AND GAS

09/19/2025

P.S. 677 Gregory A. Smith

WELL OPERATOR ARSENAL RESOURCES

ADDRESS 6031 WALLACE RD. EXT. SUITE 200 WEXFORD, PA 15090

DESIGNATED AGENT ERIC MORRIS

ADDRESS 633 WEST MAIN STREET BRIDGEPORT, WV 26330