LATITUDE 39° 17' 30"

LONGITUDE 80° 32' 30"

1.25Ω
0.81W

7'5 OGIS topo location

7.5' loc _____ 15' loc _____
(calc.)

Company _____

Farm Gus Hersey #1

Quad Salem 7½

County Harrison

District Jeanvile

WELL LOCATION MAP

File No. 033-30112

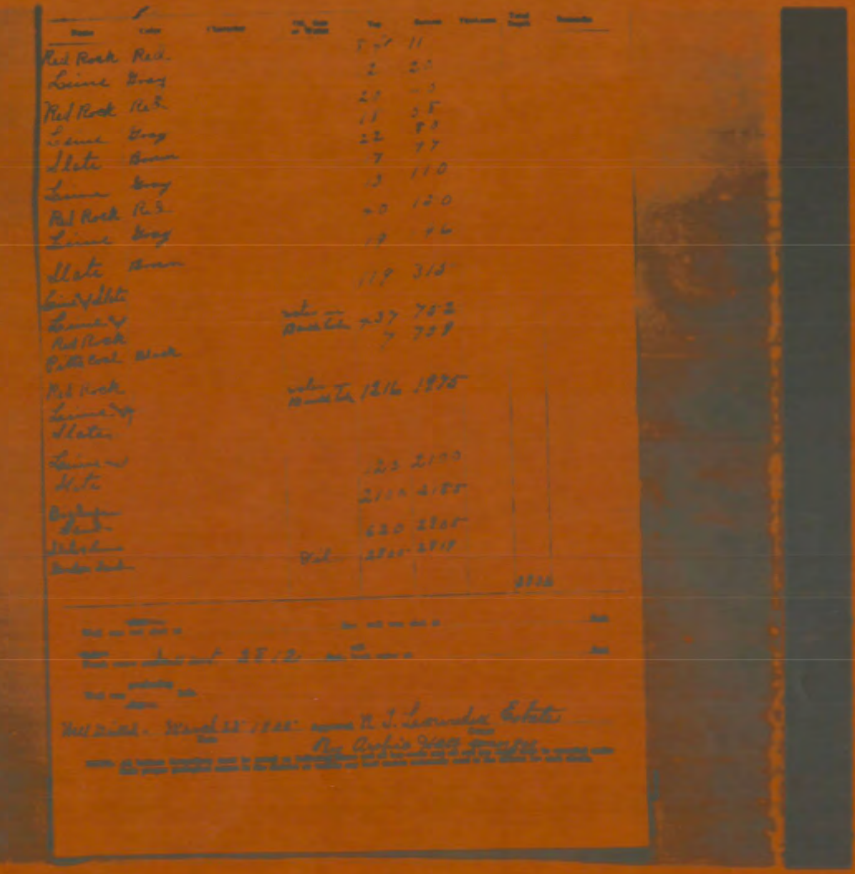

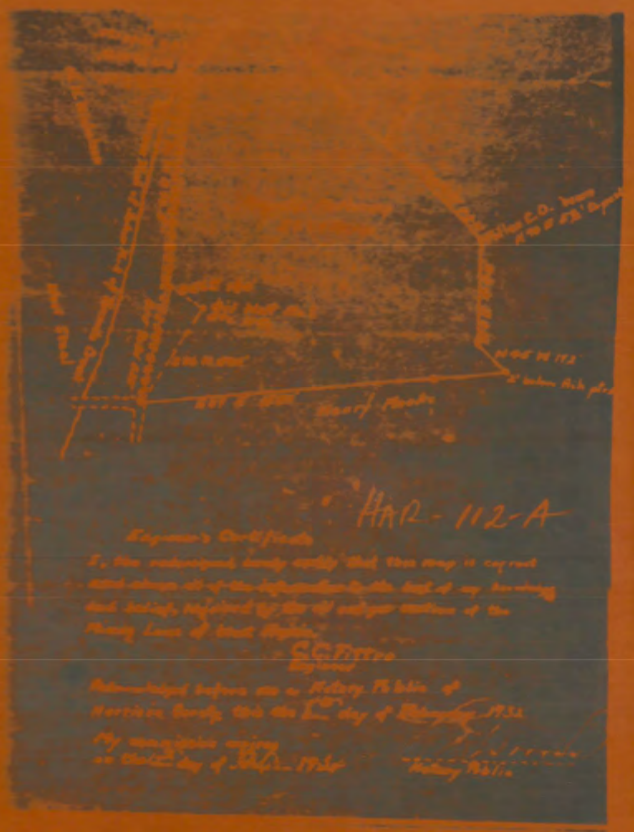
HAR-112-A