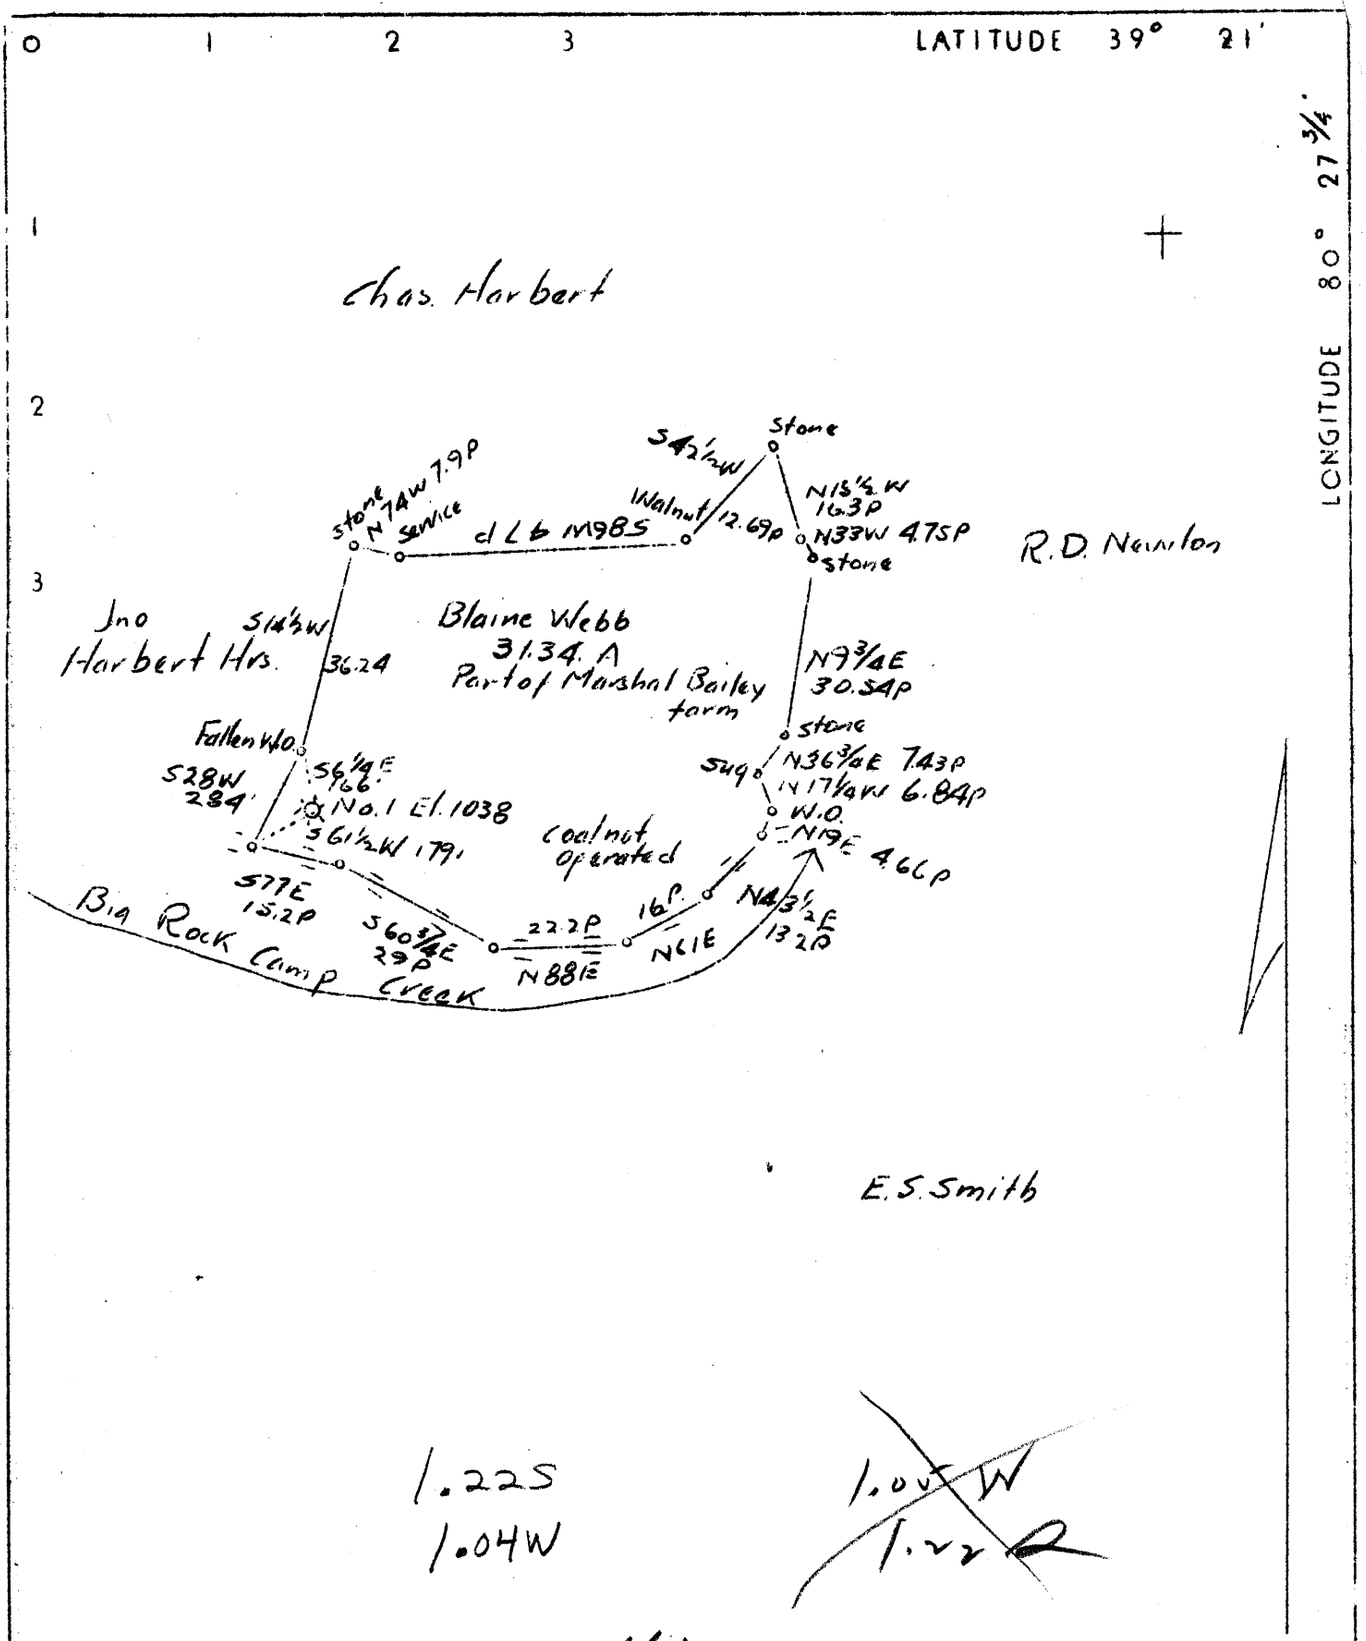

Company	Raad and Moses 3178
Address	Salem, W. Va.
Farm	Blaine Webb
Tract	Acres 31.34 Lease No.
Well(Farm) No.	1 Serial No.
Elevation (Spirit Level)	1038
Quadrangle	Clarksburg (WC)
County	Harrison District Sardis
Engineer	C. C. Fittro, C. E.
Engineer's Registration No.	818
Date	3-31-37 Scale 30 poles - 1 inch

STATE OF WEST VIRGINIA
Department of Mines
OIL AND GAS DIVISION
Charleston

WELL LOCATION MAP

File No. HAR-372A

+ Denotes location of well on U. S. Topographic Maps, scale 1 to 62,500 latitude and longitude lines being represented by border lines as shown

— Denotes one inch spaces on border line of original tracing.