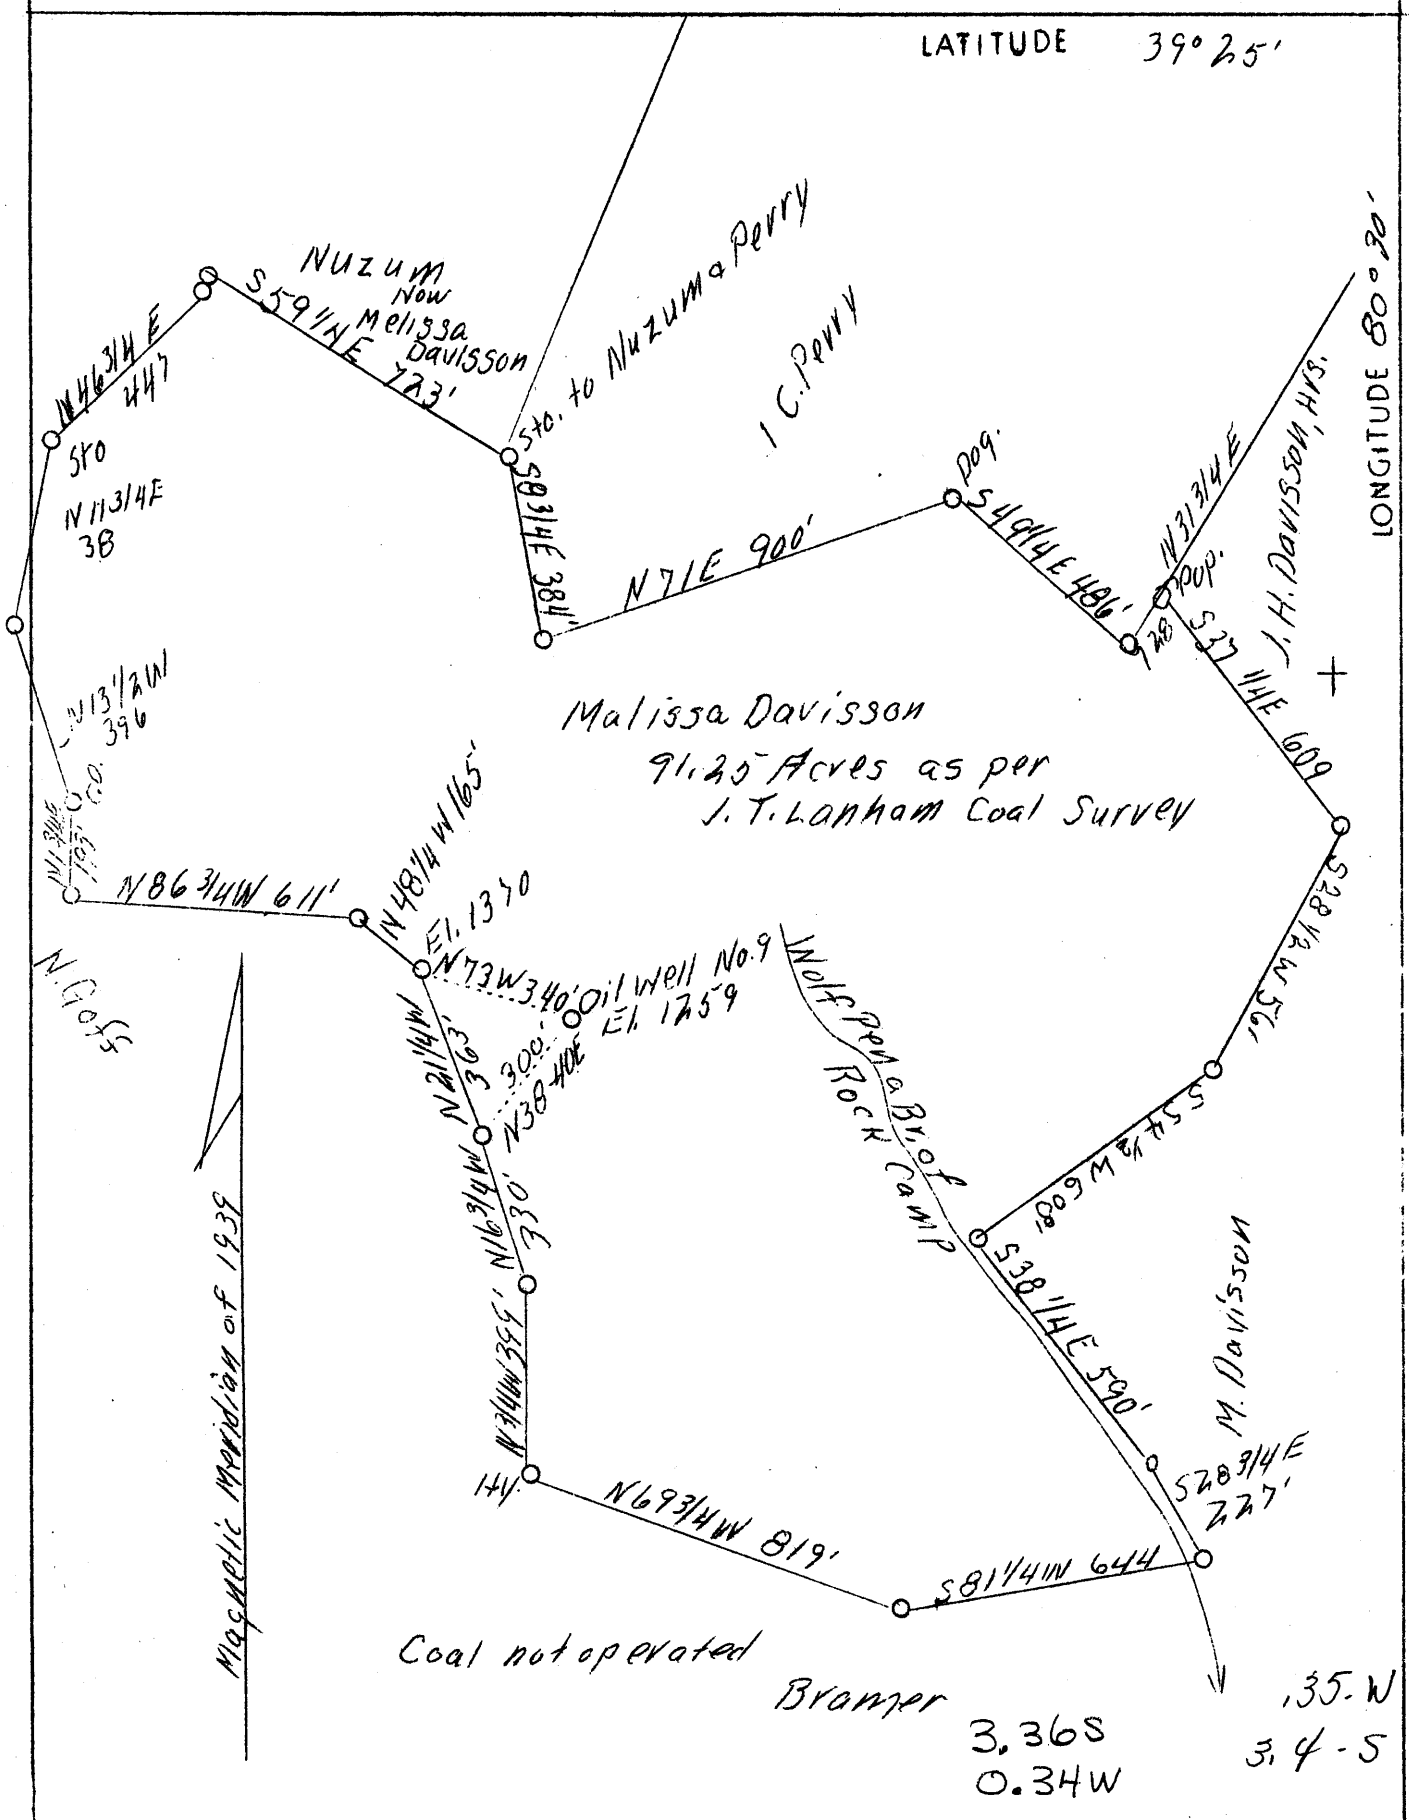

Company	Wm. Moses
Address	Salem, W.Va.
Farm	Melissa Davisson
Acres	91.25
Well(Farm)No.	9
El.(S.L.)	1259
Quadrangle	Centerpoint
County	Harrison
District	Sardis
Eng.	C.C.Fittro, C.E.
Eng. Reg. No.	818
File No.	xyz
Drawing No.	112
Date	5/11/39
Scale	1" - 400'

STATE OF WEST VIRGINIA
Department of Mines
OIL AND GAS DIVISION
Charleston

WELL LOCATION MAP

File No. Har-488-F

x Denotes location of well on U.S. Topographic Maps, scale 1 to 62,500, latitude and longitude lines being represented by border lines as shown.

- Denotes one inch spaces on border line of original tracing.