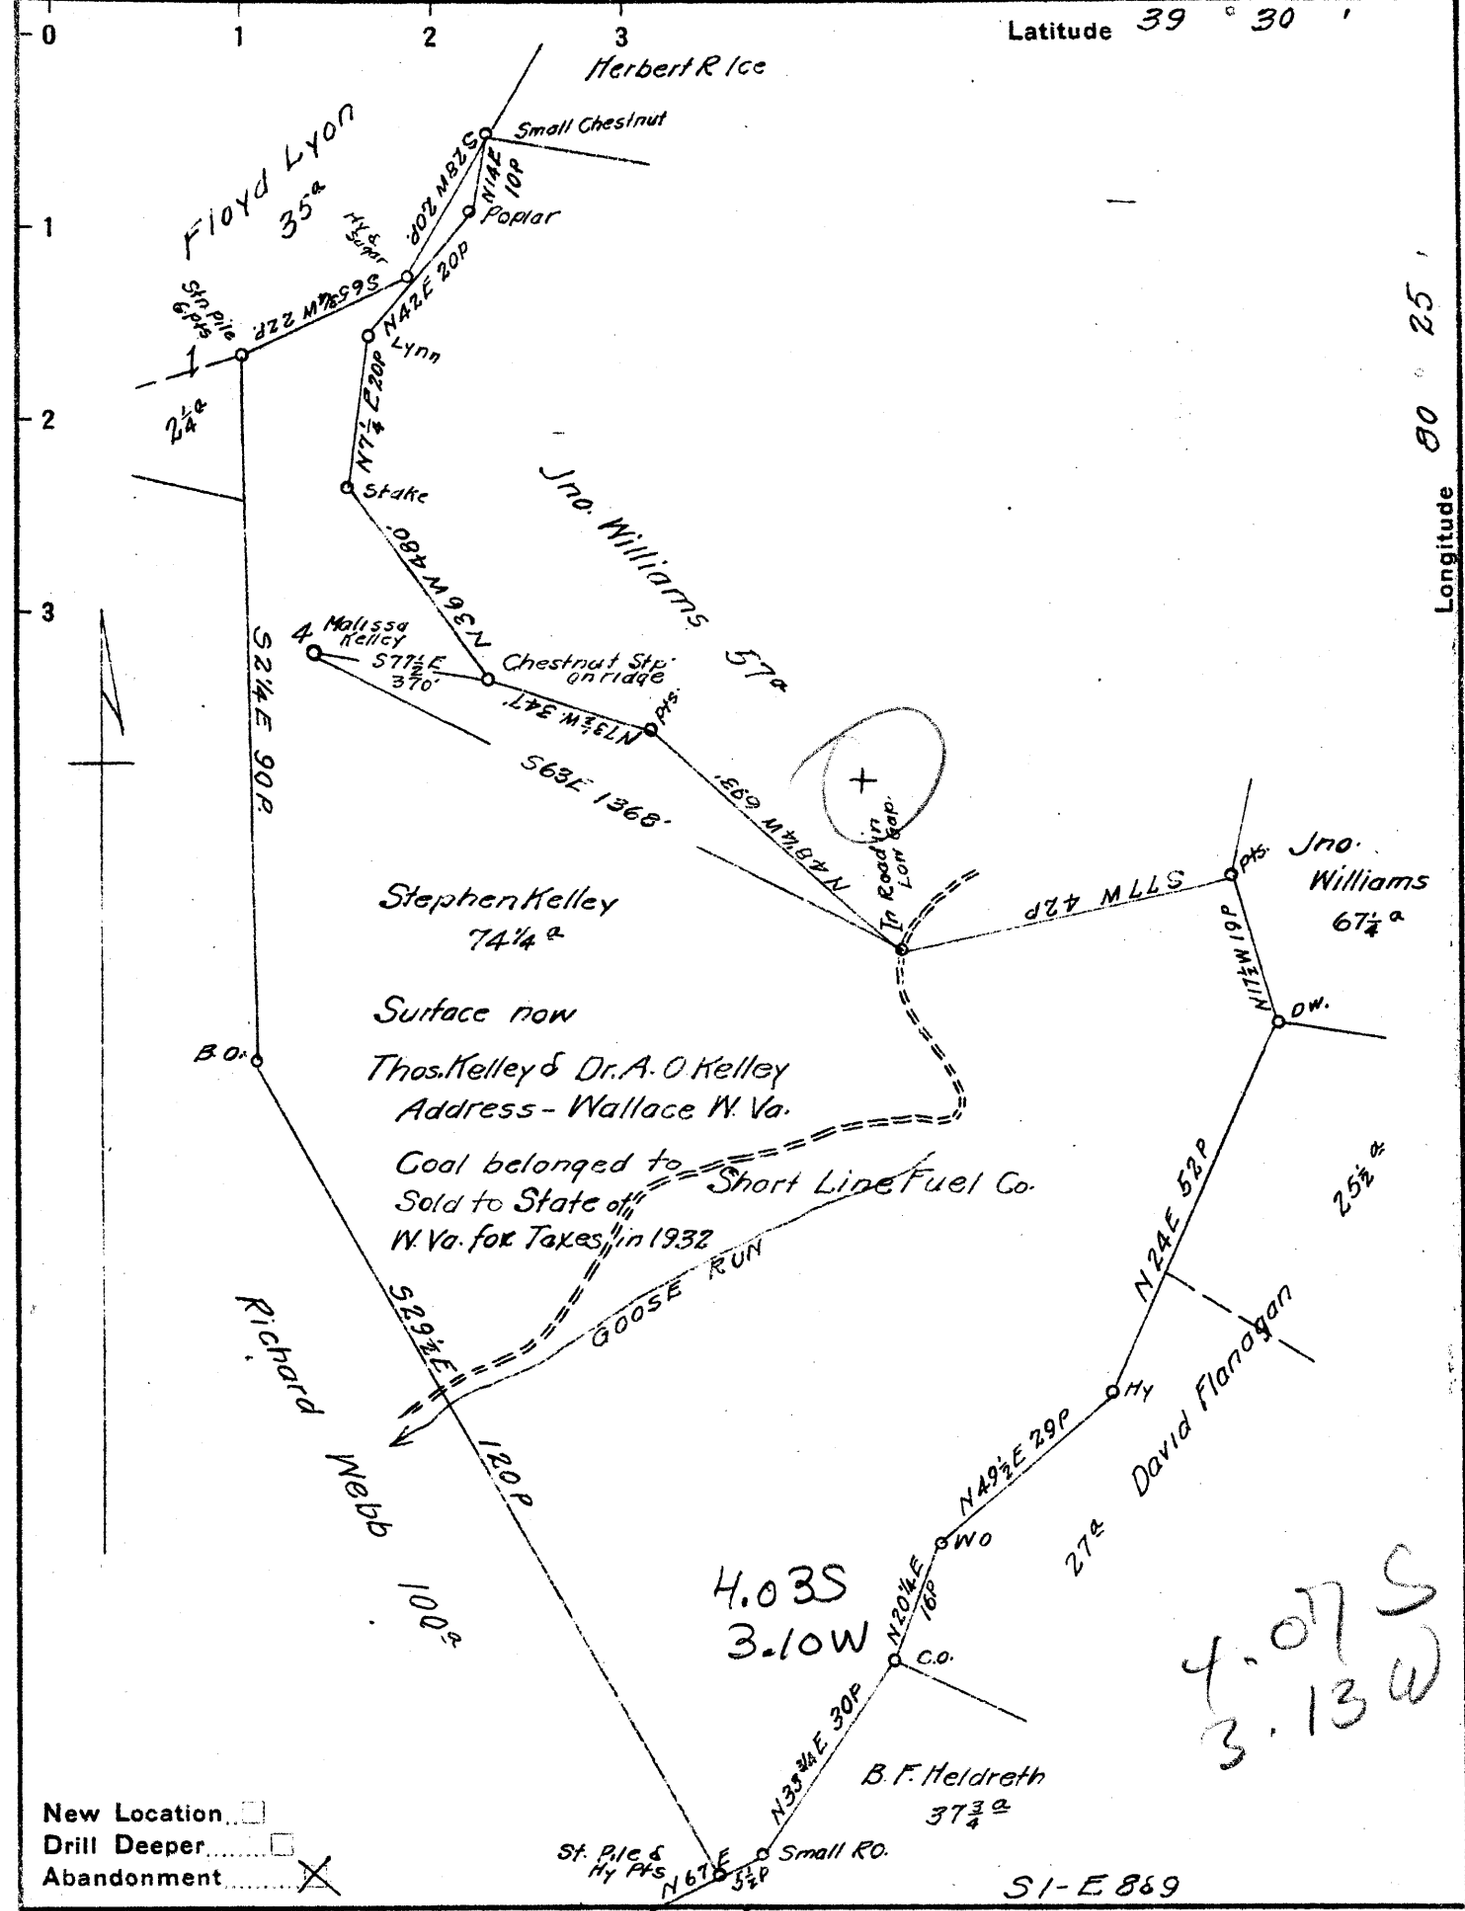

New Location ☐
Drill Deeper ☐
Abandonment ☒

Company South Penn Natural Gas Co.
Address Parkersburg W. Va.
Farm Malissa Kelley
Tract _____ Acres 74¼ Lease No. 37247
Well (Farm) No. 4 Serial No. –
Elevation (Spirit Level) 1437.36 D.F.
Quadrangle Clarksburg
County Harrison District Sardis
Engineer E. C. Tabler
Engineer's Registration No. _____
File No. _____ Drawing No. _____
Date July 9-1941 Scale 400'= 1"

STATE OF WEST VIRGINIA
DEPARTMENT OF MINES
OIL AND GAS DIVISION
CHARLESTON

WELL LOCATION MAP

FILE NO. HAR-684A

✚ Denotes location of well on United States Topographic Maps, scale 1 to 62,500, latitude and longitude lines being represented by border lines as shown.

— Denotes one inch spaces on border line of original tracing.