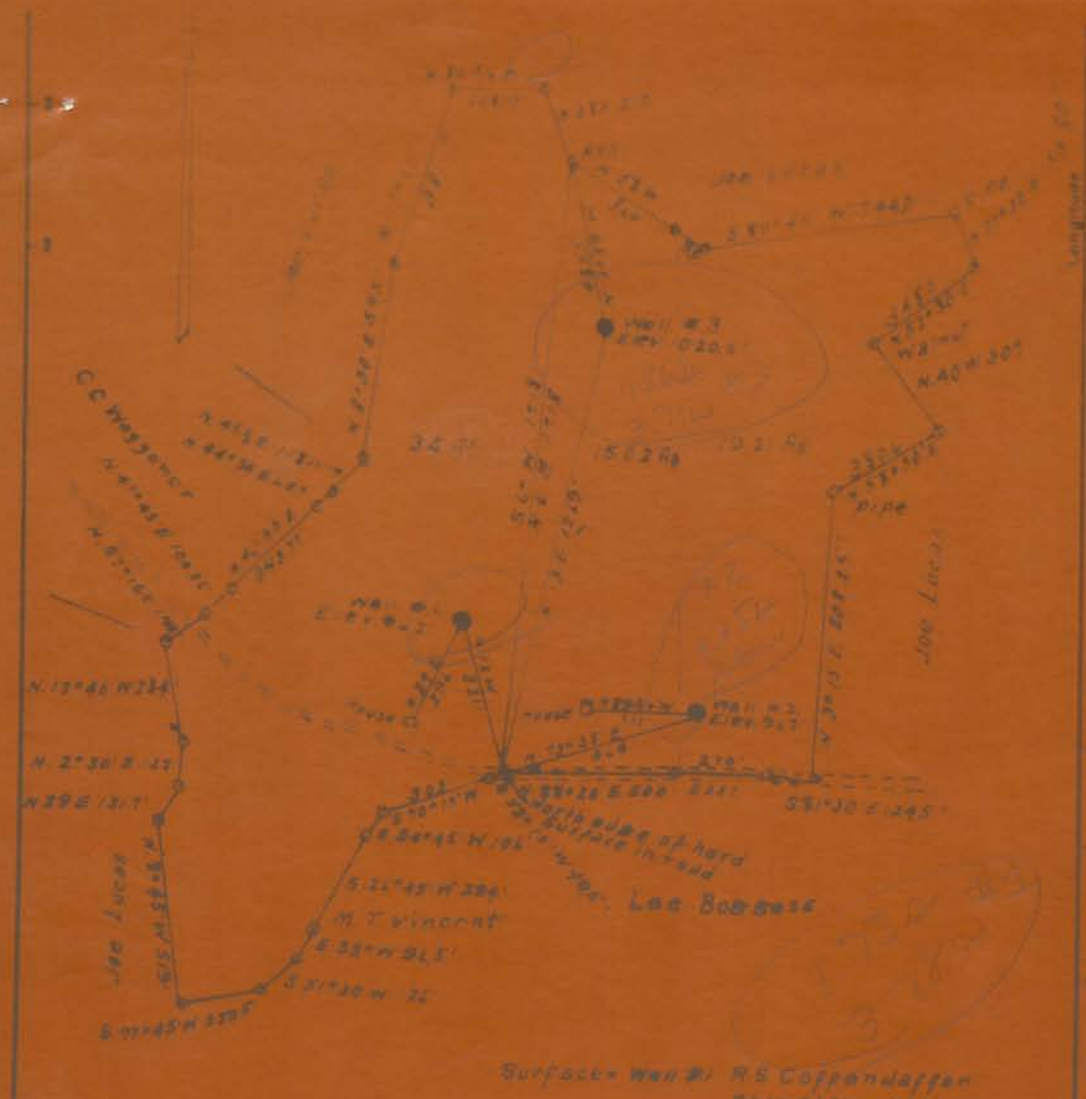

New Location ☐
Drill Deeper
Abandonment ☒

Company Dunn-Har Oil & Gas Co.
Address Waynesburg, Pa.
Farm W H Lucas
Tract 1 Acres 48 Lease No.
Well (Farm) No. 2 W-3 Serial No. 21 1131
Elevation (Spirit Level) [illegible]
Quadrangle Clarksburg
County Harrison District Clay
Engineer H L Headley
Engineer's Registration No. 2211

STATE OF WEST VIRGINIA
DEPARTMENT OF MINES
OIL AND GAS DIVISION
CHARLESTON

WELL LOCATION MAP

FILE NO: HAR-1693-A-#1
HAR-1693-A-#2
HAR-1693-A-#3

⊕ Denotes location of well on United States Topographic Maps, scale 1 to 62,500, latitude and longitude lines being represented by border lines as shown.

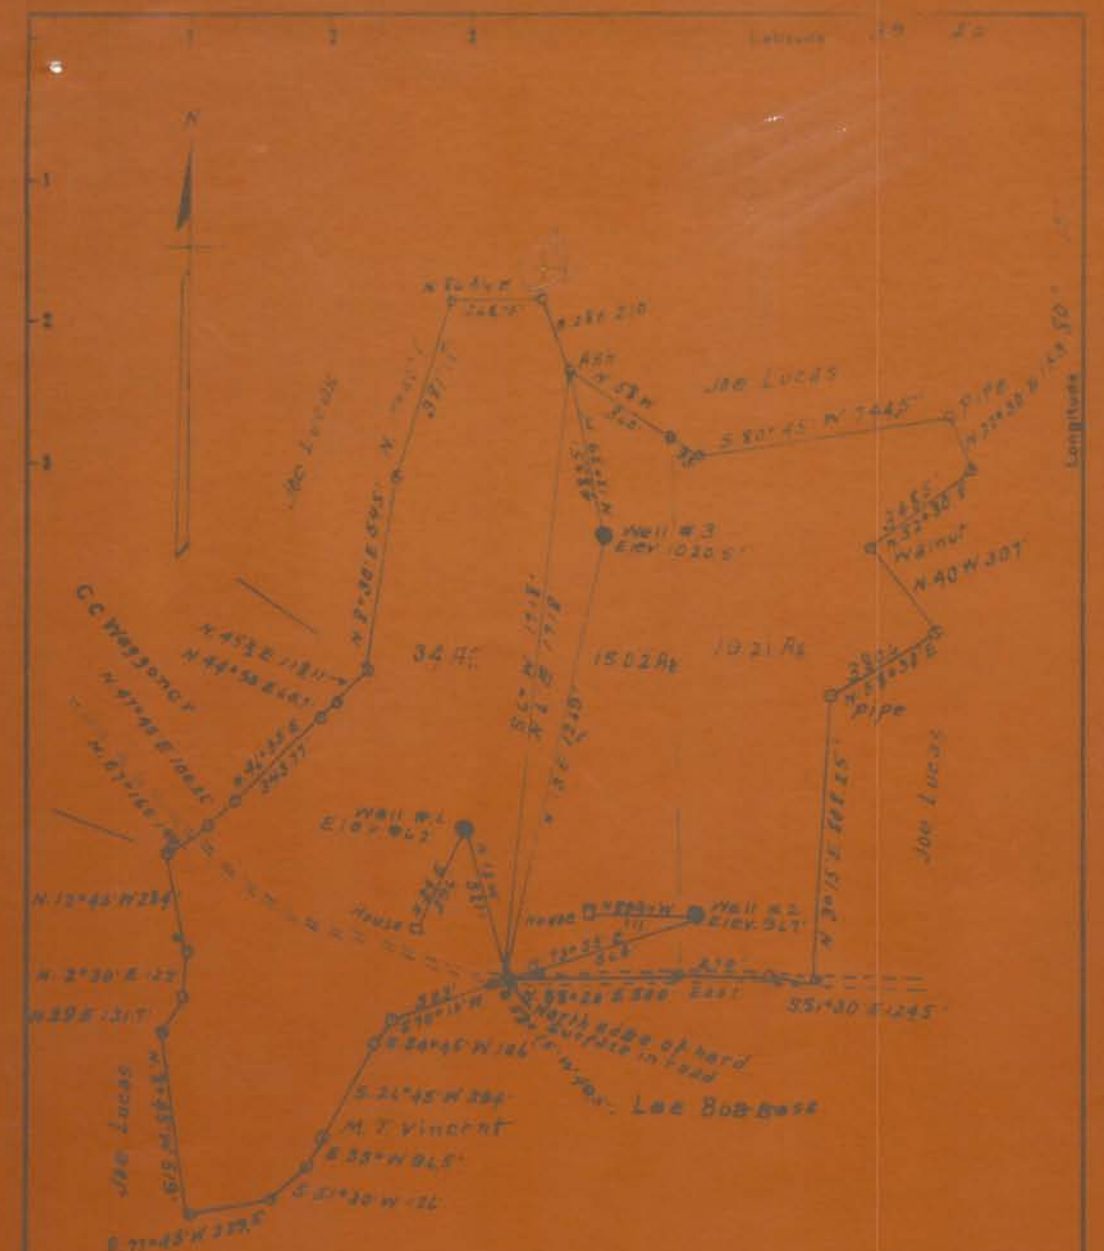
Latitude
Longitude
N
Joe Lucas
Joe Lucas
Joe Lucas
Joe Lucas
Joe Lucas
Joe Lucas
Well # 3
Well # 2
Elev. 917'
Well # 1
Elev. 910'
House
House
Pipe
Pipe
Walnut
34 Ac
15.02 Ac
10.21 Ac
M. T. Vincent
Lee Bob Bess
North edge of hard surface in road
Surface: Well #1 R S Coffendaffer
Shinston, W Va.
Wells # 2 & 3 Joseph O. Lucas
Shinston, W.Va.
Coal = Stuetzer Coal Co
Fairmont W.Va.
New Location
Drill Deeper
Abandonment
Company Dunn M&F Oil & Gas Co
Address Waynesburg, Pa.
Farm W. H. Lucas
STATE OF WEST VIRGINIA
DEPARTMENT OF MINES
OIL AND GAS DIVISION
CHARLESTON