Plot ✓ Log ✓ Card ✓ CSD ___ Mflm ___

23,000'

1,950'

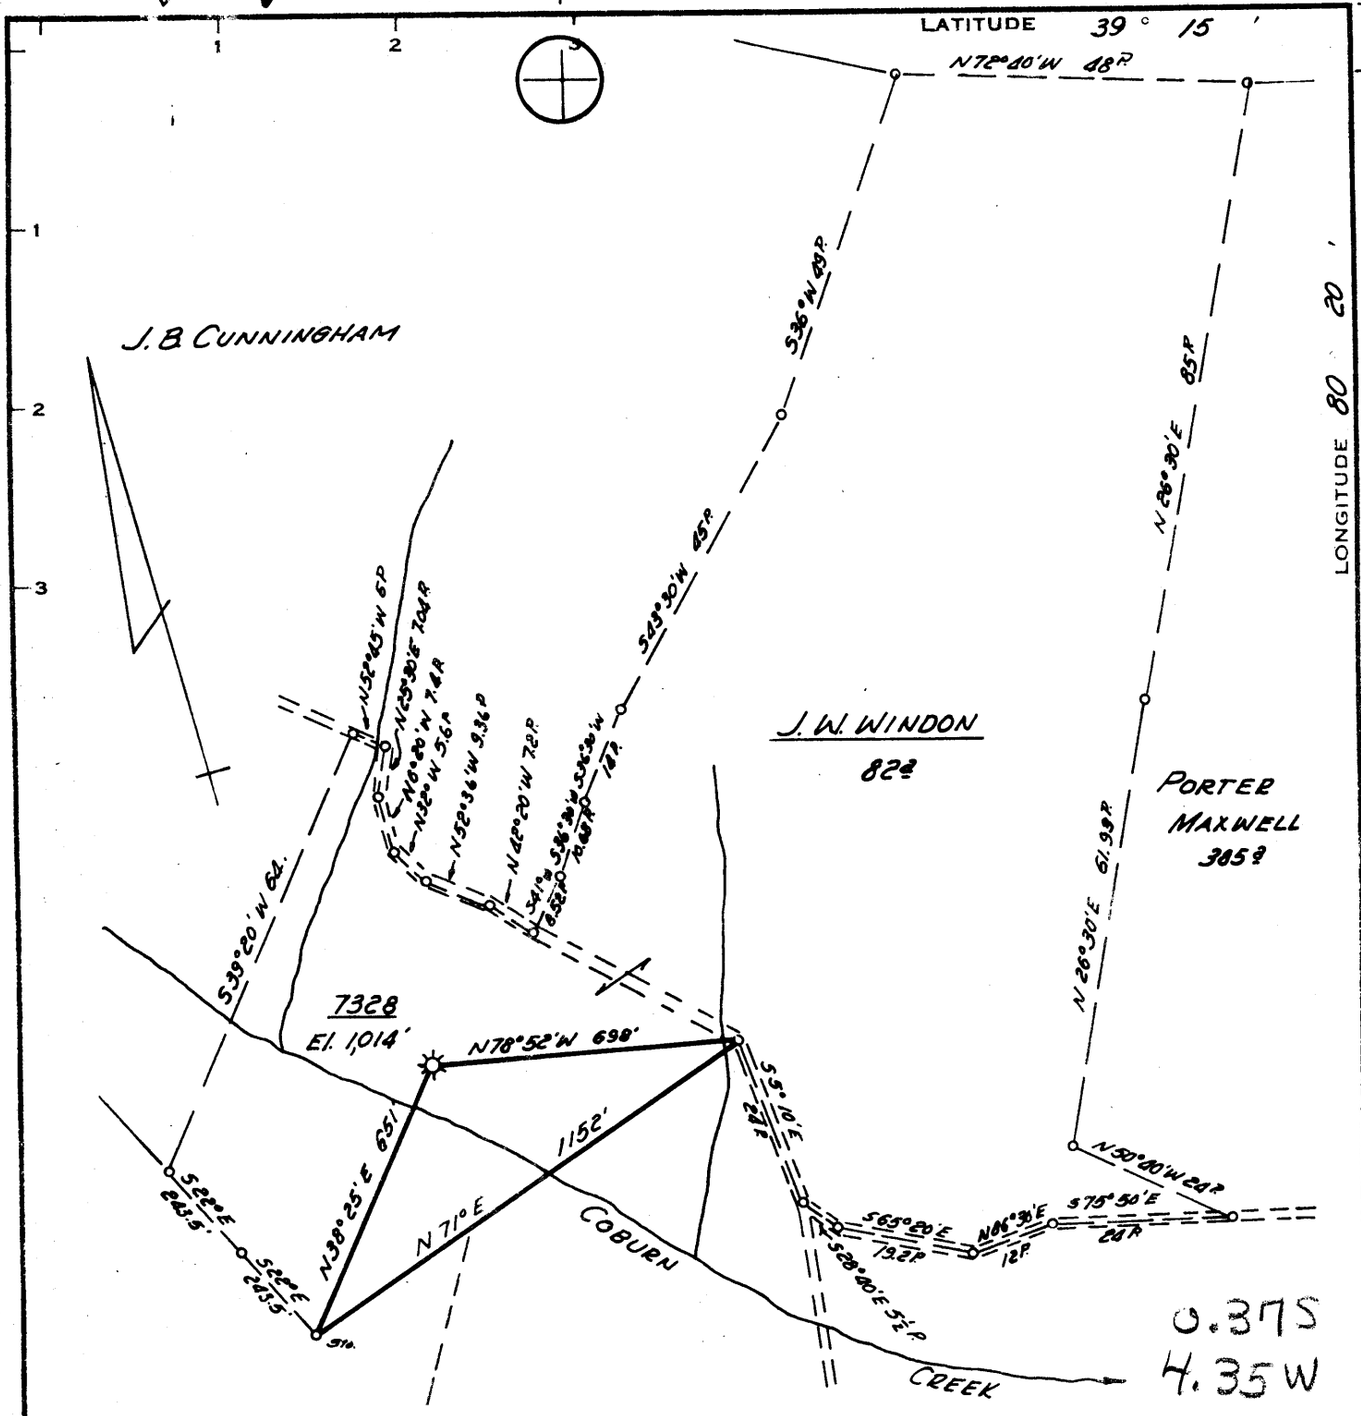

Minimum Error of Closure 1' IN 200'

Source of Elevation ROAD FORK ELEVATION 1,043'

"I, the undersigned, hereby certify that this map is correct to the best of my knowledge and belief and shows all the information required by paragraph 6 of the rules and regulations of the oil and gas section of the mining laws of West Virginia."

New Location ☐
Drill Deeper ☐
Abandonment ☒ 6/10/76

MAP SHEET 55 S 13 E 11 F.B. 506 Pg. 26

Company CONSOLIDATED GAS SUPPLY CORP
Address CLARKSBURG W. VA
Farm J. W. WINDON
Tract ___ Acres 82 Lease No. 44542
Well (Farm) No. ___ Serial No. 7328
Elevation (Spirit Level) 1014'
Quadrangle WESTON NC
County HARRISON District UNION
Engineer Jackson M. Jarvis
Engineer's Registration No. 2397
File No. ___ Drawing No. ___
Date JUNE 8, 1976 Scale 1" = 400'

STATE OF WEST VIRGINIA
DEPARTMENT OF MINES
OIL AND GAS DIVISION
CHARLESTON

WELL LOCATION MAP

FILE NO. HAR-1983-A

+ Denotes location of well on United States Topographic Maps, scale 1 to 62,500, latitude and longitude lines being represented by border lines as shown.

— Denotes one inch spaces on border line of original tracing.

47-033 JUN 18 1976

FORM 1328