Plot ✓ Log ✓ Card ✓ CSD ___ Mflm ___

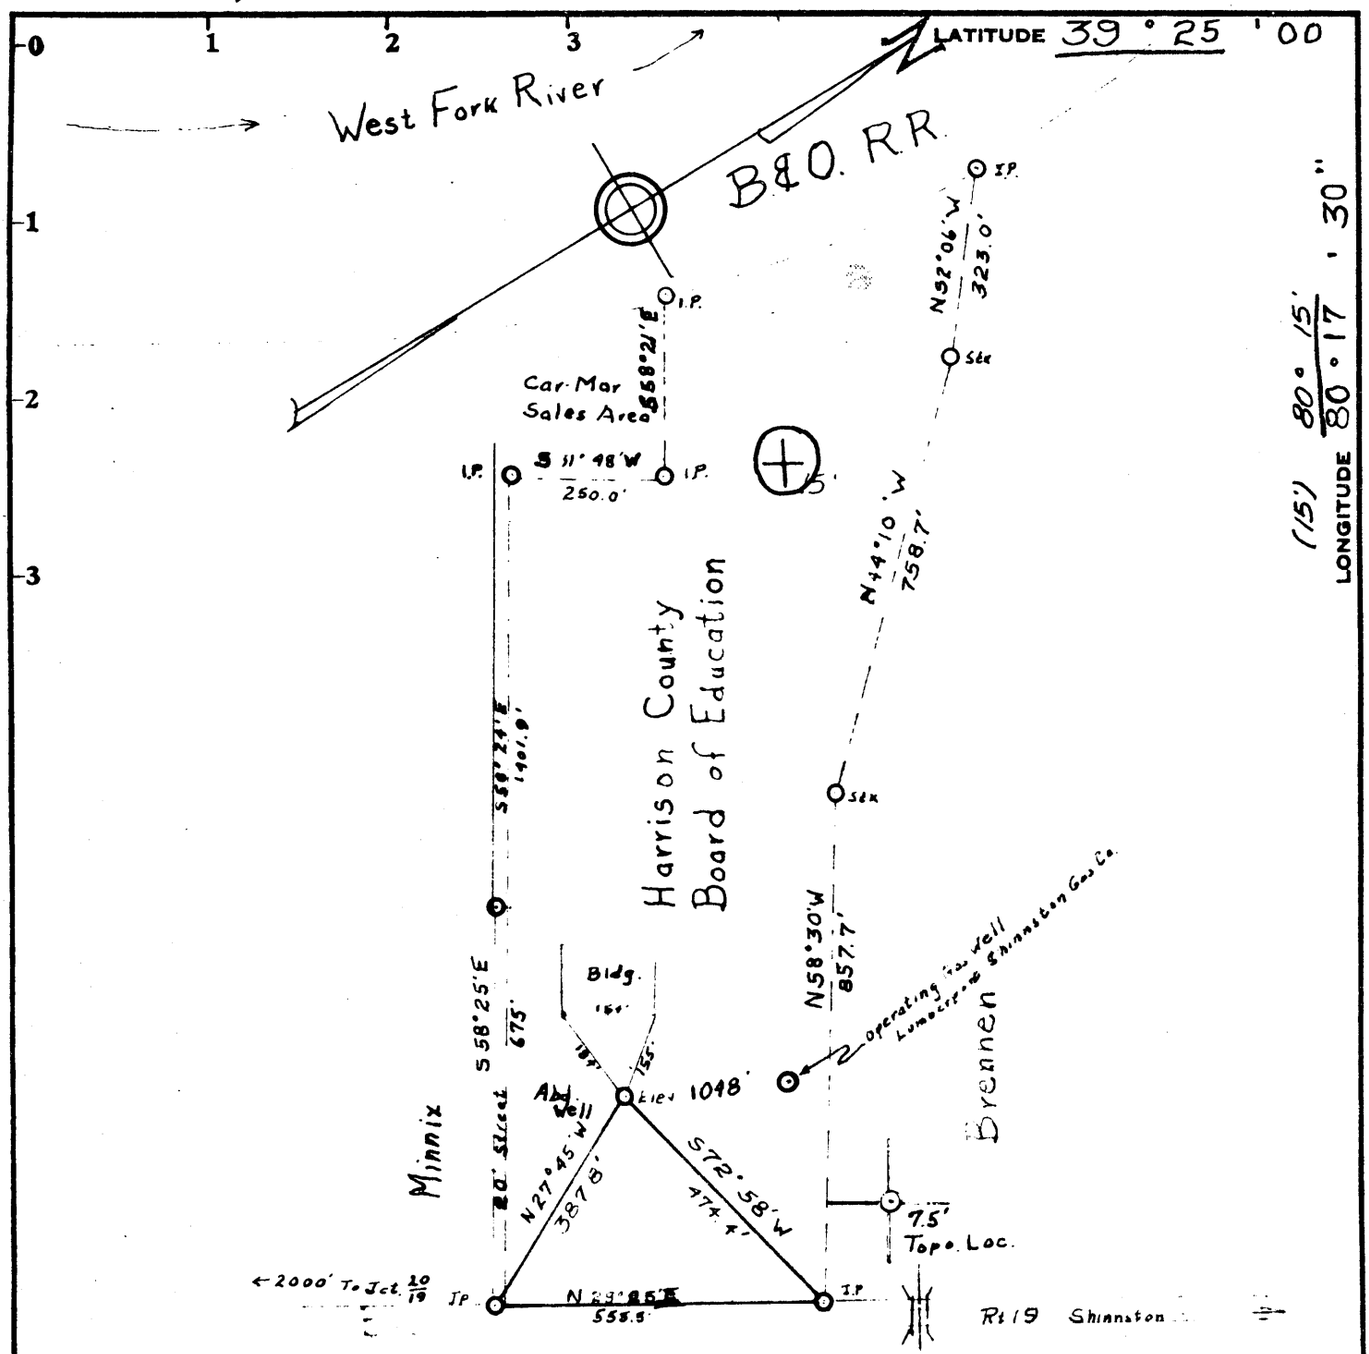

2.50S
3.68W

Minimum Error of Closure 1-500

Source of Elevation Culvert : 160' N.E of Property on Rt 19

I, the undersigned, hereby certify that this map is correct to the best of my knowledge and belief and shows all the information required by paragraph 6 of the rules and regulations of the oil and gas ction of the mining laws of West Virginia.

Signed: Robert L Todd

Fracture ☐
New Location ☐
Drill Deeper ☐
REDRILL &
Abandonment ☒ 10/26/76

Map No. Sq E W

Company W. Va. Dept. of Mines - Oil & GAS Div.
Address Charleston, W. Va.
Farm Shinnston - Lumberport High School
Tract Acres 2.149 Lease No.
Well (Farm) No. 1 Serial No.
Elevation (Spirit Level) 1048' EC
Quadrangle Shinnston - 7.5' Clarksburg 15
County Harrison District Eagle
Engineer Robert L Todd
Engineer's Registration No. 6459
File No. Drawing No.
Date 12-21-76 Scale 1" 300'

STATE OF WEST VIRGINIA
DEPARTMENT OF MINES
OIL AND GAS DIVISION
CHARLESTON

WELL LOCATION MAP

FILE NO. HAR-1987-A

+ Denotes location of well on United States Topographic Maps, scale 1 to 62,500, latitude and longitude lines being represented by border lines as shown.

— Denotes one inch spaces on border line of original tracing.

47-033 JAN 13 1977

TRASCO 17 5153 1-73 54291•