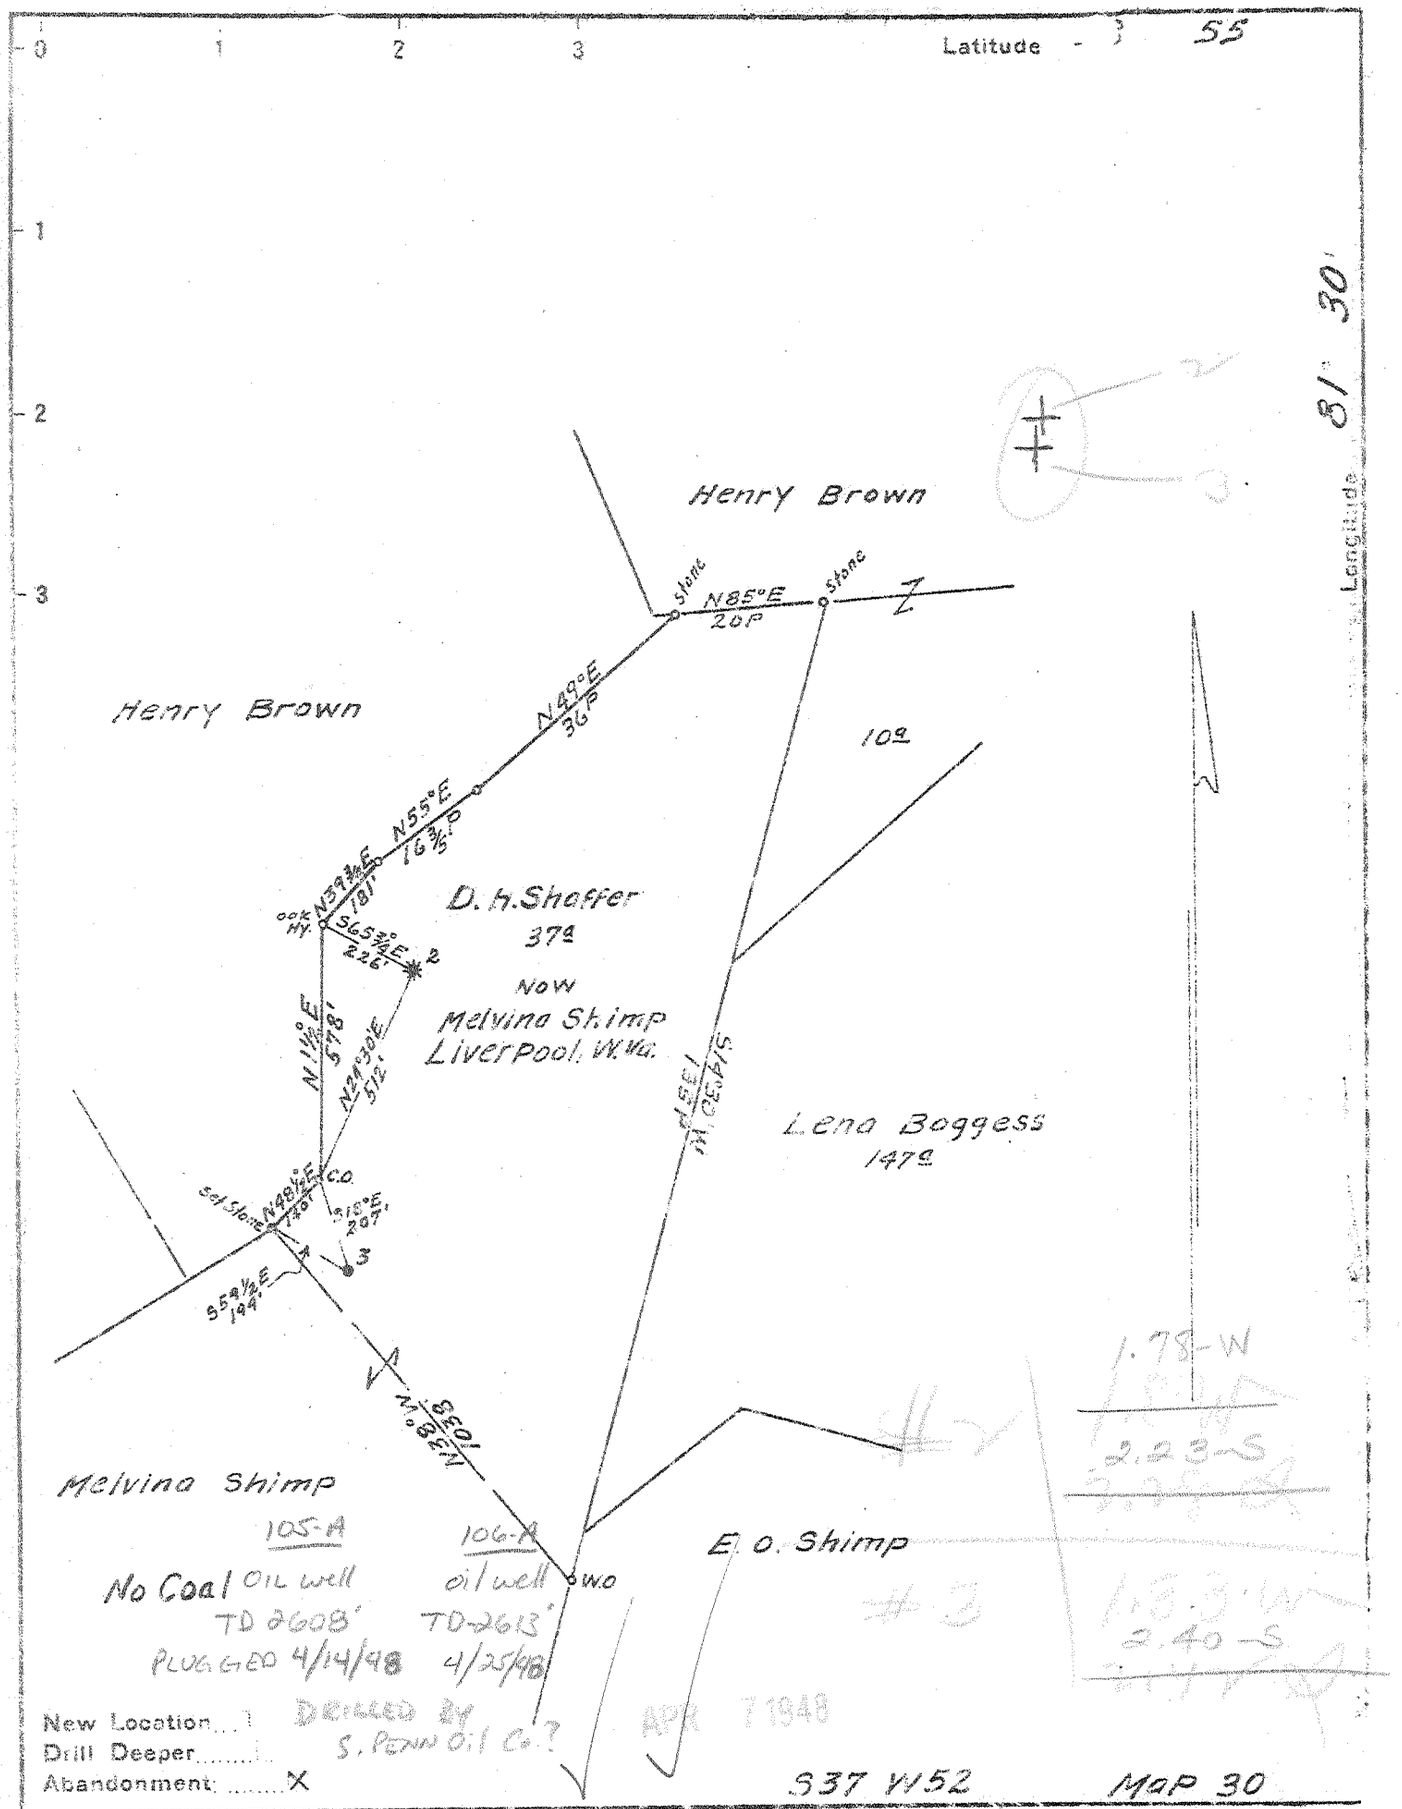

New Location ..... DRILLED BY S. PENN OIL CO.? APR 7 1948

Drill Deeper .....

Abandonment: X

S37 W52 Map 30

Company A. R. Kelly

Address Parkersburg, W. Va.

Farm D. H. Shaffer

Tract ____ Acres 37a Lease No. ____

Well (Farm) No. 2 & 3 Serial No. ____

Elevation (Spirit Level) (2) 947.0 Ft. (3) 960.5 Ft.

Quadrangle Ripley

County Jackson District Ravenswood

Engineer Wm. D. Hayes

Engineer's Registration No. 1429

File No. ____ Drawing No. ____

Date Feb. 24, 1948 Scale 1" = 400'

STATE OF WEST VIRGINIA
DEPARTMENT OF MINES
OIL AND GAS DIVISION
CHARLESTON

WELL LOCATION MAP

FILE NO. JAC-105-A-#2
JAC-106-A-#3

+ Denotes location of well on United States Topographic Maps, scale 1 to 62,500, latitude and longitude lines being represented by border lines as shown.

— Denotes one inch spaces on border line of original tracing.

Liverpool (16)

D. H. SHAFFER #2 & 3 — A. R. KELLY — JAC-105-6-A