

WW-7  
8-30-06



West Virginia Department of Environmental Protection  
Office of Oil and Gas  
**WELL LOCATION FORM: GPS**

API: 47-39-05644 WELL NO.: 825370  
 FARM NAME: University of Charleston, Inc.  
 RESPONSIBLE PARTY NAME: University of Charleston, Inc.  
 COUNTY: Kanawha DISTRICT: Kanawha City Corp. CHARLESTON  
 QUADRANGLE: Charleston East  
 SURFACE OWNER: University of Charleston, Inc.  
 ROYALTY OWNER: University of Charleston, Inc.  
 UTM GPS NORTHING: 4243260.8  
 UTM GPS EASTING: 445637.4 GPS ELEVATION: 592'

The Responsible Party named above has chosen to submit GPS coordinates in lieu of preparing a new well location plat for a plugging permit or assigned API number on the above well. The Office of Oil and Gas will not accept GPS coordinates that do not meet the following requirements:

1. Datum: NAD 1983, Zone: 17 North, Coordinate Units: meters, Altitude: height above mean sea level (MSL) – meters.
2. Accuracy to Datum – 3.05 meters
3. Data Collection Method:

Survey grade GPS \_\_\_\_: Post Processed Differential \_\_\_\_


Real-Time Differential \_\_\_\_

Mapping Grade GPS \_\_\_\_: Post Processed Differential \_\_\_\_


Real-Time Differential \_\_\_\_

4. **Letter size copy of the topography map showing the well location.**

I the undersigned, hereby certify this data is correct to the best of my knowledge and belief and shows all the information required by law and the regulations issued and prescribed by the Office of Oil and Gas.

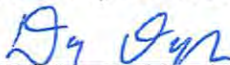 Land Manager/Conserv 05/22/2018  
 Signature Title Date



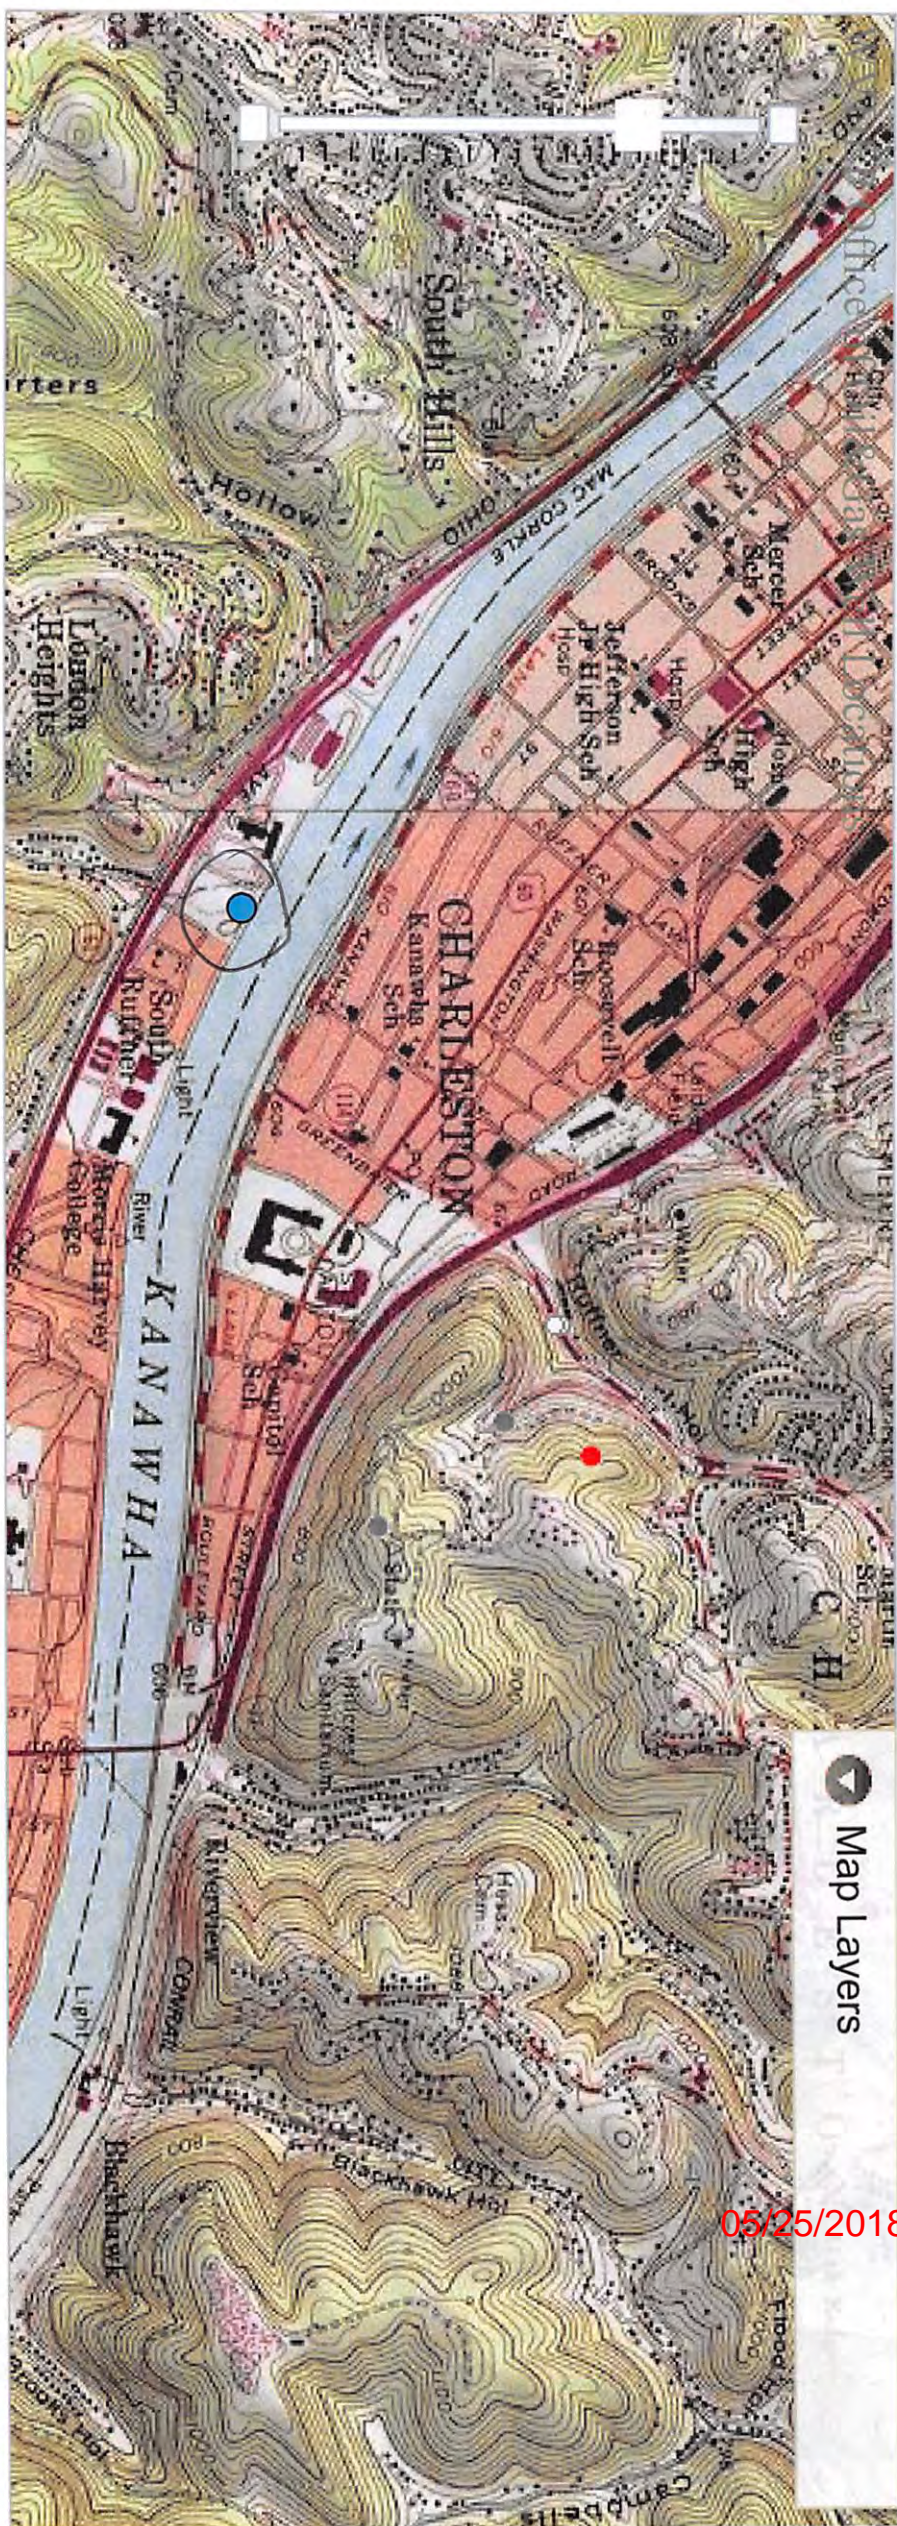

RECEIVED  
Office of Oil and Gas  
MAY 21 2018

WV Department of  
Environmental Protection

05/25/2018