49 00111 P

WW-7
8-30-06

West Virginia Department of Environmental Protection
Office of Oil and Gas
WELL LOCATION FORM: GPS

API: 47-049-00111 **WELL NO.:** WV 606132 (A. L. Blair P-6132)

FARM NAME: A. L. Blair

RESPONSIBLE PARTY NAME: EQT Production Company

COUNTY: Marion **DISTRICT:** Grant

QUADRANGLE: Shinnston 7.5'

SURFACE OWNER: Joan C. Trach, et al.

ROYALTY OWNER: A. J. Dye, et. al.

UTM GPS NORTHING: 4366270

UTM GPS EASTING: 564503 **GPS ELEVATION:** 265 m (871 ft)

The Responsible Party named above has chosen to submit GPS coordinates in lieu of preparing a new well location plat for a plugging permit or assigned API number on the above well. The Office of Oil and Gas will not accept GPS coordinates that do not meet the following requirements:

1. Datum: NAD 1983, Zone: 17 North, Coordinate Units: meters, Altitude: height above mean sea level (MSL) – meters.
2. Accuracy to Datum – 3.05 meters
3. Data Collection Method:

Survey grade GPS ____: Post Processed Differential ____
Real-Time Differential ____
Mapping Grade GPS X: Post Processed Differential X
Real-Time Differential ____

4. **Letter size copy of the topography map showing the well location.**

I the undersigned, hereby certify this data is correct to the best of my knowledge and belief and shows all the information required by law and the regulations issued and prescribed by the Office of Oil and Gas.

Signature | PS #2180 Title | 7/3/14 Date

Office of Oil and Gas
Department of Environmental Protection

4900111P

Topo Quad:	Shinnston 7.5'	Scale:	1 " = 2000'
County:	Marion	Date:	June 23, 2014
District:	Grant	Project No:	74-18-00-08

47-049-00111 WV 606132 (A. L. Blair P-6132)

Topo

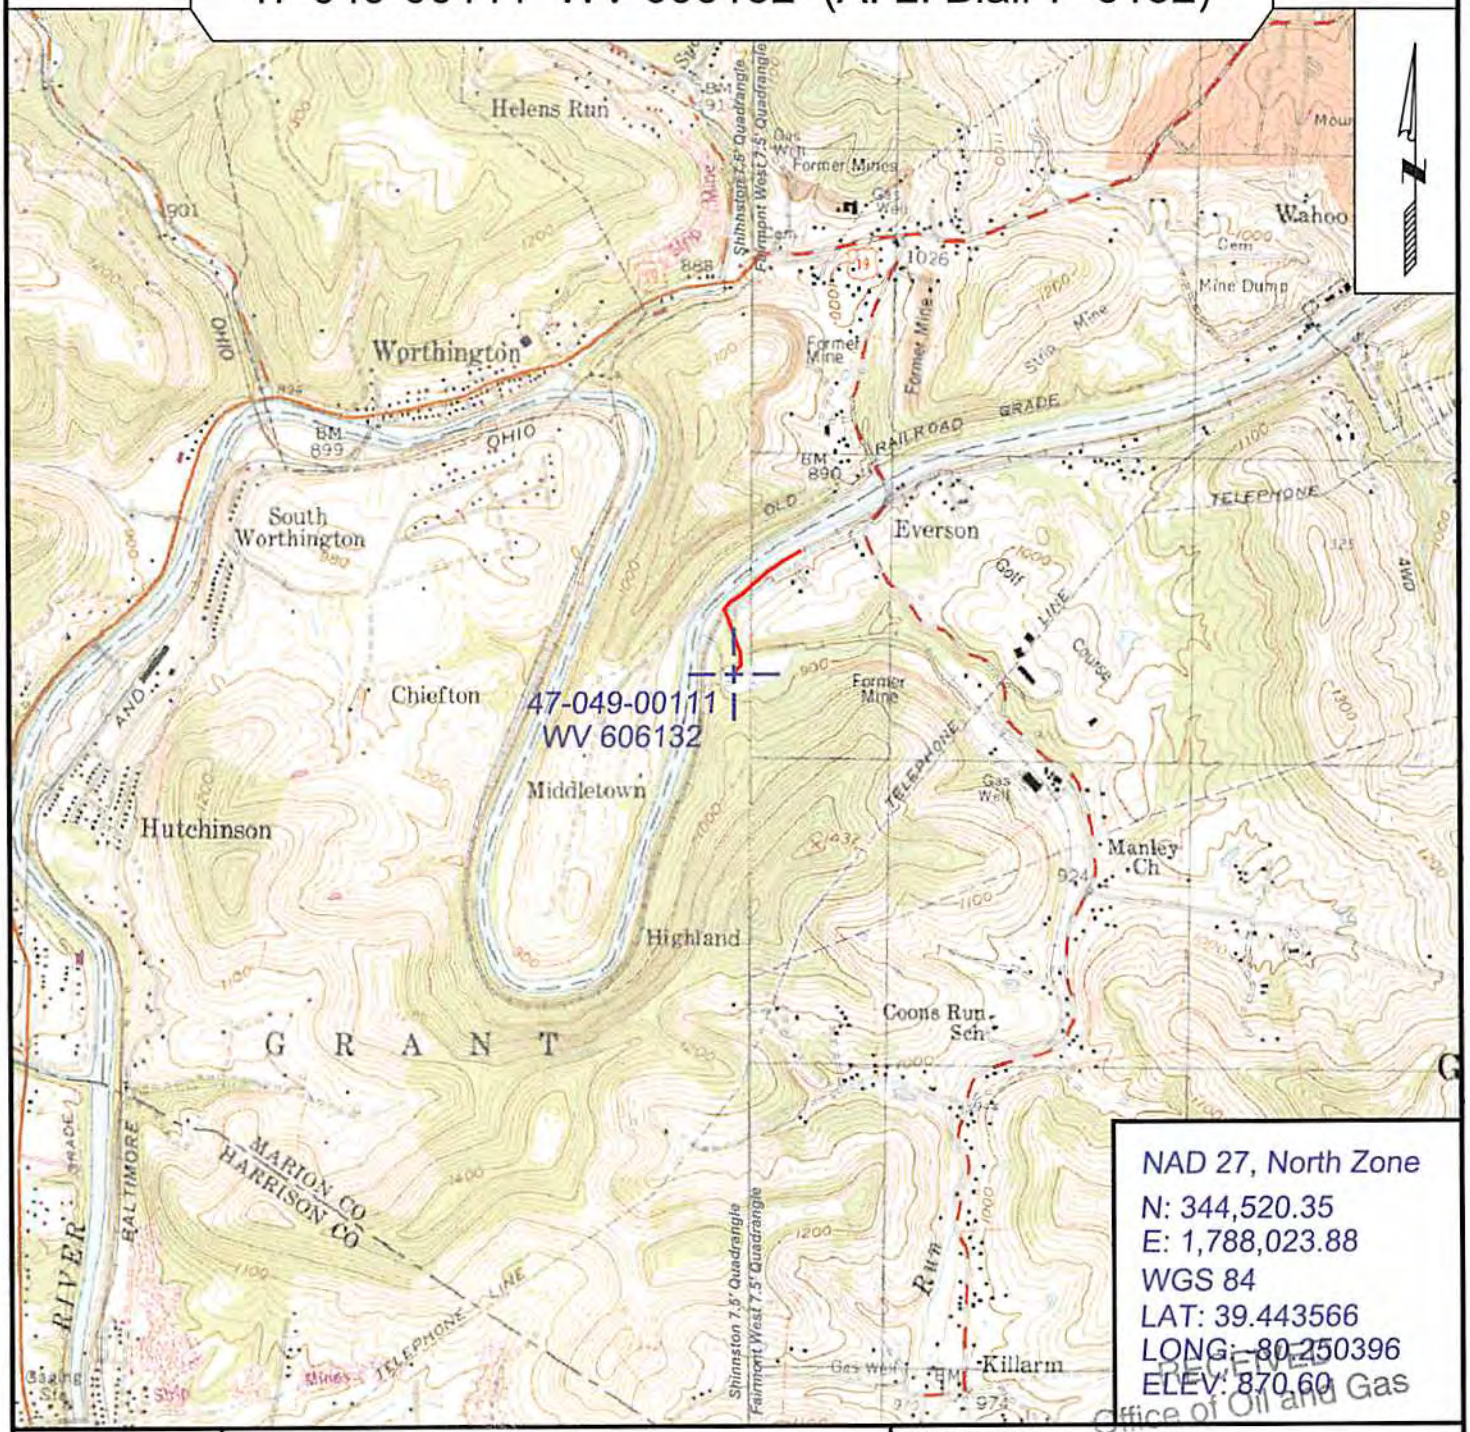

NAD 27, North Zone
N: 344,520.35
E: 1,788,023.88
WGS 84
LAT: 39.443566
LONG: -80.250396
ELEV: 870.60

RECEIVED
Office of Oil and Gas
JUL 17 2014
WV Department of
Environmental Protection

SURVEYING AND MAPPING SERVICES PERFORMED BY:
ALLEGHENY SURVEYS, INC.
1-800-482-8606
237 Birch River Road
Birch River, WV 26610
PH: (304) 649-8606
FAX: (304) 649-8608

PREPARED FOR:
EQT Production Company
P.O. Box 280
Bridgeport, WV 26330