



Diversified Gas & Oil
Corporation
100 Diversified Way
Pikeville KY, 41051




47-049-00879

Well Plugging Map

Legend

- Well
- Access Road
- Pits
- Pad
- Public Roads

RECEIVED
Office of Oil and Gas
JUL 25 2025

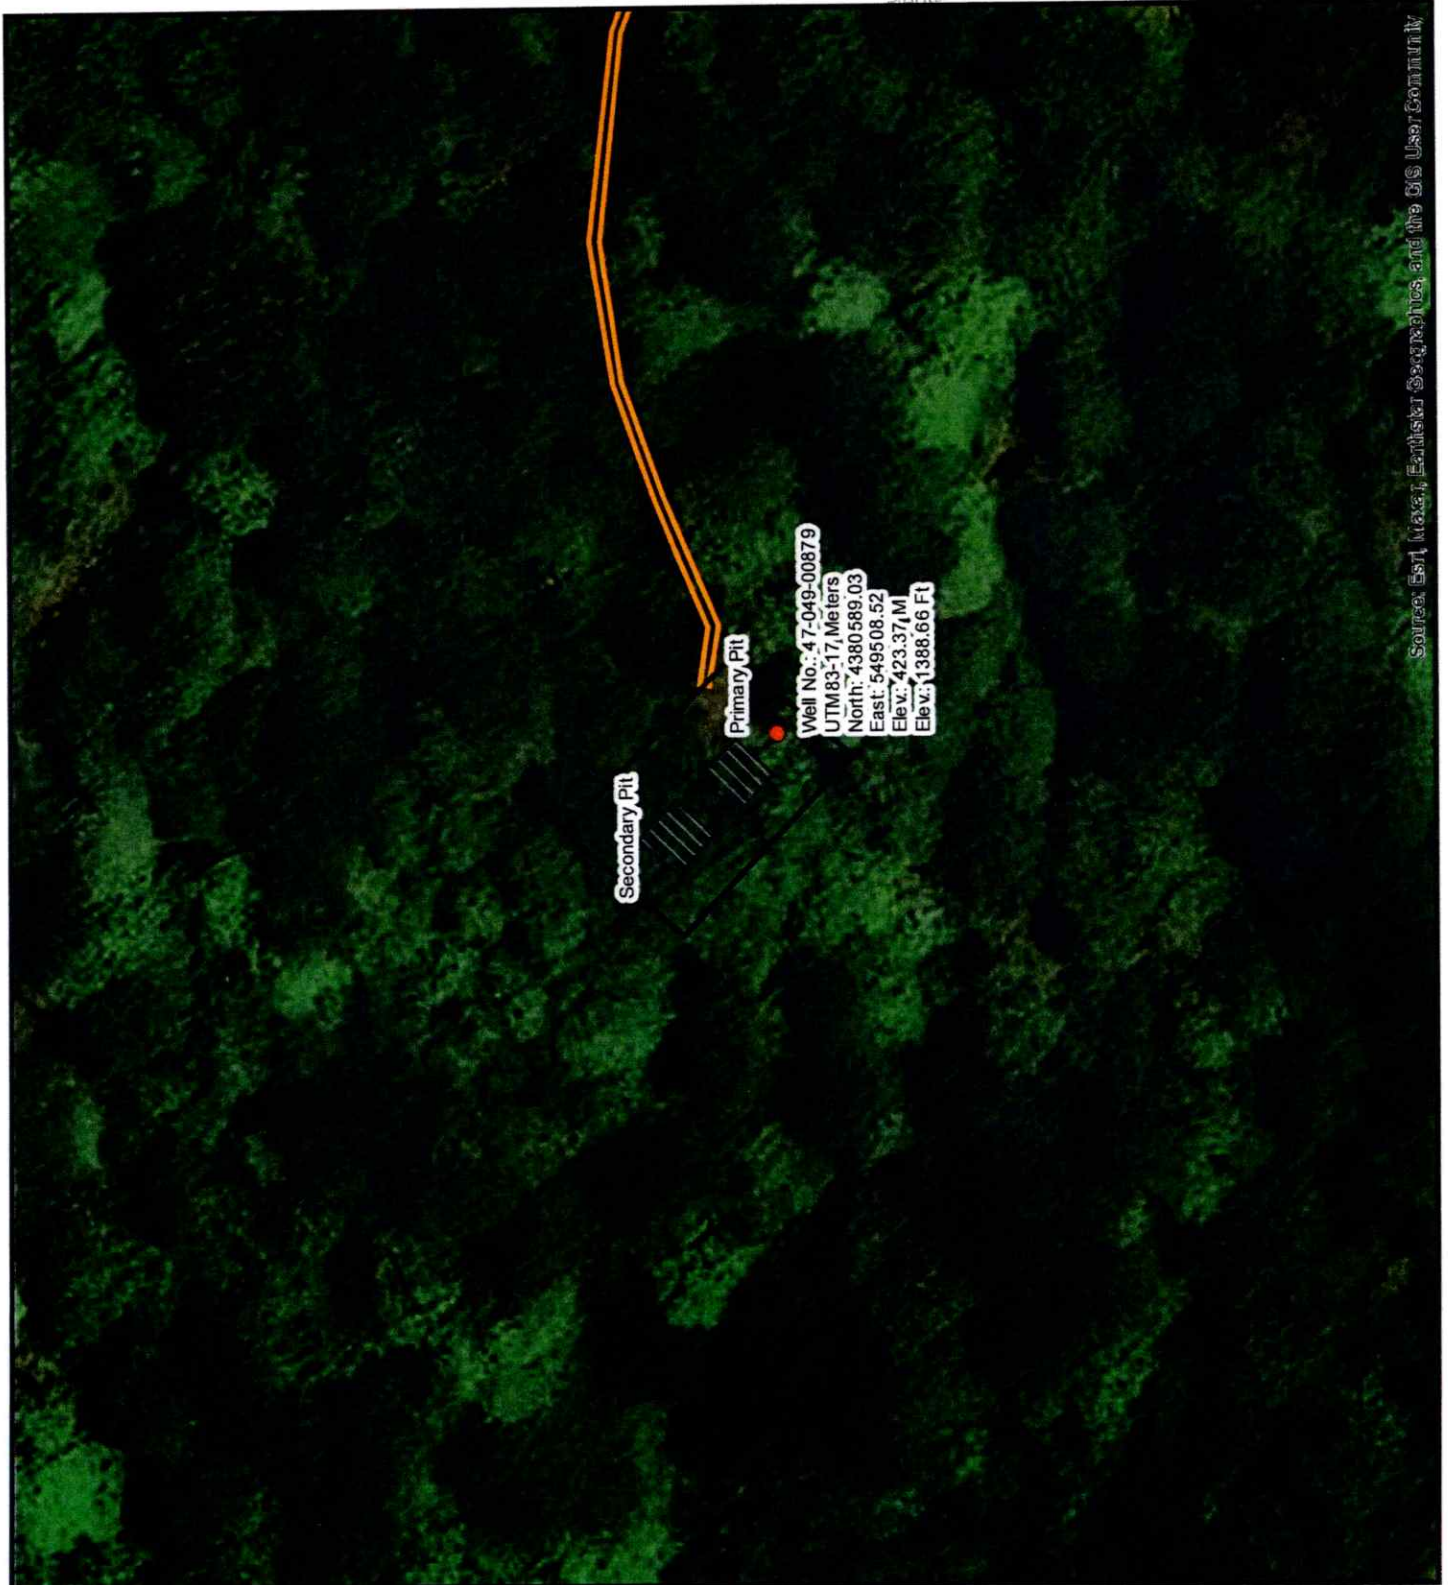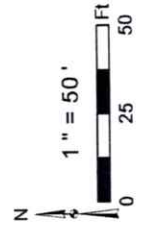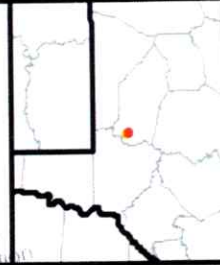

Source: Esri, Maxar, Earthstar Geographics, and the GIS User Community

08/15/2025



Diversified Gas & Oil
Corporation
100 Diversified Way
Pikeville KY, 41051


47-049-00879

Well Plugging Map


Legend

- Well
- Access Road
- Pits
- Pad
- Public Roads

RECEIVED
Office of Oil and Gas
JUL 25 2025
WV Department of
Environmental Protection

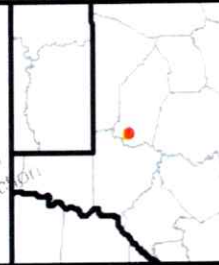

Well No.: 47-049-00879
UTM83-17 Meters
North: 4380589.03
East: 549508.52
Elev.: 423.37 M
Elev.: 1388.66 Ft

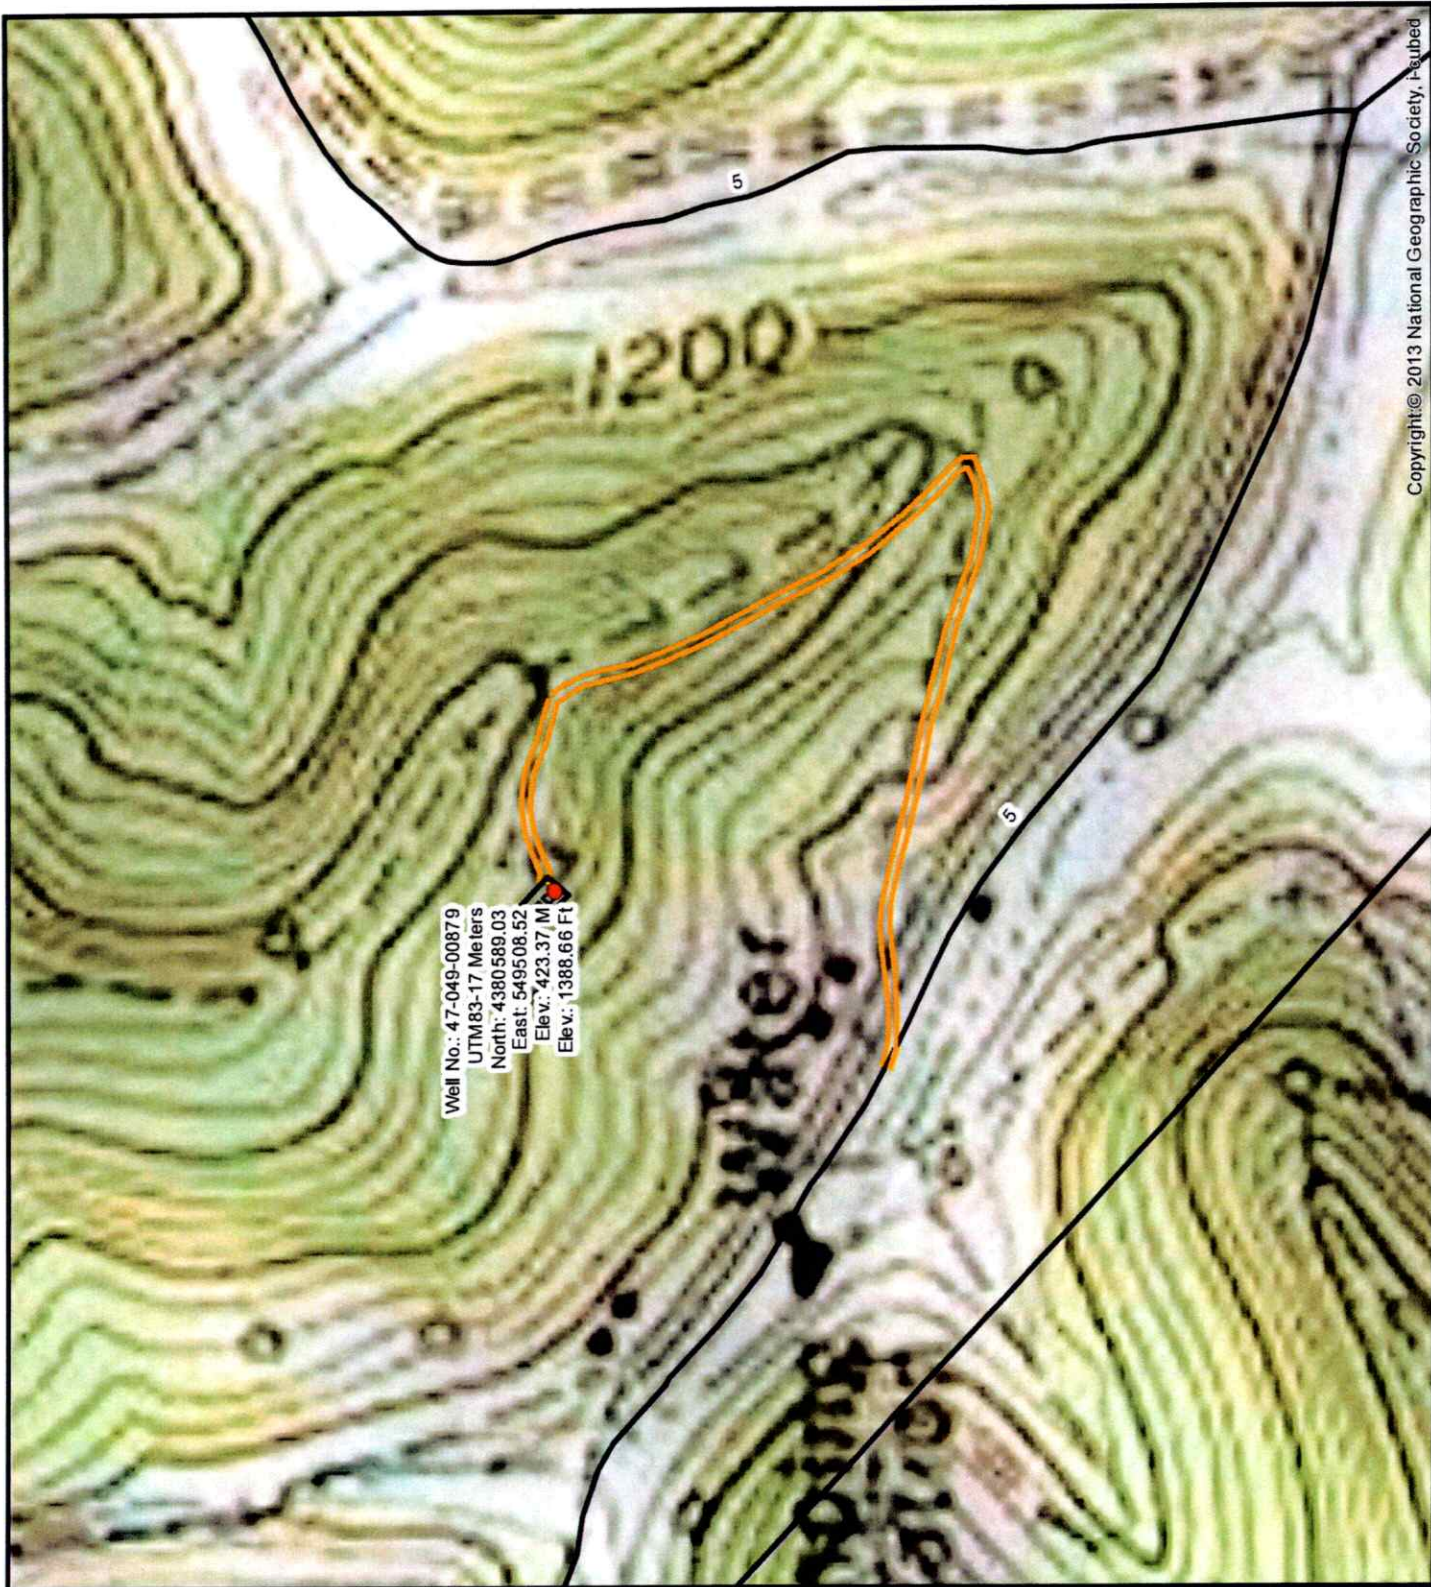

Copyright © 2013 National Geographic Society. Haubert

08/15/2025

WW-7
8-30-06



West Virginia Department of Environmental Protection
Office of Oil and Gas
WELL LOCATION FORM: GPS

API: 4704900879 WELL NO.: HAYES JL 24
FARM NAME: JL Hayes
RESPONSIBLE PARTY NAME: Diversified Production, LLC
COUNTY: Marion DISTRICT: Mannington
QUADRANGLE: Glover Gap 7.5'
SURFACE OWNER: Patricia Ann Carman
ROYALTY OWNER: ET Blue Grass, LLC
UTM GPS NORTHING: 4380589.03
UTM GPS EASTING: 549508.52 GPS ELEVATION: 1388.66'

The Responsible Party named above has chosen to submit GPS coordinates in lieu of preparing a new well location plat for a plugging permit or assigned API number on the above well. The Office of Oil and Gas will not accept GPS coordinates that do not meet the following requirements:

1. Datum: NAD 1983, Zone: 17 North, Coordinate Units: meters, **Altitude:** height above mean sea level (MSL) – meters.
2. Accuracy to Datum – 3.05 meters
3. Data Collection Method:
Survey grade GPS ____ : Post Processed Differential ____
Real-Time Differential ____
Mapping Grade GPS X : Post Processed Differential X
Real-Time Differential ____

4. **Letter size copy of the topography map showing the well location.**
I the undersigned, hereby certify this data is correct to the best of my knowledge and belief and shows all the information required by law and the regulations issued and prescribed by the Office of Oil and Gas.

Chris Veazey
Signature

Chris Veazey - Director of Administration
Title

7/21/2025
Date

RECEIVED
Office of Oil and Gas
JUL 25 2025
WV Department of
Environmental Protection

08/15/2025