



Diversified Gas & Oil
Corporation
100 Diversified Way
Pikeville KY, 41051




47-049-00917

Plugging Map

Legend

- Well
- Access Road
- ▨ Pits
- ▭ Pad
- Public Roads

RECEIVED
Office Of Oil and Gas
FEB 4 2025
WV Department of
Environmental Protection

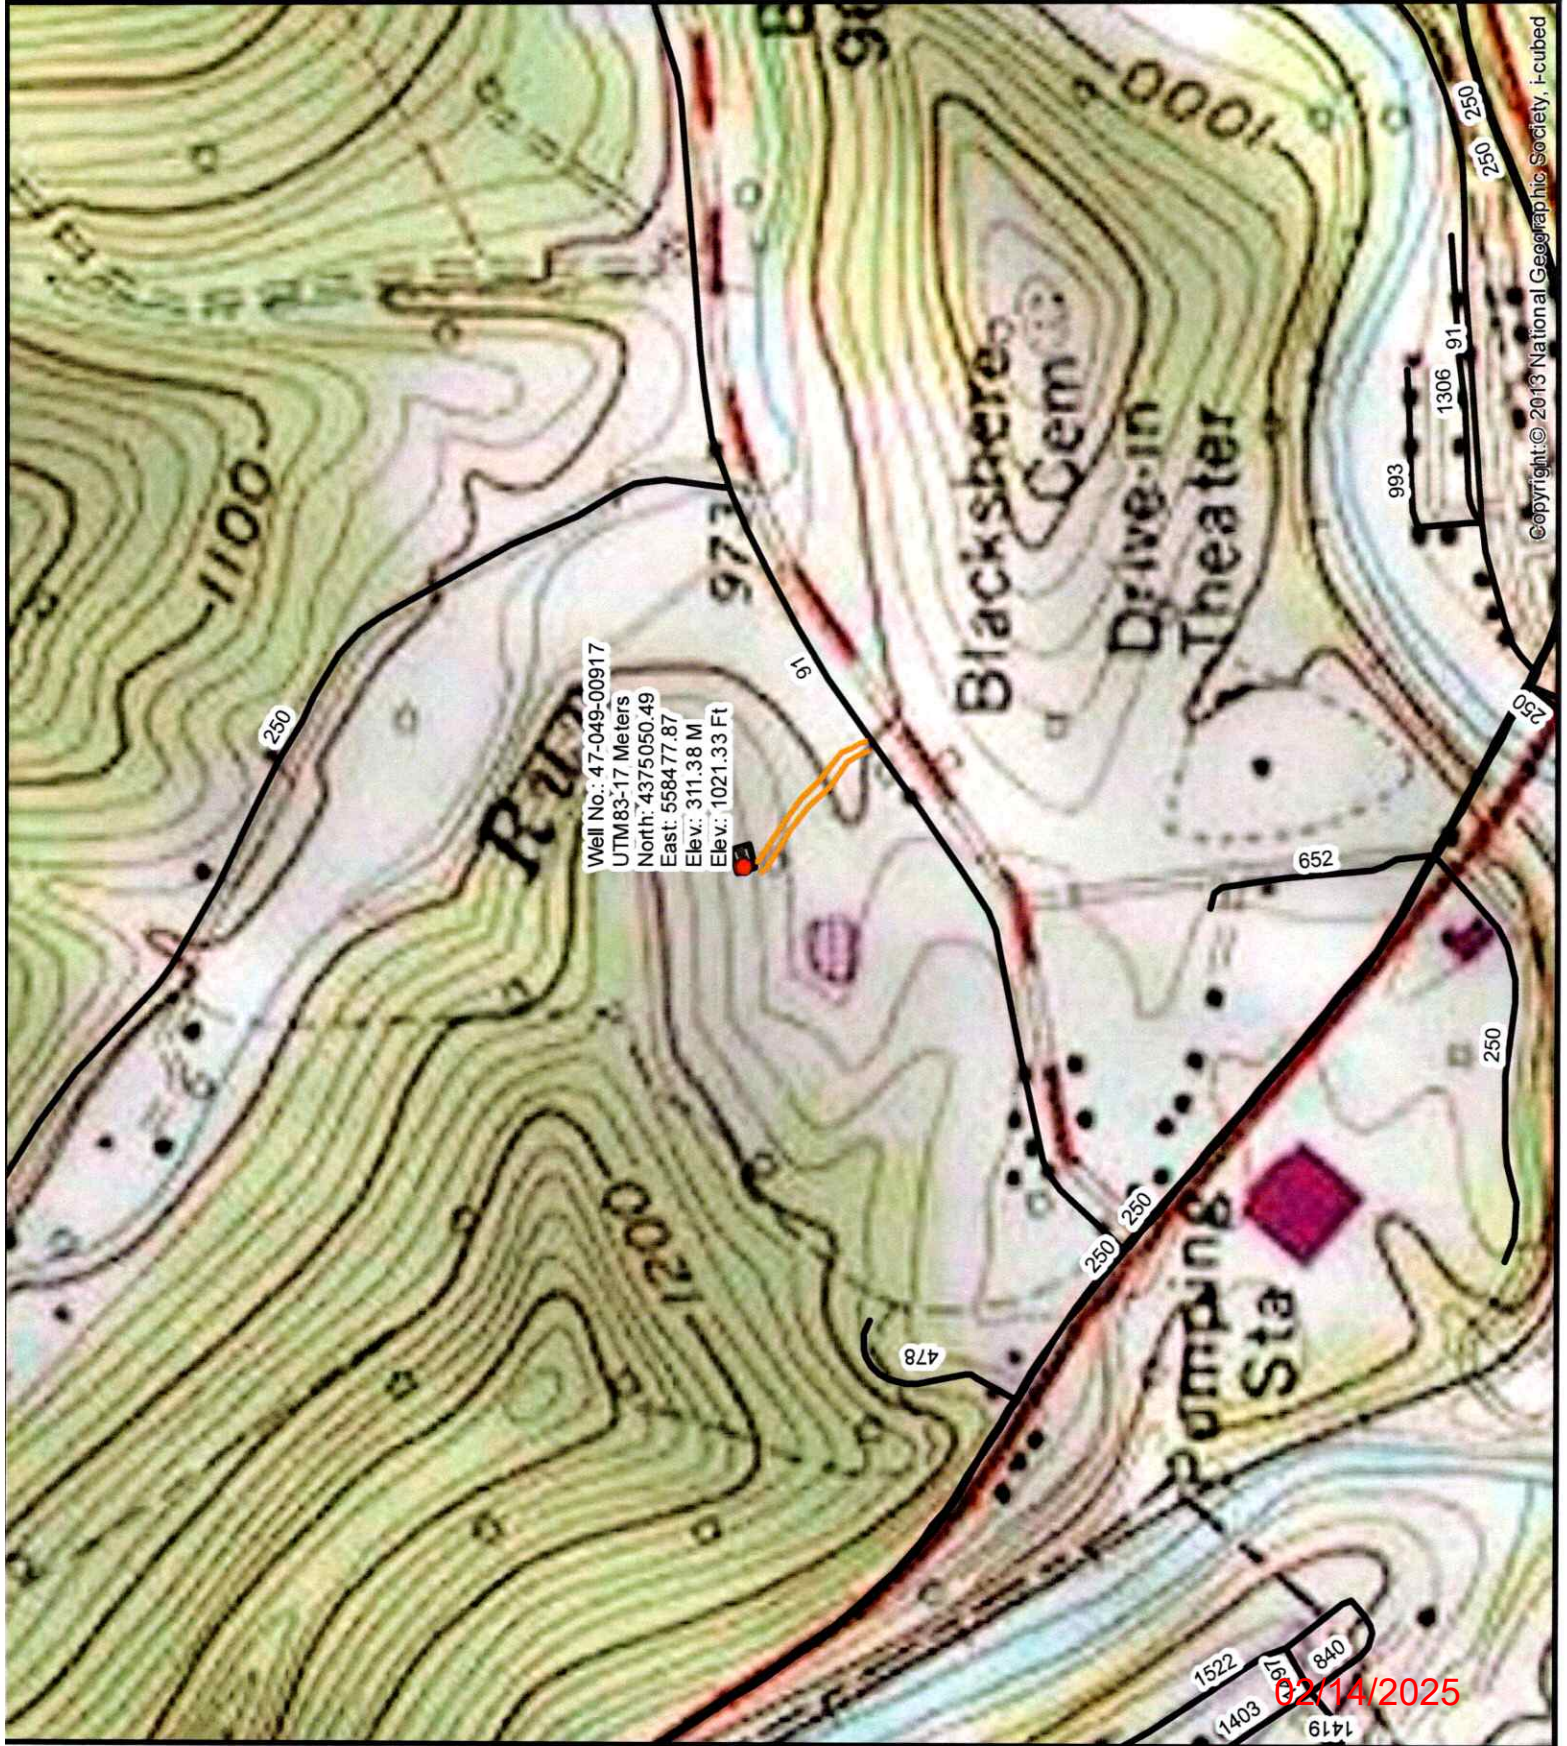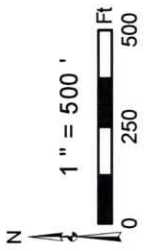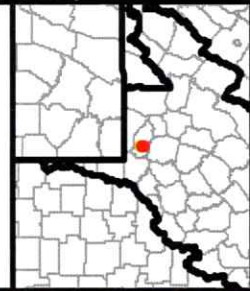

© copyright © 2013 National Geographic Society, i-cubed

02/14/2025



Diversified Gas & Oil Corporation
 100 Diversified Way
 Pikeville KY, 41051



47-049-00917

Plugging Map

Legend

- Well
- Access Road
- Pits
- Pad
- Public Roads

RECEIVED
 Office Of Oil and Gas
 FEB 4 2025
 WV Department of
 Environmental Protection

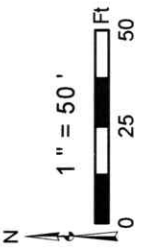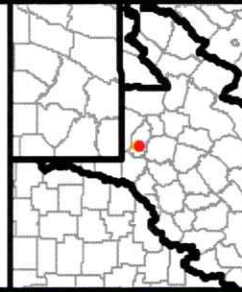

Secondary Pit

Primary Pit

Well No.: 47-049-00917
 UTM83-17 Meters
 North: 4375050.49
 East: 558477.87
 Elev.: 311.38 M
 Elev.: 1021.33 Ft

Source: Esri, Maxar, Earthstar Geographics, and the GIS User Community

02/14/2025

WW-7
8-30-06



RECEIVED
Office Of Oil and Gas
FEB 4 2025
WV Department of
Environmental Protection

West Virginia Department of Environmental Protection
Office of Oil and Gas
WELL LOCATION FORM: GPS

API: 4704900917 WELL NO.: B F BLACKSHERE 34

FARM NAME: BF Blackshere

RESPONSIBLE PARTY NAME: Diversified Production, LLC

COUNTY: Marion DISTRICT: Mannington

QUADRANGLE: Mannington 7.5'

SURFACE OWNER: Patricia Kruza & Valentin Kruza

ROYALTY OWNER: Patricia Kruza & Valentin Kruza


UTM GPS NORTHING: 4375050.49

UTM GPS EASTING: 558477.87 GPS ELEVATION: 1021.33'

The Responsible Party named above has chosen to submit GPS coordinates in lieu of preparing a new well location plat for a plugging permit or assigned API number on the above well. The Office of Oil and Gas will not accept GPS coordinates that do not meet the following requirements:

- Datum: NAD 1983, Zone: 17 North, Coordinate Units: meters, Altitude: height above mean sea level (MSL) – meters.
- Accuracy to Datum – 3.05 meters
- Data Collection Method:
Survey grade GPS : Post Processed Differential
Real-Time Differential
Mapping Grade GPS : Post Processed Differential
Real-Time Differential

4. Letter size copy of the topography map showing the well location.
I the undersigned, hereby certify this data is correct to the best of my knowledge and belief and shows all the information required by law and the regulations issued and prescribed by the Office of Oil and Gas.

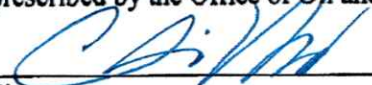
Signature

Chris Veazey - Director of Administration
Title

12/19/2024
Date