


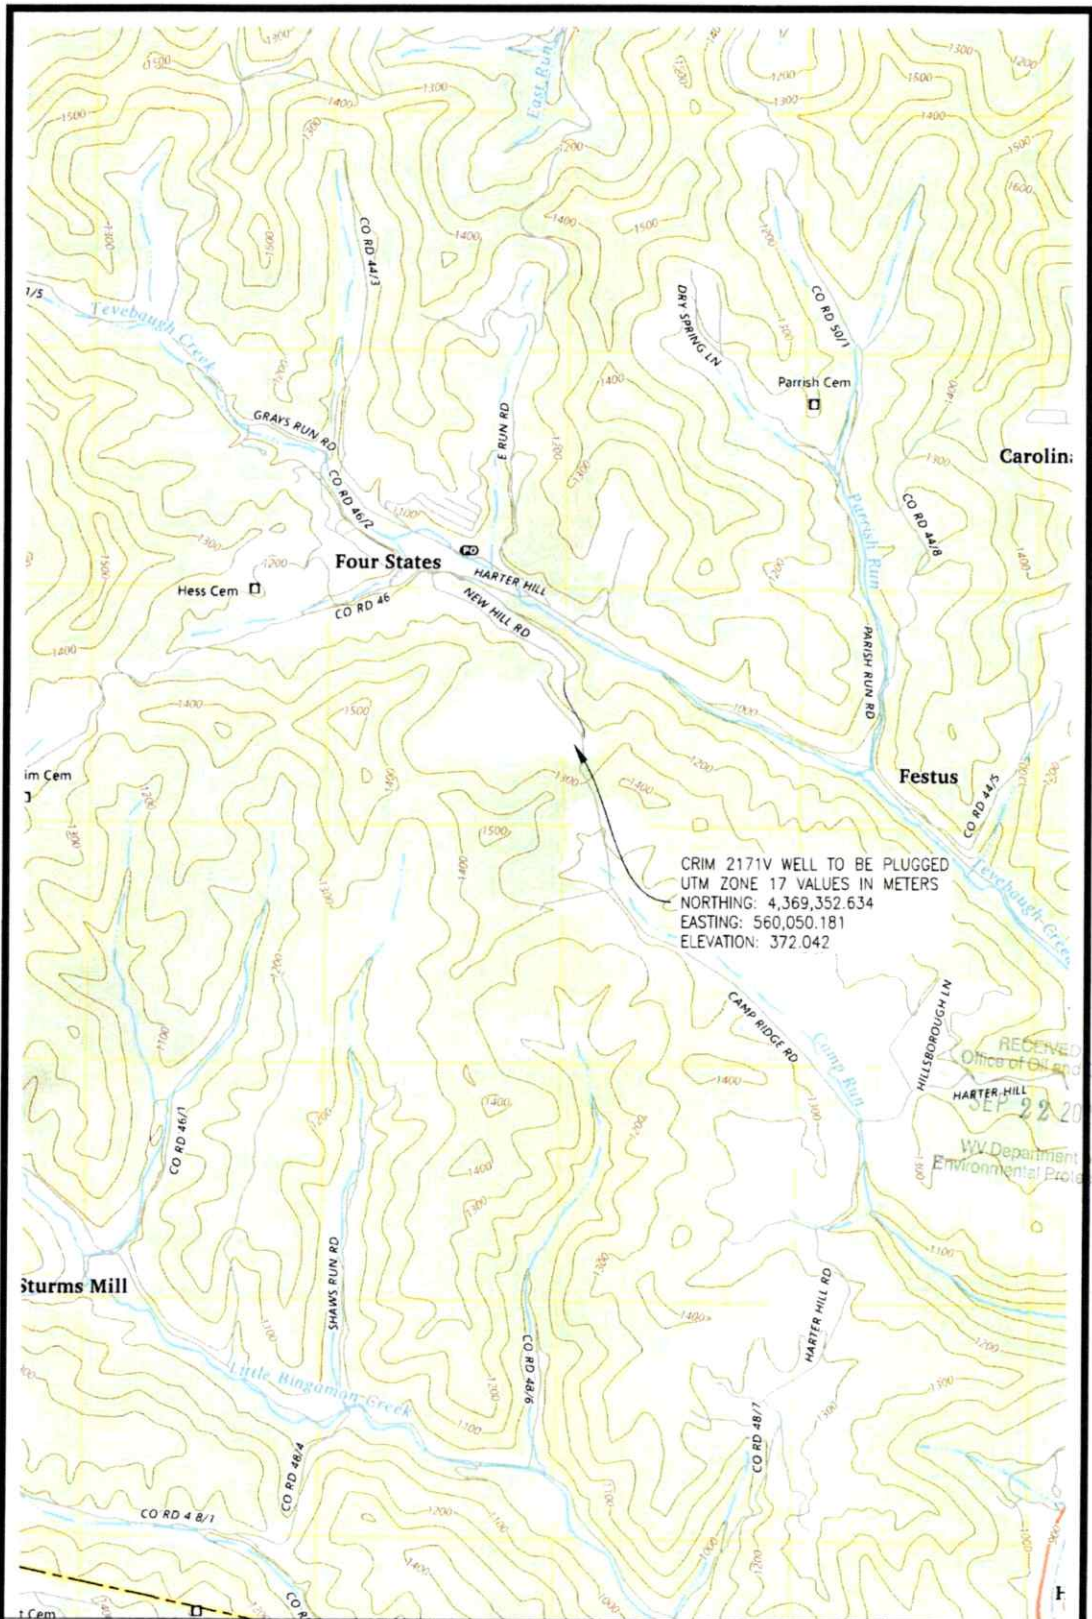

USGS MAP - SHINNSTON QUADRANGLE 2023 VERSION
CRIM 2171V (API 47-049-01993)
FOR: XTO ENERGY INC
NEW HILL ROAD, LINCOLN DISTRICT, MARION COUNTY WEST VIRGINIA

SCALE: 1" = 2000'
CONTOUR INTERVAL: 20'
SHEET NUMBER: 1 OF 1
DRAWN BY: JRV
DATE: 2/28/2025



JONES CONSULTANTS, LLC

SURVEYING • MAPPING • LAND • GAS WELL • PIPELINE
2402 PENNSYLVANIA 66 DELMONT, PA 15626
(724) 757 - 2417 www.jonesconsultant.com

10/03/2025