


4704902184



11/10/2023

WW-7
8-30-06

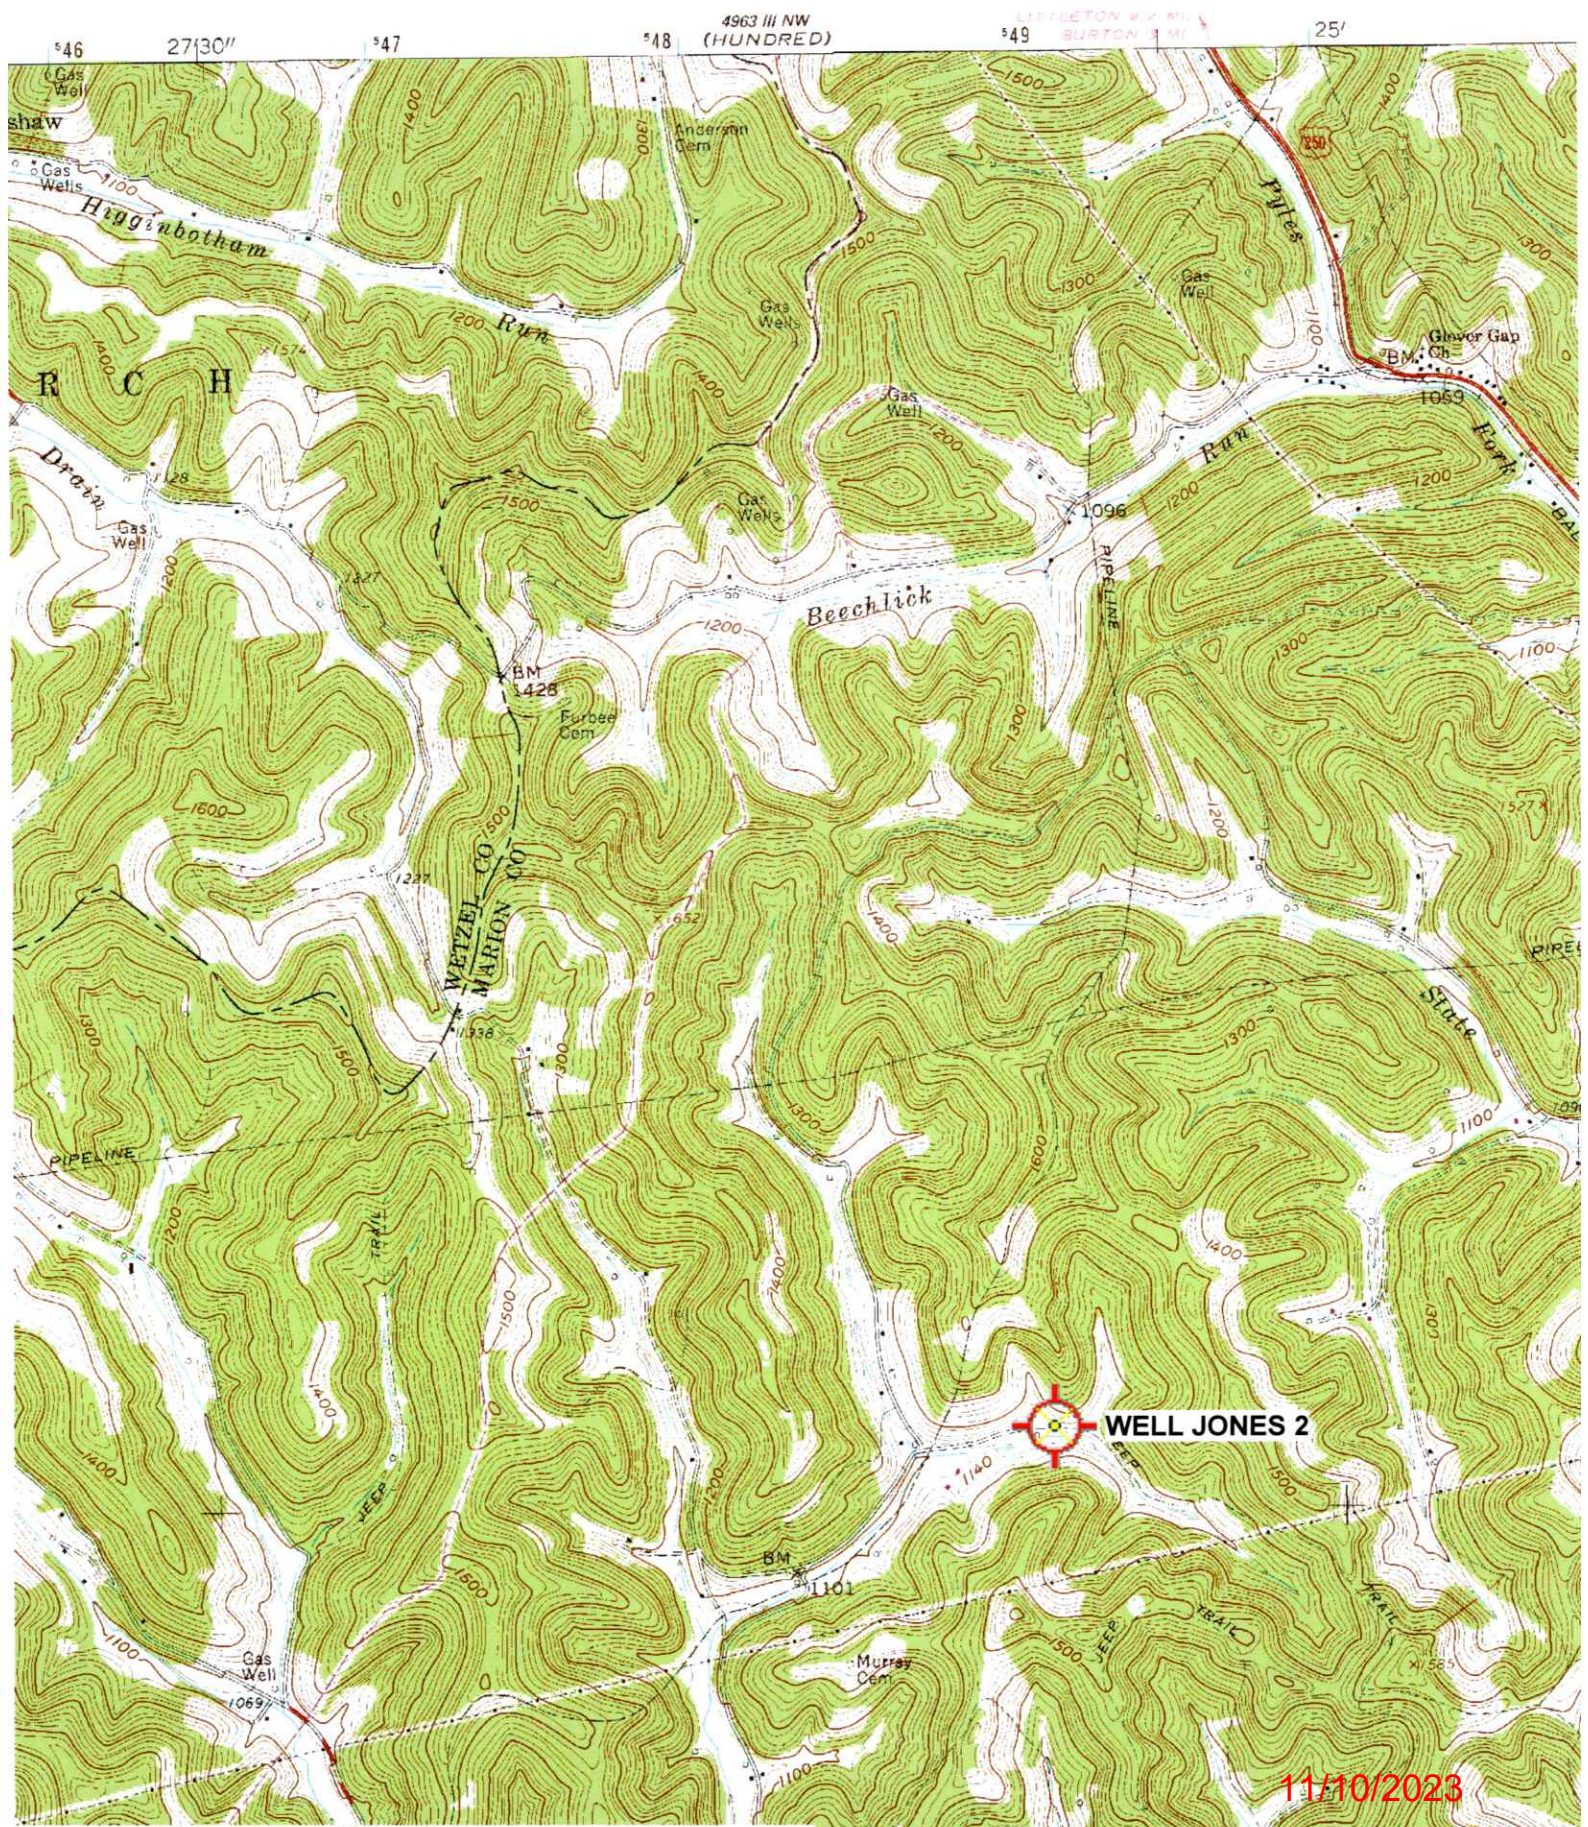

West Virginia Department of Environmental Protection
Office of Oil and Gas

WELL LOCATION FORM: GPS

API: 47-049-02184 WELL NO.: JONES 2

FARM NAME: JONES

RESPONSIBLE PARTY NAME: WEST VIRGINIA LAND RESOURCES INC.

COUNTY: MARION DISTRICT: MANNINGTON

QUADRANGLE: GLOVER GAP WV

SURFACE OWNER: JASON G. & MICHELLE R. STOUT

ROYALTY OWNER: _____

UTM GPS NORTHING: 4,381,937 m

UTM GPS EASTING: 549,188 m GPS ELEVATION: 345 m

The Responsible Party named above has chosen to submit GPS coordinates in lieu of preparing a new well location plat for a plugging permit or assigned API number on the above well. The Office of Oil and Gas will not accept GPS coordinates that do not meet the following requirements:

1. Datum: NAD 1983, Zone: 17 North, Coordinate Units: meters, Altitude: height above mean sea level (MSL) – meters.
2. Accuracy to Datum – 3.05 meters
3. Data Collection Method:

Survey grade GPS _____: Post Processed Differential _____


Real-Time Differential _____

Mapping Grade GPS X: Post Processed Differential X

Real-Time Differential _____

4. Letter size copy of the topography map showing the well location.

I the undersigned, hereby certify this data is correct to the best of my knowledge and belief and shows all the information required by law and the regulations issued and prescribed by the Office of Oil and Gas.

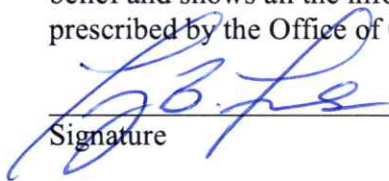
Signature

PS2002
Title

AUGUST 28, 2023
Date

RECEIVED
Office Of Oil and Gas
OCT 10 2023
WV Department of
Environmental Protection