

West Virginia Oil & Gas Wells and Fields (WVOG)

Lake Survey "Pipeline" "Pipeline Plus"

Well# 4712

HUNDRED WV, PA 7.5' Quad
Scale: 1" = 500'



1400

1400

1300

Well# 4712

Oil Well

N I N N I G T O

RECEIVED
Office of Oil and Gas
DEC 15 2025
BY Electronic of
Engineering Division

Oil Well

1300


Big Run

1400


Glover
Cem

Access Road

4704902606P

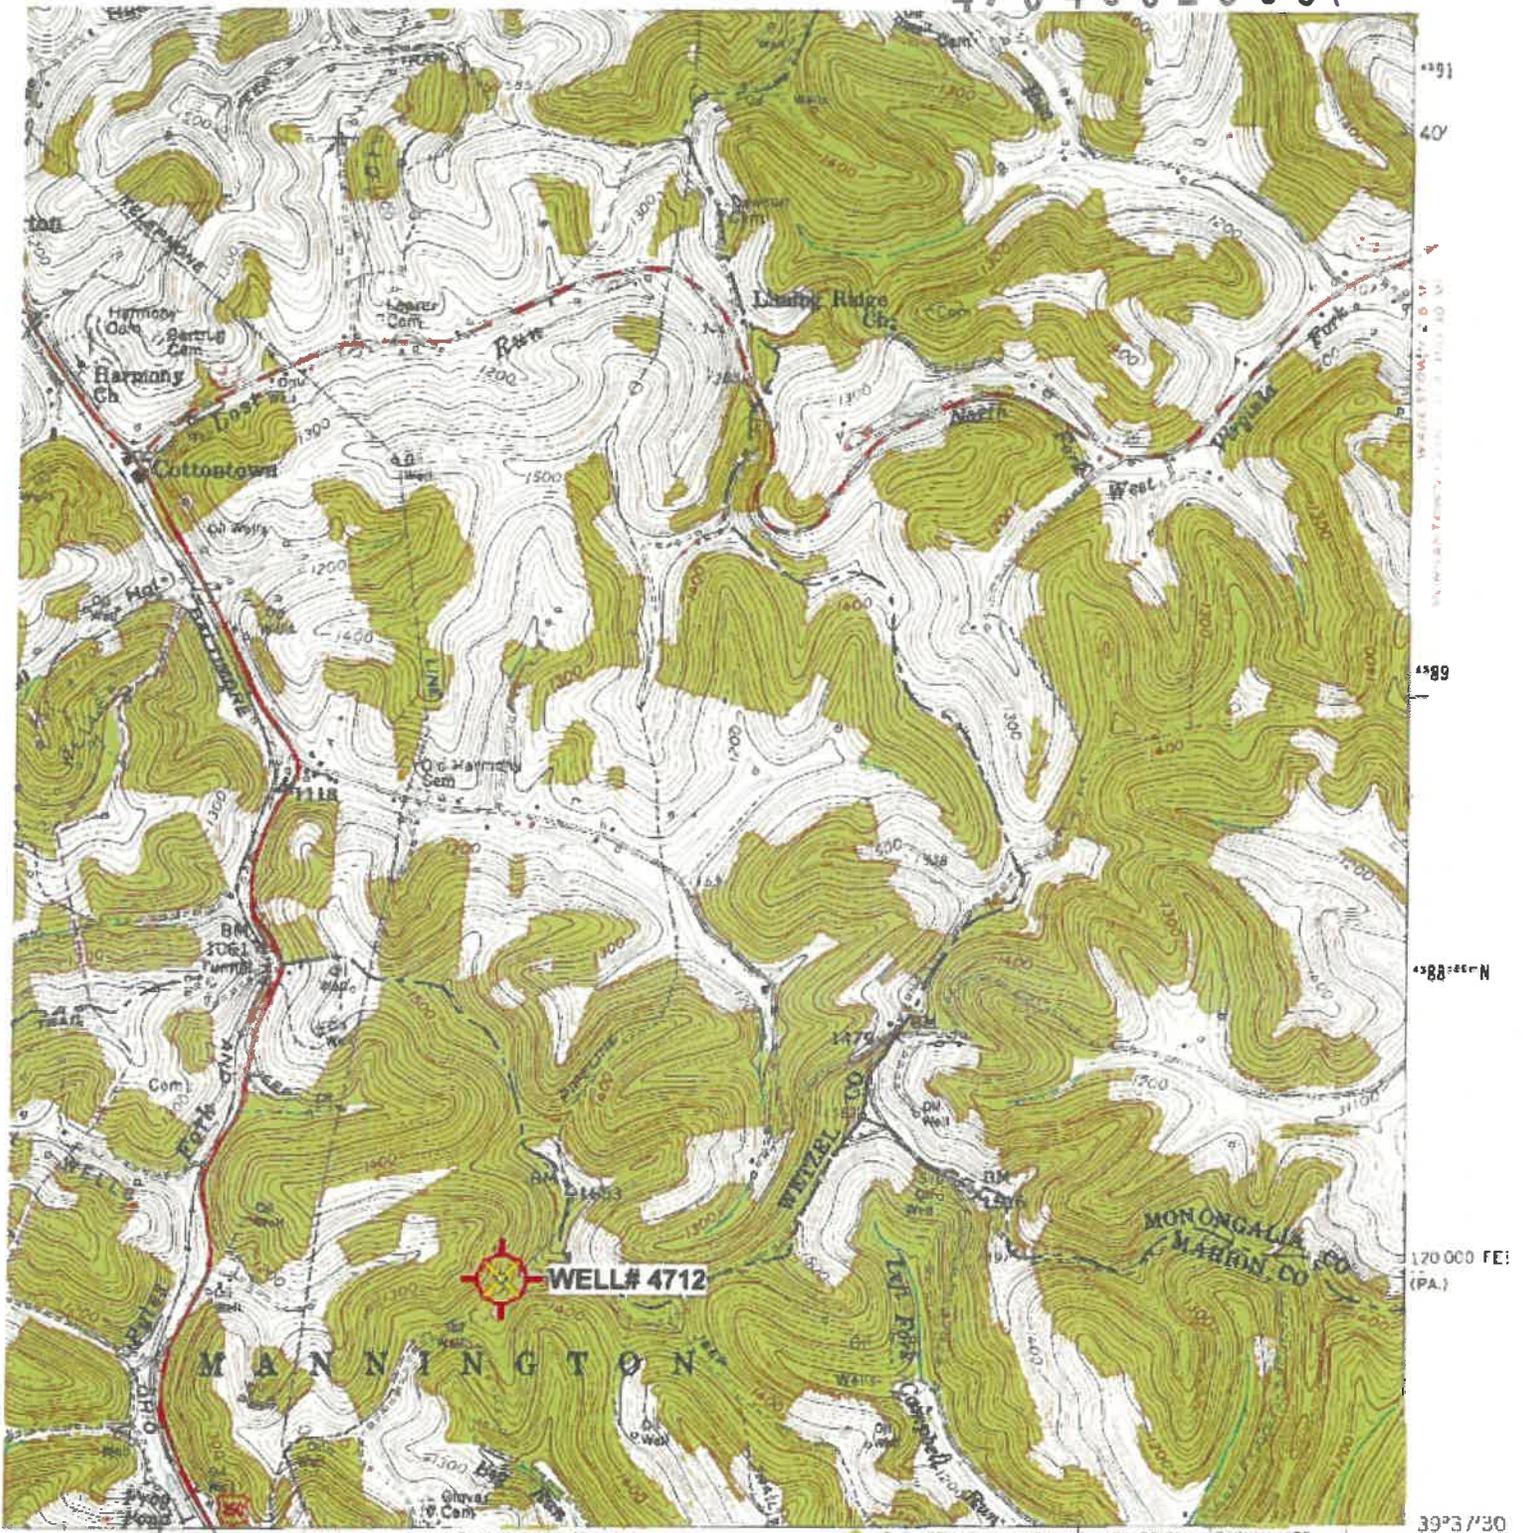

1:250 000 FEET (PA)*5] 552 3-miles-E 80°22'30" 39°31'30" (MANN) 2003 J

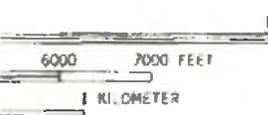

ROAD CLASSIFICATION

- Heavy duty ————
- Medium duty ————
- Light-duty - - - - -
- Unimproved dirt - - - - -
- U.S. Route (circle with 'U.S.')
- State Route (circle with 'S')

RECEIVED
Office Of Oil and Gas
DEC 15 2025
WV DEPARTMENT OF
Environmental Protection
HEADQUARTERS LOCATION

HUNDRED, W. VA.—PA.
NW/4 MANNINGTON 18' QUADRANGLE
N 3937.5—W 8022.5/7.5

STANDARDS
GINIA 22092
Revisions shown in purple computed from aerial photographs
*Hundred: WV, PA' Scale: 1" = 0.379Mi 610M 2,000Ft. 1 Mi = 2.640", 1 cm = 240M

RECEIVED
Office Of Oil and Gas
DEC 15 2025

1958
PHOTOREVISED 1976

02/13/2026

WW-7
8-30-06



West Virginia Department of Environmental Protection
Office of Oil and Gas

WELL LOCATION FORM: GPS

API: 47-049-70479 WELL NO.: 4712

FARM NAME: ROBERT N. CAMPBELL

RESPONSIBLE PARTY NAME: WEST VIRGINIA LAND RESOURCES INC.

COUNTY: MARION DISTRICT: MANNINGTON

QUADRANGLE: HUNDRED WV, PA

SURFACE OWNER: RENEE E. CAMPBELL

ROYALTY OWNER: _____

UTM GPS NORTHING: 4,387,135 m (1463)'

UTM GPS EASTING: 550,669 m GPS ELEVATION: 446 m

The Responsible Party named above has chosen to submit GPS coordinates in lieu of preparing a new well location plat for a plugging permit or assigned API number on the above well. The Office of Oil and Gas will not accept GPS coordinates that do not meet the following requirements:


- Datum: NAD 1983, Zone: 17 North, Coordinate Units: meters, Altitude: height above mean sea level (MSL) – meters.
- Accuracy to Datum – 3.05 meters
- Data Collection Method:

Survey grade GPS : Post Processed Differential _____
Real-Time Differential

Mapping Grade GPS _____ : Post Processed Differential _____
Real-Time Differential _____

- Letter size copy of the topography map showing the well location.

I the undersigned, hereby certify this data is correct to the best of my knowledge and belief and shows all the information required by law and the regulations issued and prescribed by the Office of Oil and Gas.

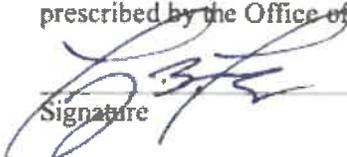
Signature

PS2002
Title

OCTOBER 23, 2025
Date

RECEIVED
Office Of Oil and Gas
DEC 15 2025
West Virginia Department of Environmental Protection