


LATITUDE 39 32 30

LONGITUDE 80 20

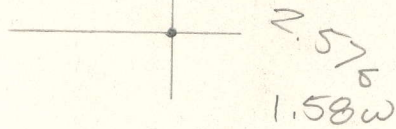

7'5 OGIS topo location

7.5' loc _____ 15' loc _____
 (calc.) _____

Company _____

Farm M S SNODERLY 1

Quad MANNINGTON

County MARION

District MANNINGTON

WELL LOCATION MAP

File No. 30077

#1543 MMT Colp

Mannington District, Marion County, W. Va.
 By South Penn Oil Co., P. O. Drawer 1255, Pittsburgh, Pa.
 On 1 $\frac{3}{4}$ acres, surface owned by John Lemmon, Mannington, W. Va.,
 and mineral rights by Luella Hibbs et al., Mannington, W. Va.
 Elevation, 1209' L.
 36' conductor; 10" casing, 144'; 7-5/8", 682'; 6 $\frac{1}{2}$ ", 610';
 4-7/8", 1968'.
 4-7/8" casing perforated at 1420'.
 Coal was encountered at 637-645' (Est. th.)
 Abandonment reported to Dept. of Mines May 2, 1933.
 Well was shot at 2069 with 8 qts.; and at 2078', with 10 qts.

MAR-72A

	Top.	Bottom.
Conductor	0	36
Pittsburgh Coal	637	
Salt Sand (gas, 1570')	1540	
Big Injun Sand (gas, 2007'; 1st pay, 2069'; 2nd pay, 2079')	1972	
Total depth		2107