39°30'00"

Latitude

80°15'00"

Longitude

2.84s
.12w

Topo Location

7.5' Loc. _____ 15' Loc. _____

_____ (calc.) _____

Company _____

Farm _____

15' Quad (sec.) _____

7.5' Quad Shinnston

District Lincoln

WELL LOCATION PLAT

County 049 Permit 30183

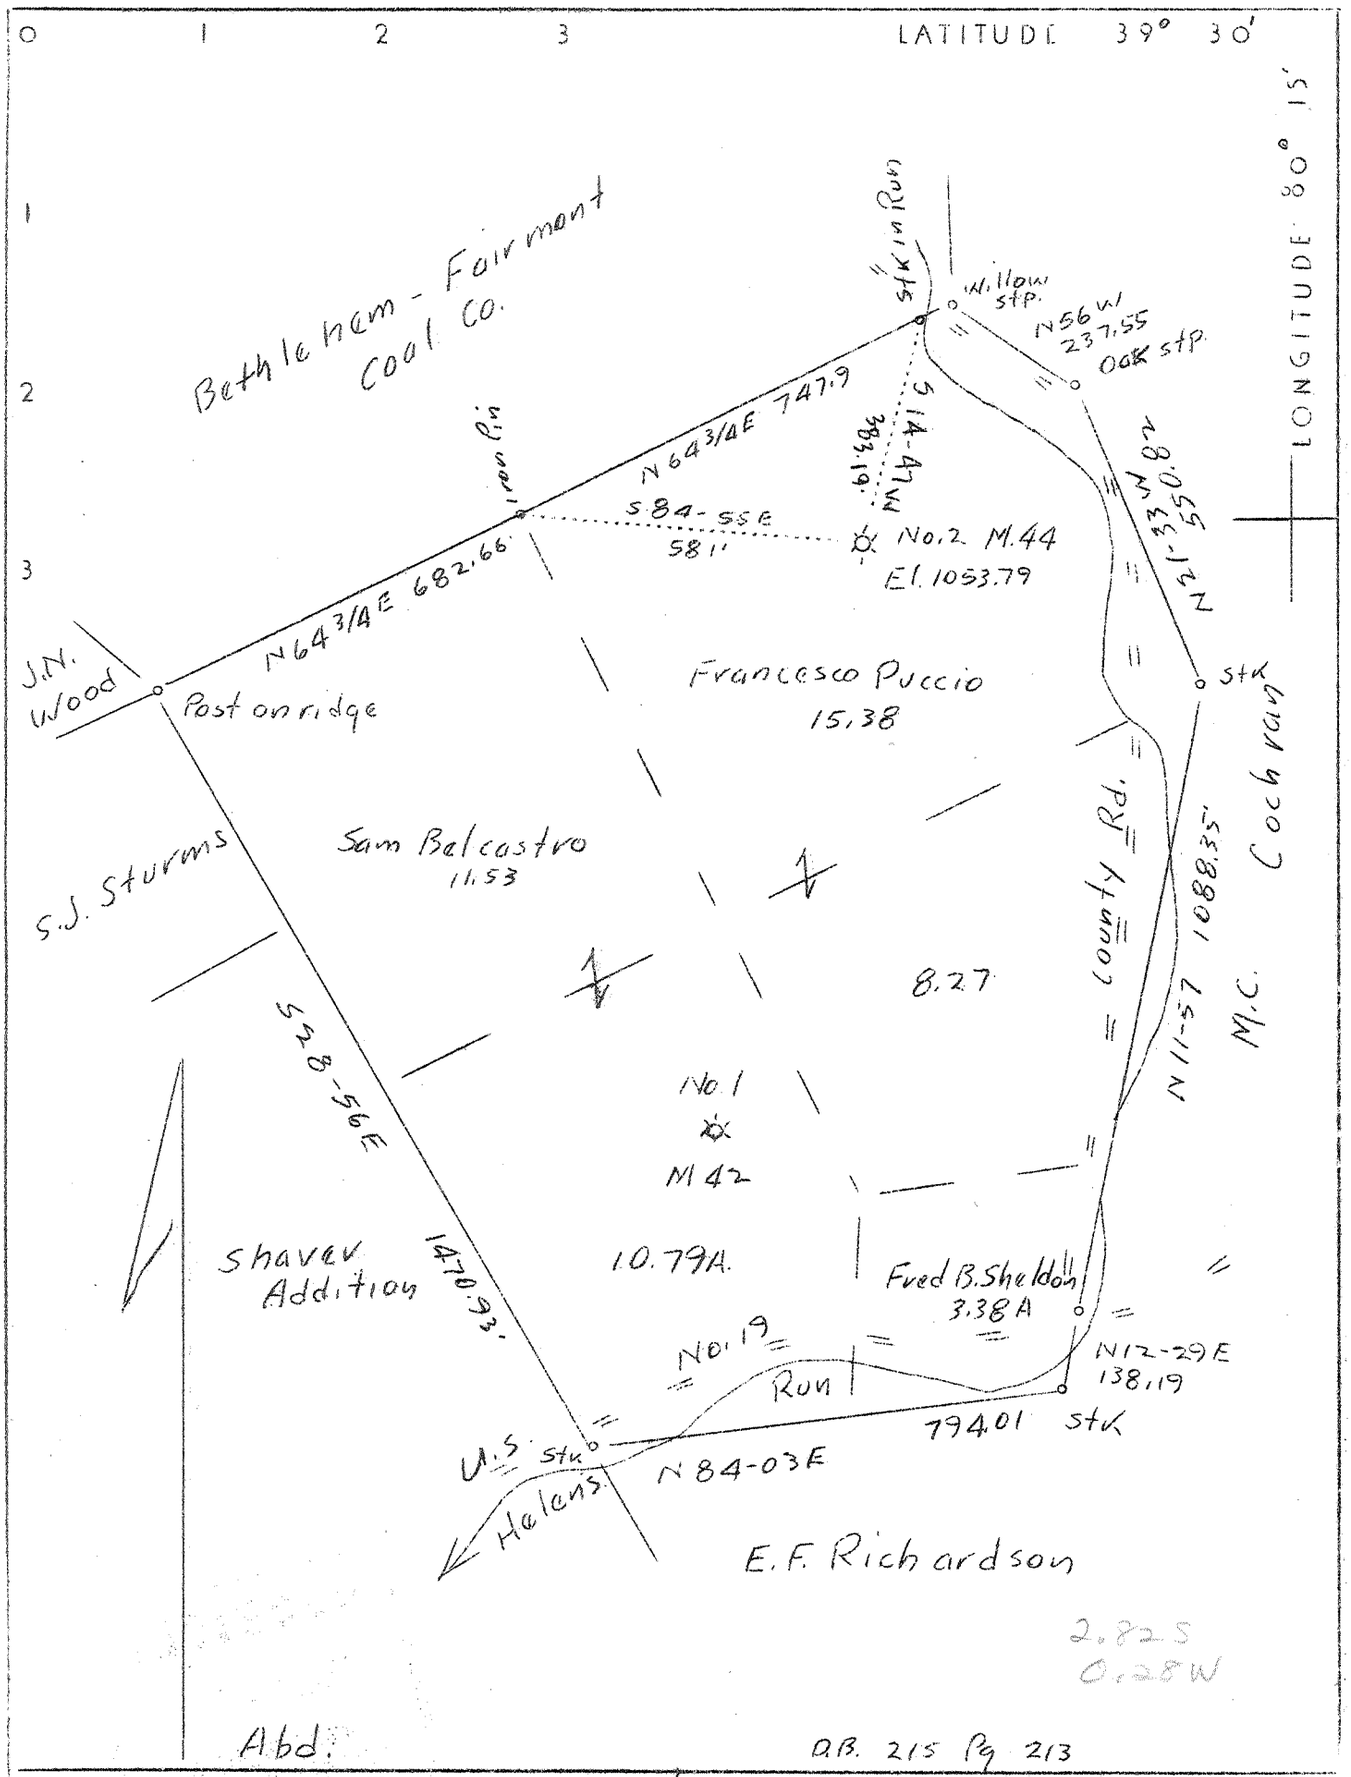

Company Monongahela West Penn Public Service Co.

Address Fairmont, W.Va.

Farm Francesco Puccio- Surface A.W.Prichard et al

Tract 1 Acres 50 Lease No. 5

Well(Farm) No. 2 Serial No. M#44

Elevation (Spirit Level) 1053.79

Quadrangle Clarksburg NE.

County Marion District Lincoln

Engineer F.A.H.Kelley

Engineer's Registration No. 695

File No. Drawing No. B-101437-G

Date 10-14-37 Scale 1"-300'

STATE OF WEST VIRGINIA
Department of Mines
OIL AND GAS DIVISION
CHARLESTON

WELL LOCATION MAP

File No. MAR-183A

+ Denotes location of well on United States Topographic Maps, scale 1 to 62,500, latitude and longitude lines being represented by border lines as shown.

— Denotes one inch spaces on border line of original tracing.