

Company RICHARD JACKSON
 Address HARLIN, W. VA.
 Farm ABBY RICE, ET AL.
 Tract Acres 185 Lease No. 186
 Well (Farm) No. 127

STATE OF WEST VIRGINIA
 DEPARTMENT OF MINES
 OIL AND GAS DIVISION
 CHARLESTON
WELL LOCATION MAP

Latitude 39 35'

Longitudes 80 05'

LATITUDE 39 35

LONGITUDE 80 07 30

1.156
3 W

7.5 OGIS topo location

7.5' loc _____ 15' loc _____
_____ (calc.) _____

Company _____ 127 _____

Farm ASHBY RICE et al 3

Quad Grant Town

County Marion

District Pow Pow

WELL LOCATION MAP

File No. 30763

763A

Prosper District, Marion County, W. Va.
 By Wilhelm & Jackson, Radlin, W. Va.
 Abandoned under permit No.
 On 18 1/2 acres, on left Fork of Thorough Run.
 Drilling commenced Nov. 21, 1928; completed Dec. 27, 1928.
 Shot Nov. 22, 1928, at 2876-2888'.
 13" casing, 10'; 8 1/2", 528' 2"; 6 1/2", 1525' (pulled); 5 1/2", 1800';
 2" tubing, 2921' 3".
 Casing cemented, 10".
 Water in Sewickley Coal, 2 hoppers per hour.
 Show of gas in Pittsburgh Coal.
 10" casing cemented with 35 sacks cement and 70 sacks sand.
 Gas, 2845-3443', show only.
 Water, 1455-1458', 3 hoppers per hour.
 Gas, 1977-1942', not tested; burned up 5' in 6 1/2" casing.
 Gas, 2369'-2371', 56 N. cu. ft.
 Gas, 2877-2880', 61 N. cu. ft.
 Gas well. Record to Dept. of Mines stamped Jan. 24, 1952.
 Record to DOT from Wm. Griffith July 9, 1952. O. V. No. 644.

	Top.	Bottom.
Clay, slate	0	26
Coal	26	28
Lime and slate	28	95
Coal	95	97
Lime, sand, and slate	97	207
Sand, lime, and slate	207	378
Mapletown (Sewickley) Coal	378	383
Lime and slate	383	473
Pittsburgh Coal	473	479
Lime and slate	479	530
Slate, lime, sand, and red rock	530	712
Sand, lime, and slate	712	865
Sand, slate, and lime	865	1317
Hard sand	1317	1390
Sand and slate	1390	1451
Hard white sand	1451	1458
Sand, slate, and lime	1458	1672
Little lime	1672	1732
Slate	1732	1742
Big lime	1742	1800
Big lime	1800	1850
Big Injun Sand	1850	1975
Slate, lime, and sand	1975	2366
Ganta Sand, hard	2366	2504
Ganta Sand, soft	2504	2519
Red rock, lime, and sand	2519	2867
Fifth Sand	2867	2921
Slate, sand, and lime	2921	3082
Total depth drilled		3082
Present total depth		2918



STATE OF WEST VIRGINIA
DEPARTMENT OF MINES
OIL AND GAS DIVISION

844

WELL RECORD

Permit No. MAR-763-A


Oil or Gas Well _____
(KIND)

Company Wilkins & Jackson
 Address Hamlin, West Virginia
 Farm Asby Rice et al Acres 185
 Location (waters) Left Fork of Pharaoh Run
 Well No. 3, Serial 127 Elev. 1171.1'
 District Few Paw County Marion
 The surface of tract is owned in fee by _____
 Address _____
 Mineral rights are owned by _____
 Address _____
 Drilling commenced 11/21/1928
 Drilling completed 12/27/1928
 Date Shot 11/22/28 From 2876' To 2883'
 With _____
 Open Flow _____ /10ths Water in _____ Inch
 _____ /10ths Merc. in _____ Inch
 Volume _____ Cu. Ft.
 Rock Pressure _____ lbs. _____ hrs.
 Oil _____ bbls., 1st 24 hrs.
 Fresh water _____ feet _____ feet
 Salt water _____ feet _____ feet

Casing and Tubing	Used in Drilling	Left in Well	Packers
Size			
16		16'	Kind of Packer
13			
10			Size of
8 1/4	528' 2"	528' 2"	
6 5/8	1525'		Depth set
5 3/16	1800'	1800'	
3			Perf. top
2	2921' 3"	2921' 3"	Perf. bottom
Liners Used			Perf. top
			Perf. bottom

CASING CEMENTED _____ SIZE 10" No. Ft. _____ Date _____
 COAL WAS ENCOUNTERED AT _____ FEET _____ INCHES
 _____ FEET _____ INCHES FEET _____ INCHES
 _____ FEET _____ INCHES FEET _____ INCHES

Formation	Color	Hard or Soft	Top	Bottom	Oil, Gas or Water	Depth Found	Remarks
Clay, slate			0	26			
Coal			26	28			
Line and slate			28	95			
Coal			95	97			
Line, sand and slate			97	207			
Sand, line and slate			207	378			
Hopletown Coal			378	383			
Line and slate			383	473			
Pittsburgh Coal			473	479			
Line and slate			479	530			
Slate, line, sand	Red Rock		530	712			
Sand, line & slate			712	865			
Sand, slate & line			865	1317			
Hard Sand			1317	1390			
Sand & slate			1390	1451			
Hard white Sand			1451	1458			
Sand, slate & line			1458	1672			
Little line			1672	1732			
Slate			1732	1742			
Big line			1742	1800			
Big line			1800	1850			
Injun Sand			1850	1975			
Slate, line and sand			1975	2366			
Gantz Sand - Hard			2366	2504			
Gantz Sand - Soft			2504	2519			
Red rock, line and sand			2519	2867			
Fifth Sand			2867	2921			
Slate, sand and line			2921	3082			
Total depth drilled				3082			
Present Total Depth				2918			

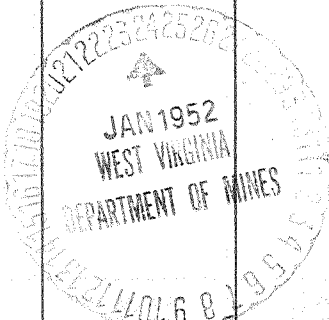

(Over)

JUL 9 1952