


39 37 30 LATITUDE 39 37 30

LONGITUDE 80 22 30

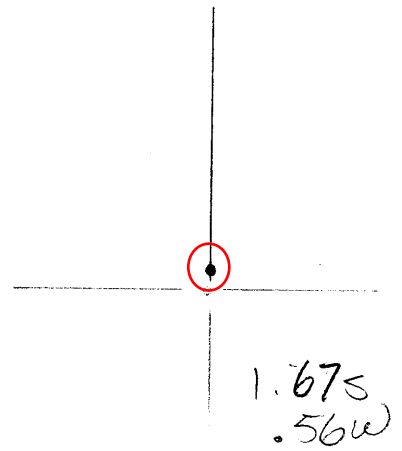

80 22 30

7'5 OGIS topo location

7.5' loc	<u>1.67S</u>	15' loc	_____
	<u>.56W</u>	(calc.)	_____

Company \_\_\_\_\_

Farm AARON FURBEE 1

Quad GLOVER GAP

County MARION

District MANNINGTON

WELL LOCATION MAP

File No. 70080

Mannington District, Marion County, W. Va.  
 South Penn Oil Co.  
 Elevation, 1018' L.  
 Near Glover Gap.  
 8 1/2" casing, 1274'; 6-5/8", 2088'.

398 mmt  
 Co Rep

	Top.	Bottom.
Mapletown (Sewickley) Coal	670	675
Pittsburgh Coal	767	774
Dunkard Sand	1268	1345
Gas Sand (water at 1545')	1442	1575
Salt Sand	1698	1710
Big Injun Sand (gas, 2085'; oil and water, 2175')	2072	2263
50-Ft. Sand	2720	2755
30-Ft. Sand (5 bailers oil)	2820	2865
Stray Sand	2908	2932
Unrecorded to Gordon Sand (Campbelle Run) and oil at		2939
Total depth		2967

