


LATITUDE 39 37 30

LONGITUDE 80 22 30

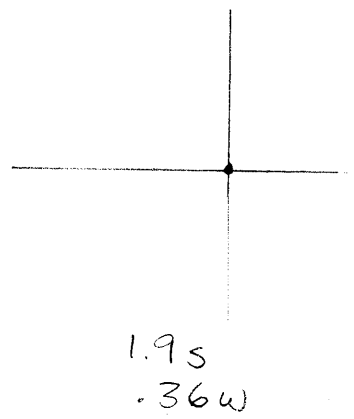

7'5 OGIS topo location

| | | | |
|----------|-------------|---------|-------|
| 7.5' loc | <u>1.9S</u> | 15' loc | _____ |
| | <u>.36W</u> | (calc.) | _____ |

Company _____

Farm LEMLEY & HIBBS 2

Quad MANNINGTON

County MARION

District MANNINGTON

WELL LOCATION MAP

File No. 70135

70135

Mannington District, Marion County, W. Va.
By Hartman Oil Co.
1 1/2 mi. E. of Glovers Gap, on B. & O. R. R.

8

| | Top. | Bottom. |
|-----------------|------|----------|
| Pittsburgh Coal | | 921 |
| Big Injun Sand | 2270 | - 2337 |
| Total depth | | 2404 1/2 |