


Latitude

39° 35

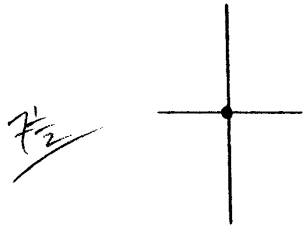

80° 17' 30"

Longitude

.73s

Topo Location

3.62w

7.5' Loc. .73s 15' Loc. .73s
1.40w (calc.) 3.62w

#489 on Co Refs MAP

Company BURT
Columbus Snodgrass

Farm COLUMBUS SNODGRASS

15' Quad MANNINGTON
(sec.)

7.5' Quad MANNINGTON

District MANNINGTON

WELL LOCATION PLAT

County 049 Permit 70268