


Latitude

39° 35'

80° 10'

Longitude

7 1/2'

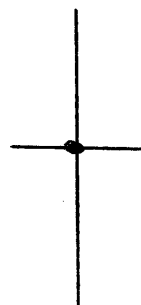

Topo Location

7.5' Loc. 1.23s 15' Loc. 1.238  
.39w (calc.) .39w

#581 on Co. Rep. Plat

Company Hope

Farm Alpheus (J.L.) Fluharty / (1950)?

15' Quad Blackville SW  
(sec.)

7.5' Quad GRANT TOWNSHIP

District Paw Paw

WELL LOCATION PLAT

County 049 Permit 70319