

WVDEP Reclamation Site Overview / Detail

Victory B 4507 (API #47-051-00326-00-00)

- BMP's and erosion control devices to be utilized per WVDEP guidelines and Columbia's WV Environmental Construction Standards.
- Existing drainage, culverts, and road ditches to be maintained.
- Minor grading and surface material to be applied as needed.

Legend

- Access Route
- Victory B - 04507
- Victory B 4507 LOD


Pit A, Pit B:
50' x 10' x 4' deep

Victory B - 04507

Google Earth

01/16/2026


300 ft

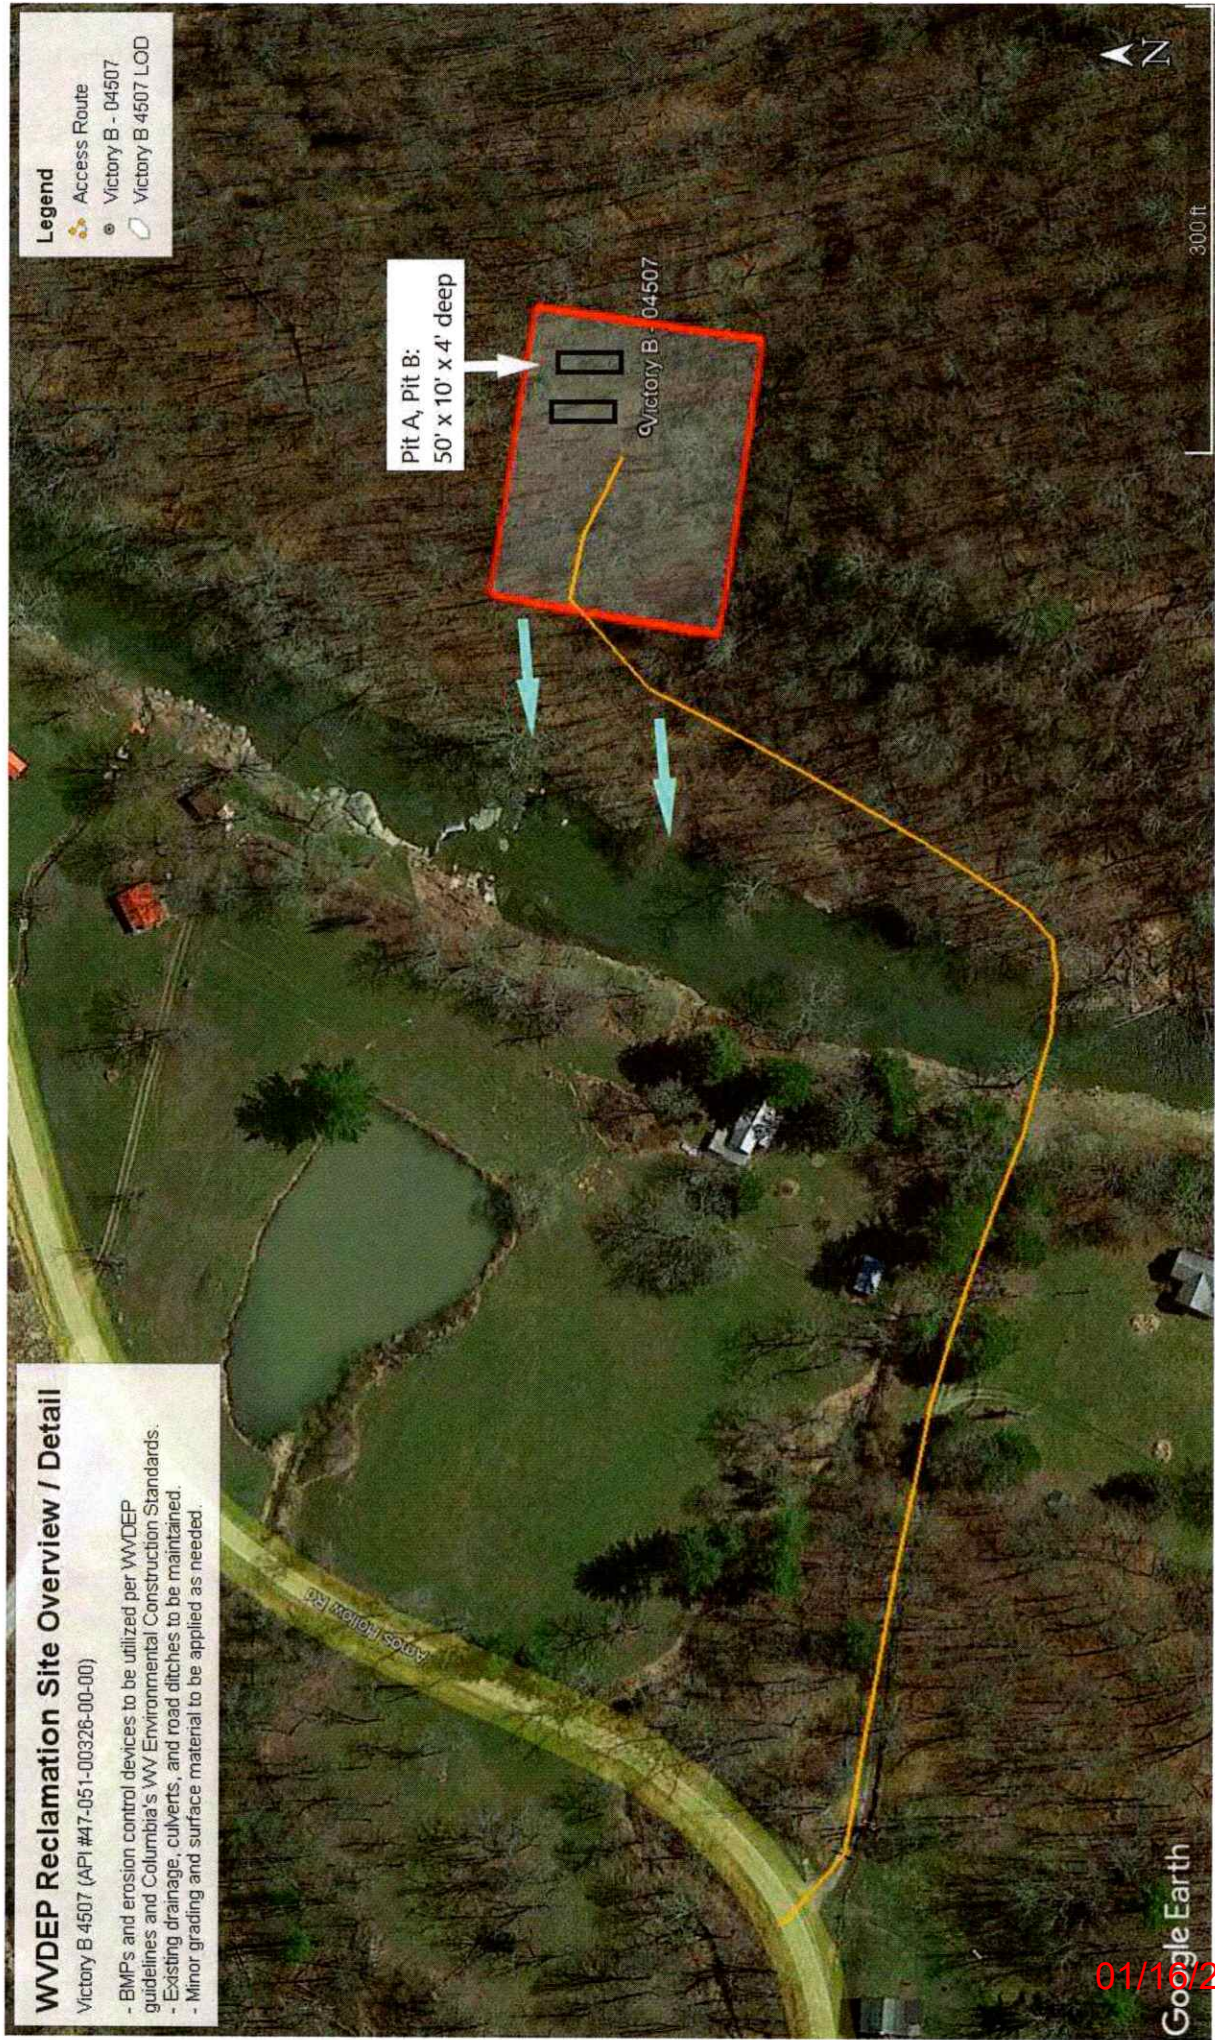

GLEN EASTON

CAMERON

NEW FREEPORT

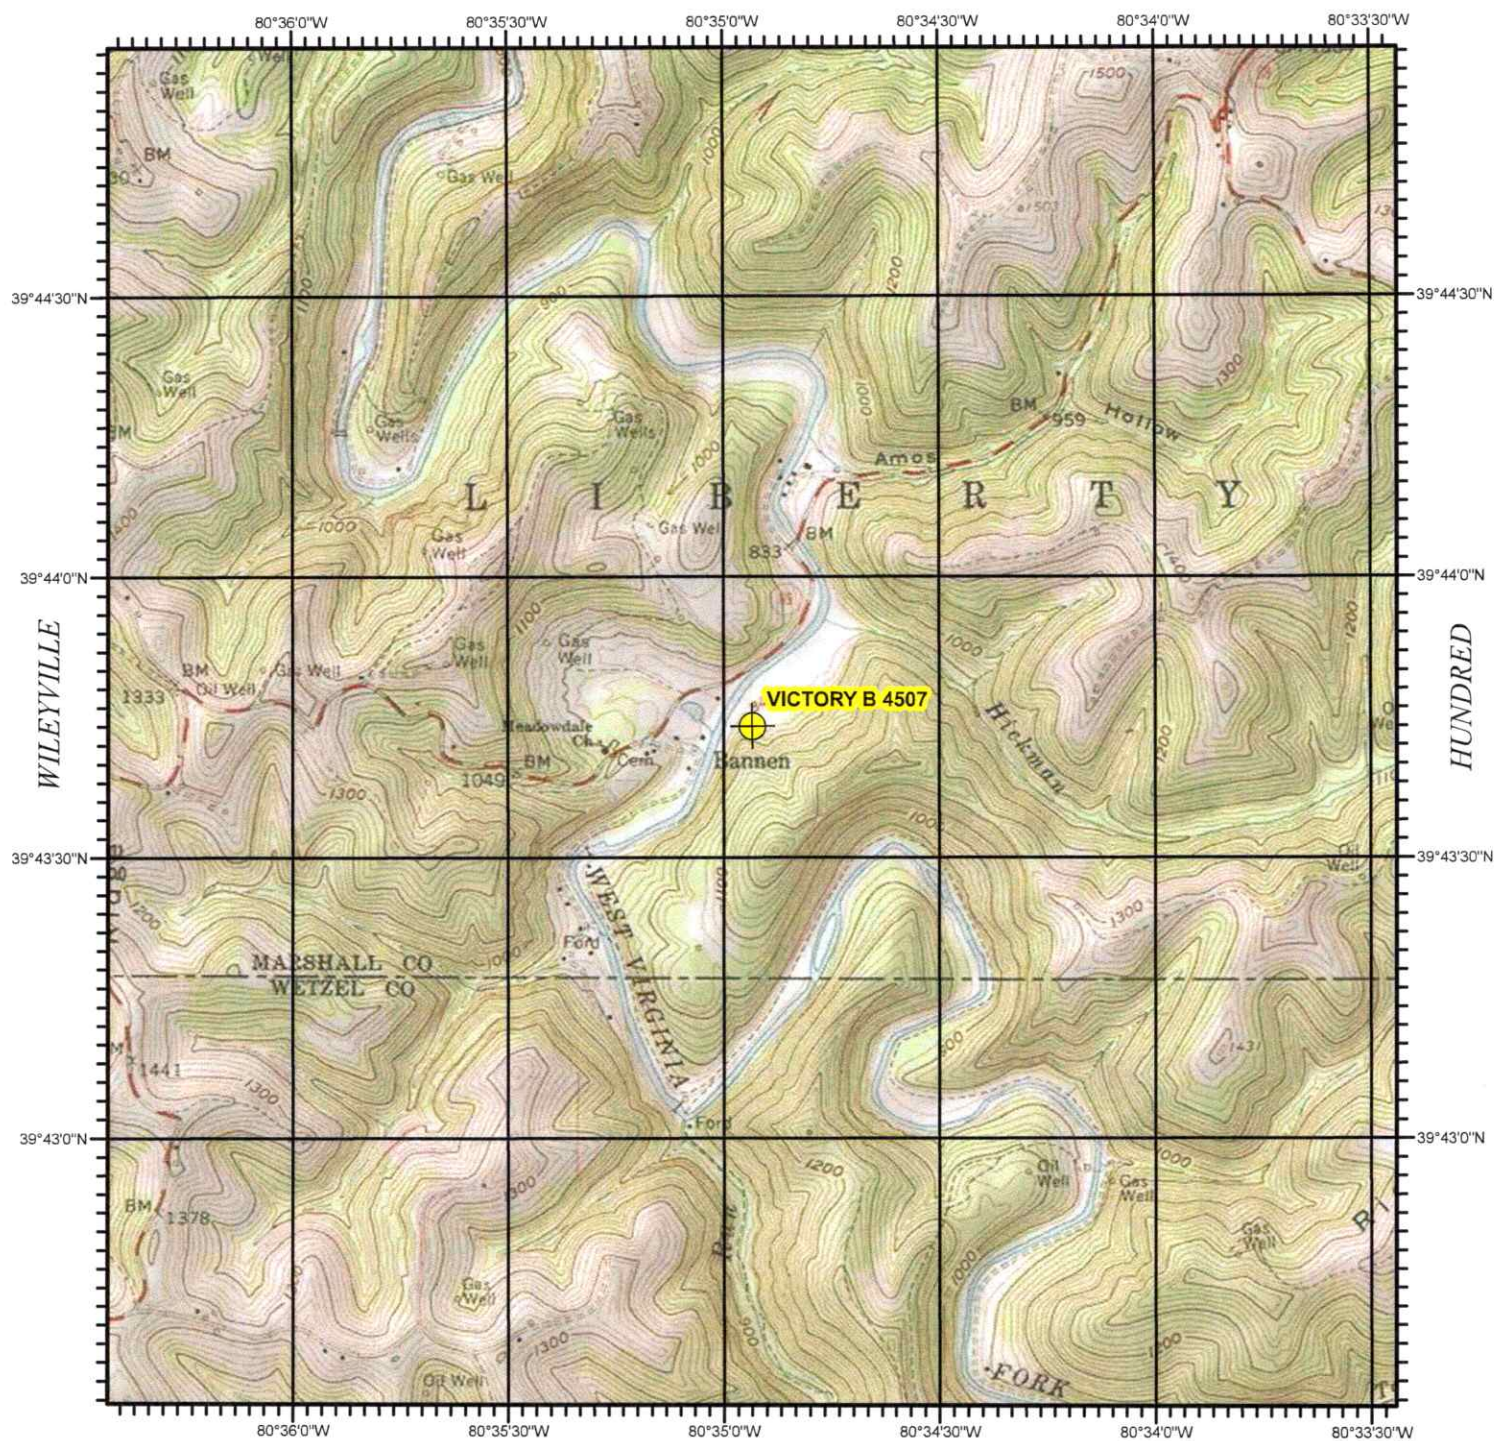


PINE GROVE

BIG RUN

GLOVER GAP

VICTORY B 3025
MARSHALL COUNTY, WV

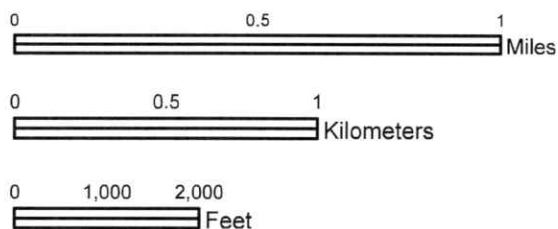

USGS TOPOGRAPHIC QUADRANGLE
LITTLETON, WV - 1976

North American 1983 Datum (NAD83)

SCALE 1:24,000

01/16/2026

WW-7
8-30-06'



West Virginia Department of Environmental Protection
Office of Oil and Gas

WELL LOCATION FORM: GPS

API: 47-051-00326-00-00 WELL NO.: Victory B 4507

FARM NAME: EVANS, R. W.

RESPONSIBLE PARTY NAME: Columbia Gas Transmission, LLC

COUNTY: Marshall DISTRICT: Liberty

QUADRANGLE: Littleton, WV

SURFACE OWNER: Peter V. Vellekoop and Linda J. Vellekoop, his wife

ROYALTY OWNER: Peter V. Vellekoop, Linda J. Vellekoop

UTM GPS NORTHING: 4,397,751.261

UTM GPS EASTING: 535,813.160 GPS ELEVATION: 869'

The Responsible Party named above has chosen to submit GPS coordinates in lieu of preparing a new well location plat for a plugging permit or assigned API number on the above well. The Office of Oil and Gas will not accept GPS coordinates that do not meet the following requirements:

1. Datum: NAD 1983, Zone: 17 North, Coordinate Units: meters, Altitude: height above mean sea level (MSL) – meters.
2. Accuracy to Datum – 3.05 meters
3. Data Collection Method:

Survey grade GPS x: Post Processed Differential X

Real-Time Differential

Mapping Grade GPS : Post Processed Differential

Real-Time Differential

4. Letter size copy of the topography map showing the well location.

I the undersigned, hereby certify this data is correct to the best of my knowledge and belief and shows all the information required by law and the regulations issued and prescribed by the Office of Oil and Gas.

Paul Nicks
Signature

Storage Engineer
Title

11/25/2025
Date

01/16/2026