Genie 3/17/99

LATITUDE 39°50'00"

LONGITUDE 80°37'30"

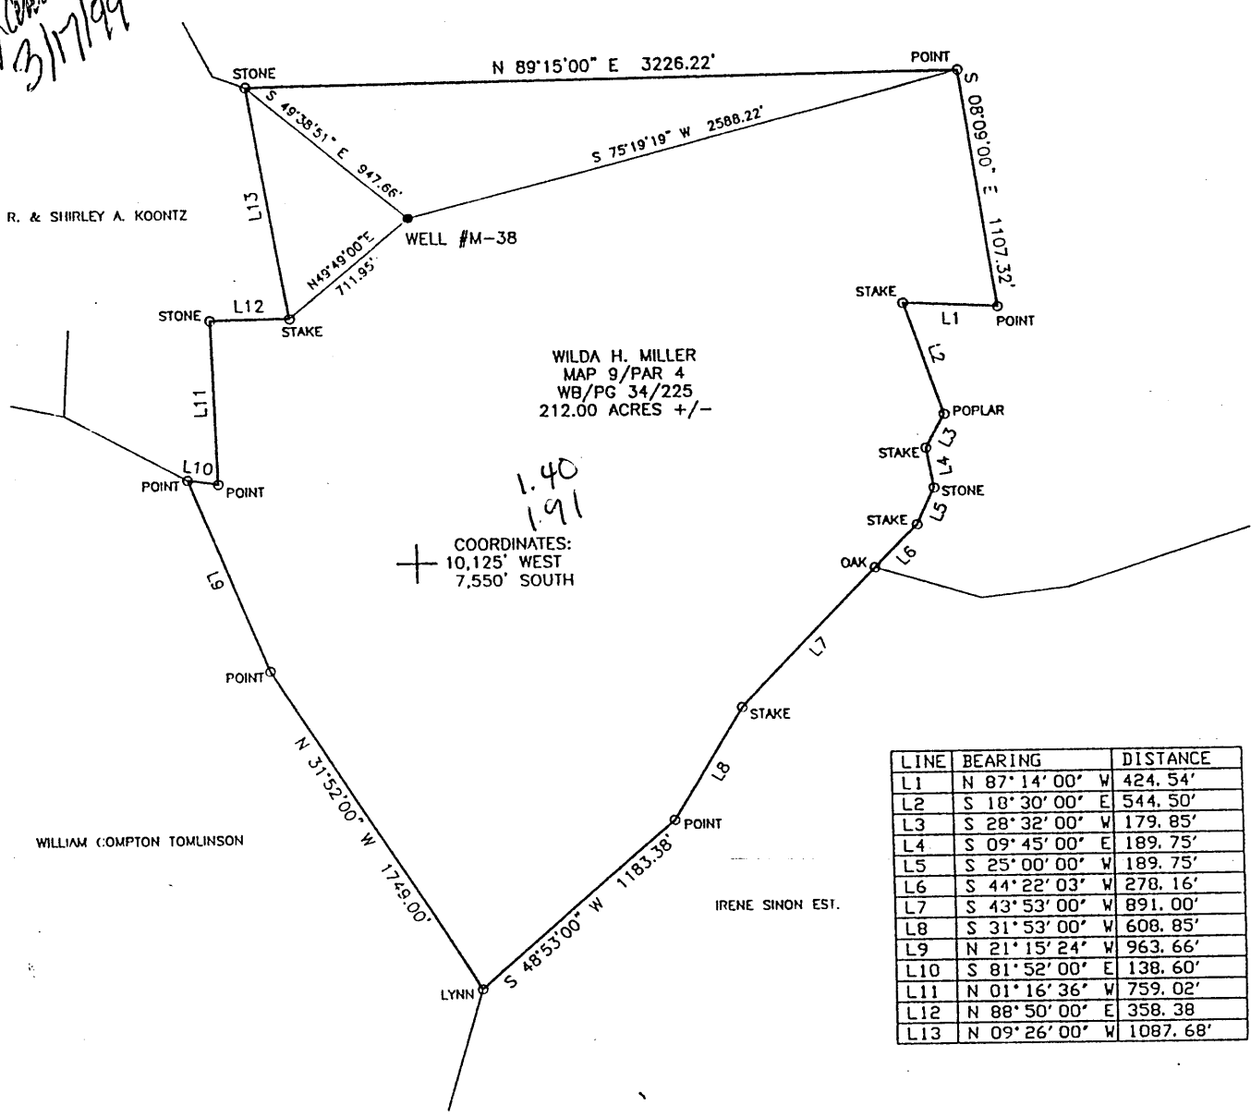

LINE	BEARING	DISTANCE
L1	N 87° 14' 00" W	424. 54'
L2	S 18° 30' 00" E	544. 50'
L3	S 28° 32' 00" W	179. 85'
L4	S 09° 45' 00" E	189. 75'
L5	S 25° 00' 00" W	189. 75'
L6	S 44° 22' 03" W	278. 16'
L7	S 43° 53' 00" W	891. 00'
L8	S 31° 53' 00" W	608. 85'
L9	N 21° 15' 24" W	963. 66'
L10	S 81° 52' 00" E	138. 60'
L11	N 01° 16' 36" W	759. 02'
L12	N 88° 50' 00" E	358. 38
L13	N 09° 26' 00" W	1087. 68'

(+) DENOTES LOCATION OF WELL ON UNITED STATES TOPOGRAPHIC MAPS

FILE NO. M-38
DRAWING NO. M-38
SCALE 1" = 800'
MINIMUM DEGREE OF ACCURACY 1 IN 2,500
PROVEN SOURCE OF ELEVATION U.S.G.S. MONUMENT EASTON 1481.53'

I THE UNDERSIGNED, HEREBY CERTIFY THAT THIS PLAT IS CORRECT TO THE BEST OF MY KNOWLEDGE AND BELIEF AND SHOWS ALL THE INFORMATION REQUIRED BY LAW AND THE REGULATIONS ISSUED AND PRESCRIBED BY THE DEPARTMENT OF ENERGY.

(SIGNED) William P. Foley
WILLIAM P. FOLEY
R.P.C.E. #4449 P.S. #1095

PLACE SEAL HERE

STATE OF WEST VIRGINIA
DIVISION OF ENVIRONMENTAL PROTECTION
OFFICE OF OIL AND GAS
#10 McJUNKIN ROAD
NITRO, WV 25143-2506

BLUE MOUNTAIN ENGINEERING
58 WADESTOWN PIKE
BURTON, WV 26562
PHONE: (304) 662-6486

DATE FEBRUARY 2, 1999
OPERATOR'S WELL NO. M-38
API WELL NO.
47 — 051 — 0841-P
STATE COUNTY PERMIT

WELL TYPE: OIL ___ GAS ___ LIQUID INJECTION ___ WASTE DISPOSAL ___
(IF "GAS,") PRODUCTION ___ STORAGE ___ DEEP ___ SHALLOW ___ ABANDONED X was OSI

LOCATION: ELEVATION 1,290.74' WATER SHED UNNAMED TRIBUTARY OF UPPER BOWMAN RUN 70639
DISTRICT MEADE COUNTY MARSHALL
QUADRANGLE GLEN EASTON, WV 7.5'

SURFACE OWNER WILDA H. MILLER ACREAGE 212.00±
OIL & GAS ROYALTY OWNER SURFACE TRACT OWNER LEASE ACREAGE 212.00±
LEASE NO. NONE

PROPOSED WORK: DRILL ___ CONVERT ___ DRILL DEEPER ___ REDRILL ___ FRACTURE OR STIMULATE ___ PLUG OFF OLD FORMATION ___ PERFORATE NEW FORMATION ___ OTHER PHYSICAL CHANGE IN WELL (SPECIFY) Pressure are 1929 well for mine through.

PLUG AND ABANDON X CLEAN OUT AND REPLUG ___

TARGET INFORMATION ___ ESTIMATED DEPTH UNKNOWN
WELL OPERATOR MCELROY COAL COMPANY DESIGNATED AGENT D. SCOTT RICE
ADDRESS R.D. #4 BOX 425 ADDRESS R.D. #4 BOX 425
MOUNDSVILLE, WV 26041 MOUNDSVILLE, WV 26041

MAR 22 1999

MARS 0841 P