

WW-7
8-30-06



West Virginia Department of Environmental Protection
Office of Oil and Gas

WELL LOCATION FORM: GPS

API: 47-051-01125 WELL NO.: MC-53A
 FARM NAME: WALLACE & TWILA POLING
 RESPONSIBLE PARTY NAME: WEST VIRGINIA LAND RESOURCES INC.
 COUNTY: MARSHALL DISTRICT: WEBSTER
 QUADRANGLE: MOUNDSVILLE WV, OH
 SURFACE OWNER: AARON M. POLING
 ROYALTY OWNER: _____
 UTM GPS NORTHING: 4,415,861 m
 UTM GPS EASTING: 530,414 m GPS ELEVATION: 381 m (1250')

The Responsible Party named above has chosen to submit GPS coordinates in lieu of preparing a new well location plat for a plugging permit or assigned API number on the above well. The Office of Oil and Gas will not accept GPS coordinates that do not meet the following requirements:

1. Datum: NAD 1983, Zone: 17 North, Coordinate Units: meters, Altitude: height above mean sea level (MSL) – meters.
2. Accuracy to Datum – 3.05 meters
3. Data Collection Method:

Survey grade GPS : Post Processed Differential _____
 Real-Time Differential

Mapping Grade GPS _____ : Post Processed Differential _____
 Real-Time Differential _____

4. Letter size copy of the topography map showing the well location.

I the undersigned, hereby certify this data is correct to the best of my knowledge and belief and shows all the information required by law and the regulations issued and prescribed by the Office of Oil and Gas.

[Signature] Professional Surveyor
 Signature Title


MAY 15, 2021
 Date

RECEIVED
Office of Oil and Gas

JUN 22 2021

WV Department of
Environmental Protection

10/01/2021

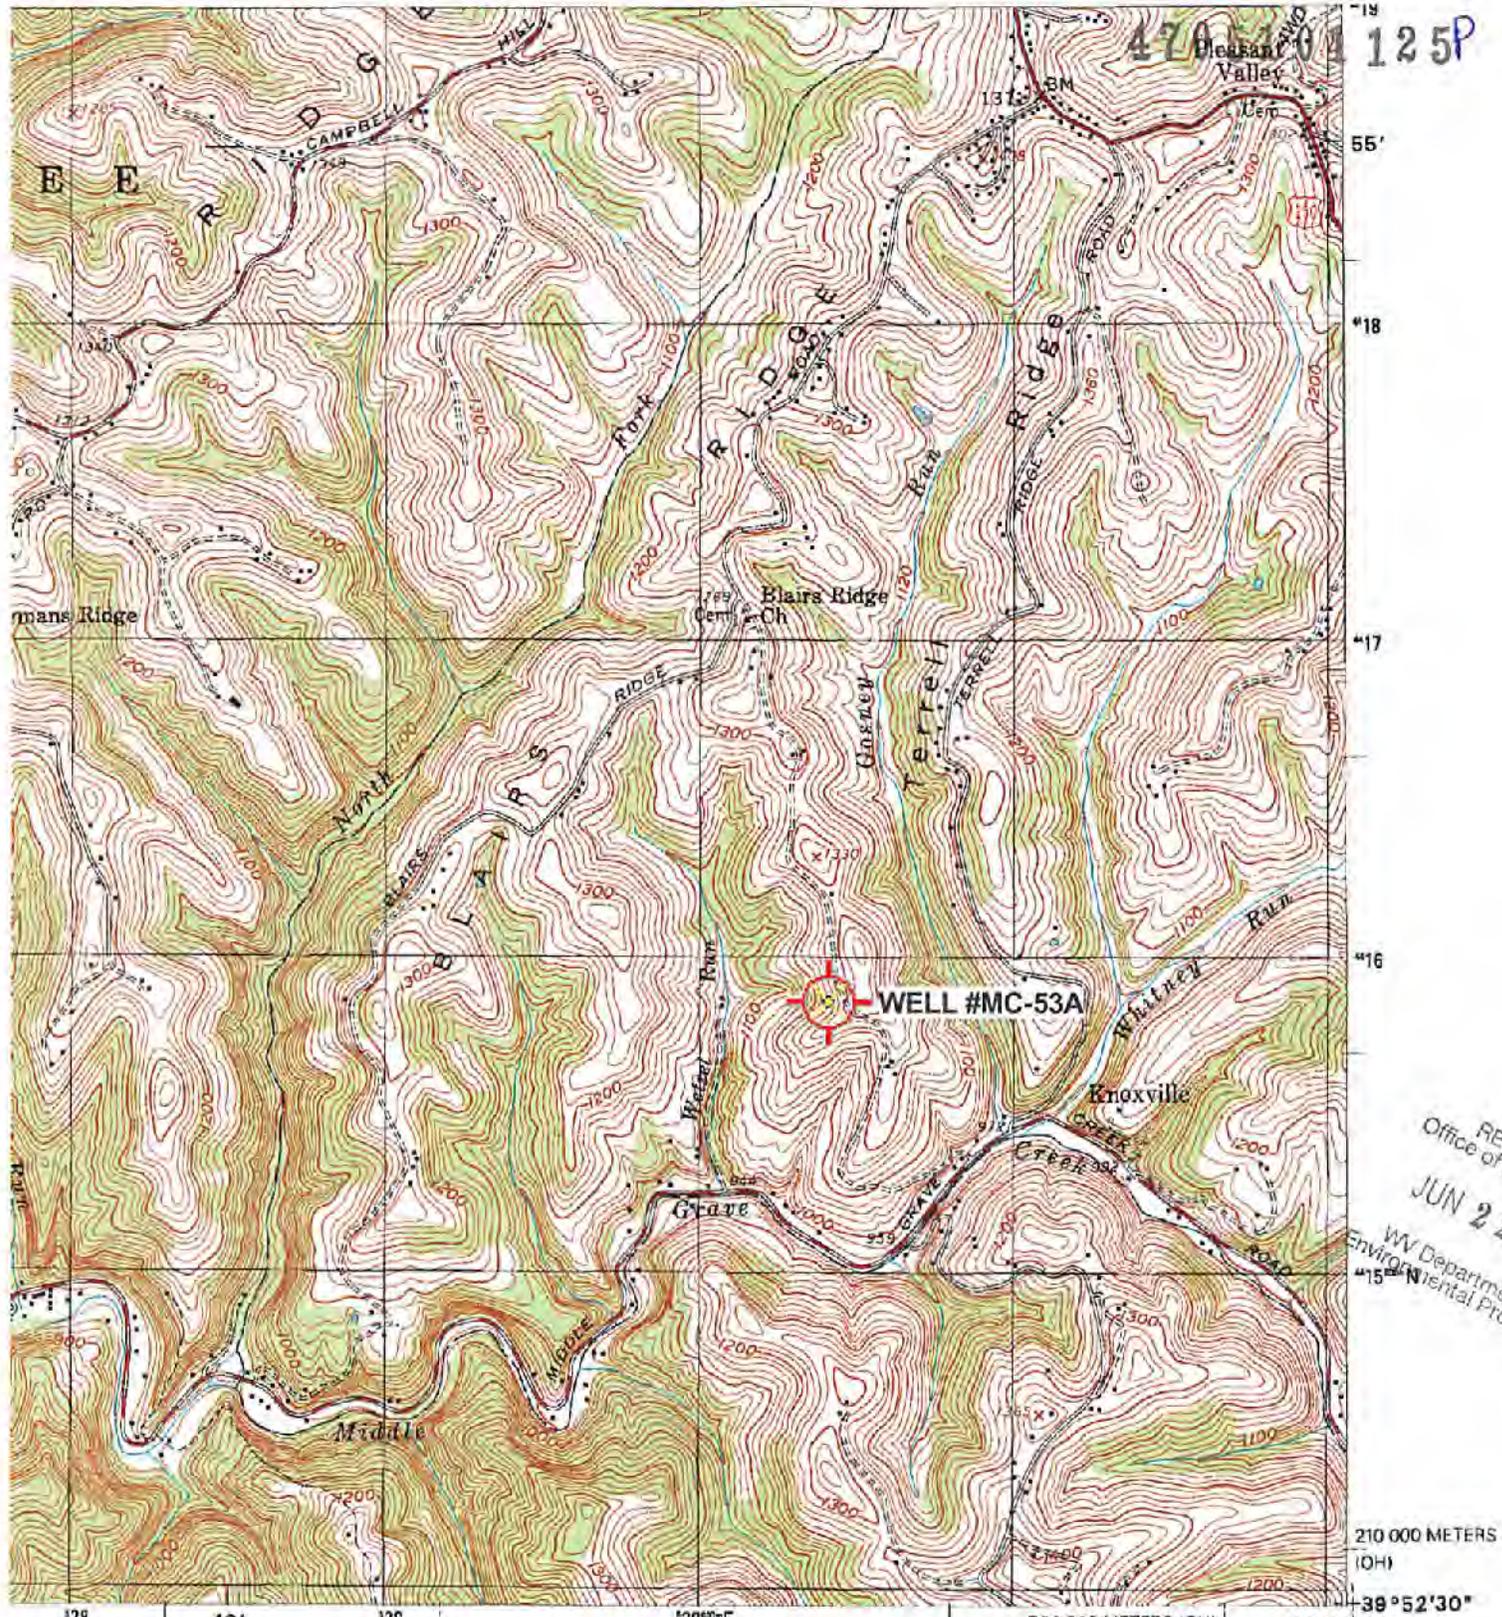

125P

55'

*18

*17

*16

*15

210 000 METERS (OH)


39°52'30"

80°37'30"

780 000 METERS (OH)

INTERIOR - GEOLOGICAL SURVEY, RESTON, VIRGINIA - 1999

RECEIVED
Office of Oil and Gas
JUN 22 2021
WV Department of Environmental Protection

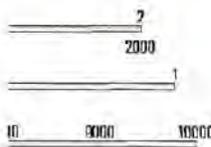

QUADRANGLE LOCATION

ROAD CLASSIFICATION

Primary highway hard surface	Light-duty road, hard or improved surface
Secondary highway hard surface	Unimproved road

Interstate Route
 U.S. Route
 State Route

1	2	3
4		5

- 1 Lansing
- 2 Wheeling
- 3 Valley Grove
- 4 Businessburg
- 5 Majorsville
- 6 Powhatan Point


MOUNDSVILLE, WV-OH

10/01/2021



"Moundsville"; WV,OH' Scale: 1" = 0.379Mi 610Mt 2,000Ft, 1 Mi = 2.640" , 1 cm = 240Mt

4705101125P

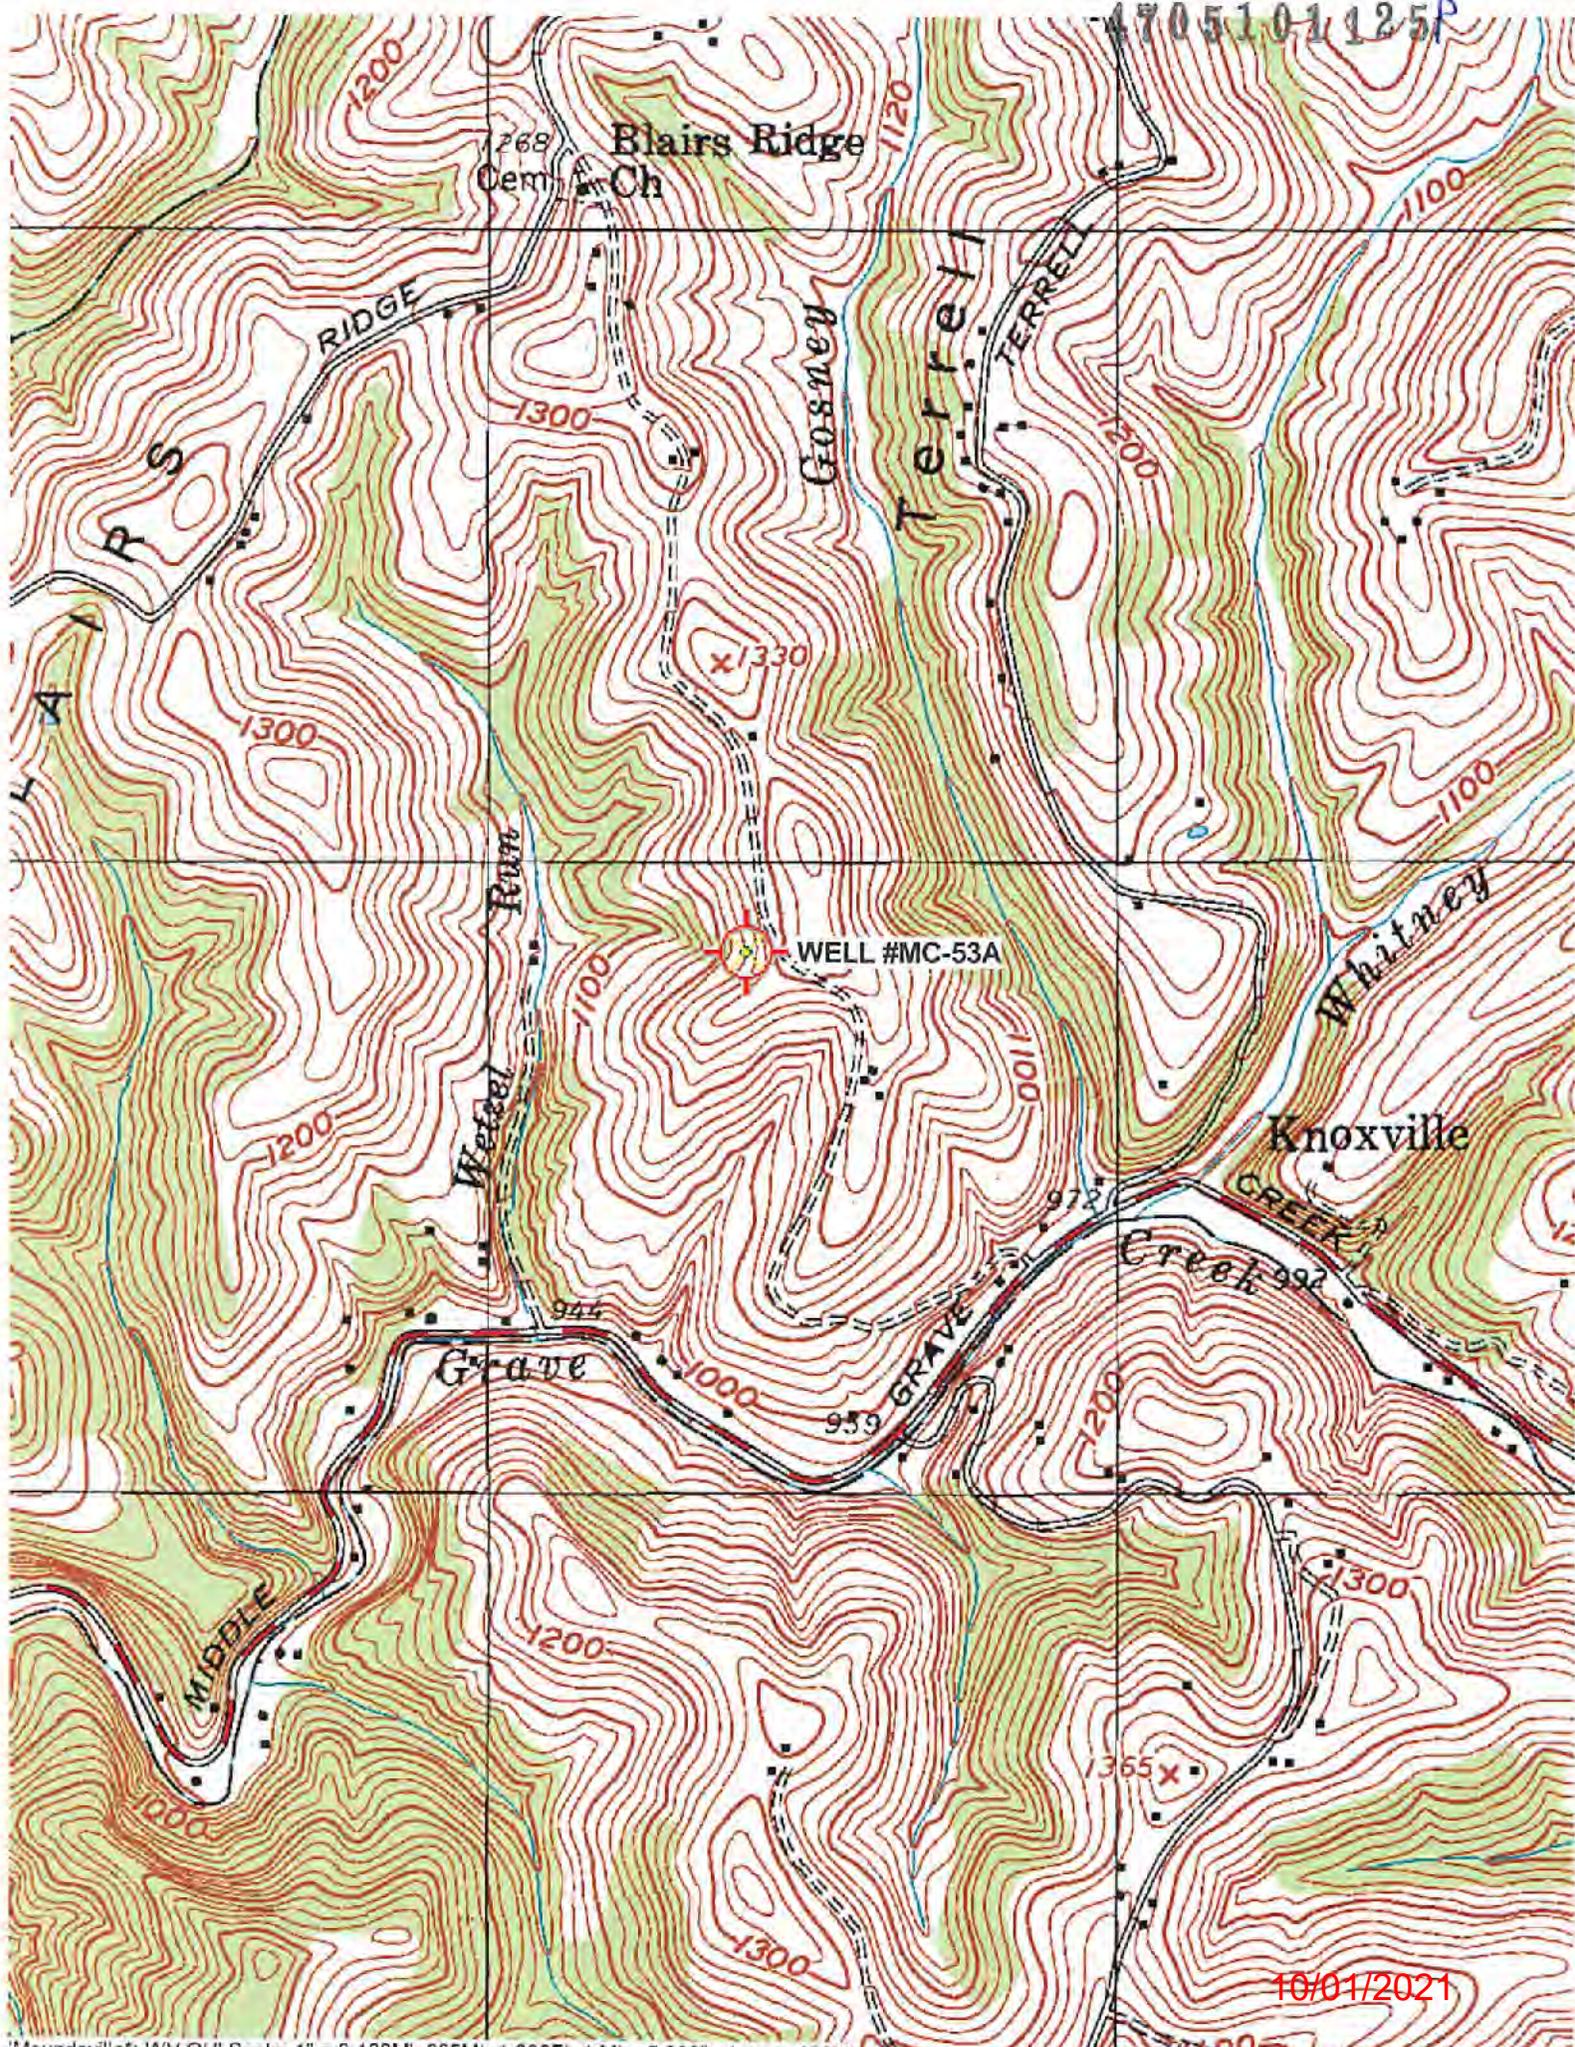

10/01/2021