

WW-7  
8-30-06



West Virginia Department of Environmental Protection  
Office of Oil and Gas  
**WELL LOCATION FORM: GPS**

API: 47-051-01152 WELL NO.: MC-19P

FARM NAME: JOHN D. CUMPSTON

RESPONSIBLE PARTY NAME: WEST VIRGINIA LAND RESOURCES INC.

COUNTY: MARSHALL DISTRICT: LIBERTY

QUADRANGLE: CAMERON WV, PA

SURFACE OWNER: JOHN D. CUMPSTON

ROYALTY OWNER: \_\_\_\_\_

UTM GPS NORTHING: 4,406,005 m

UTM GPS EASTING: 539,814 m GPS ELEVATION: 417 m (1368')

The Responsible Party named above has chosen to submit GPS coordinates in lieu of preparing a new well location plat for a plugging permit or assigned API number on the above well. The Office of Oil and Gas will not accept GPS coordinates that do not meet the following requirements:

- Datum: NAD 1983, Zone: 17 North, Coordinate Units: meters, Altitude: height above mean sea level (MSL) – meters.
- Accuracy to Datum – 3.05 meters
- Data Collection Method:

Survey grade GPS  : Post Processed Differential \_\_\_\_\_  
Real-Time Differential

Mapping Grade GPS \_\_\_\_\_ : Post Processed Differential \_\_\_\_\_  
Real-Time Differential \_\_\_\_\_

4. Letter size copy of the topography map showing the well location.

I the undersigned, hereby certify this data is correct to the best of my knowledge and belief and shows all the information required by law and the regulations issued and prescribed by the Office of Oil and Gas.


Signature

Professional Surveyor  
Title

MARCH 5, 2021  
Date

RECEIVED  
Office of Oil and Gas  
APR 8 2021  
WV Department of Environmental Protection

10/01/2021

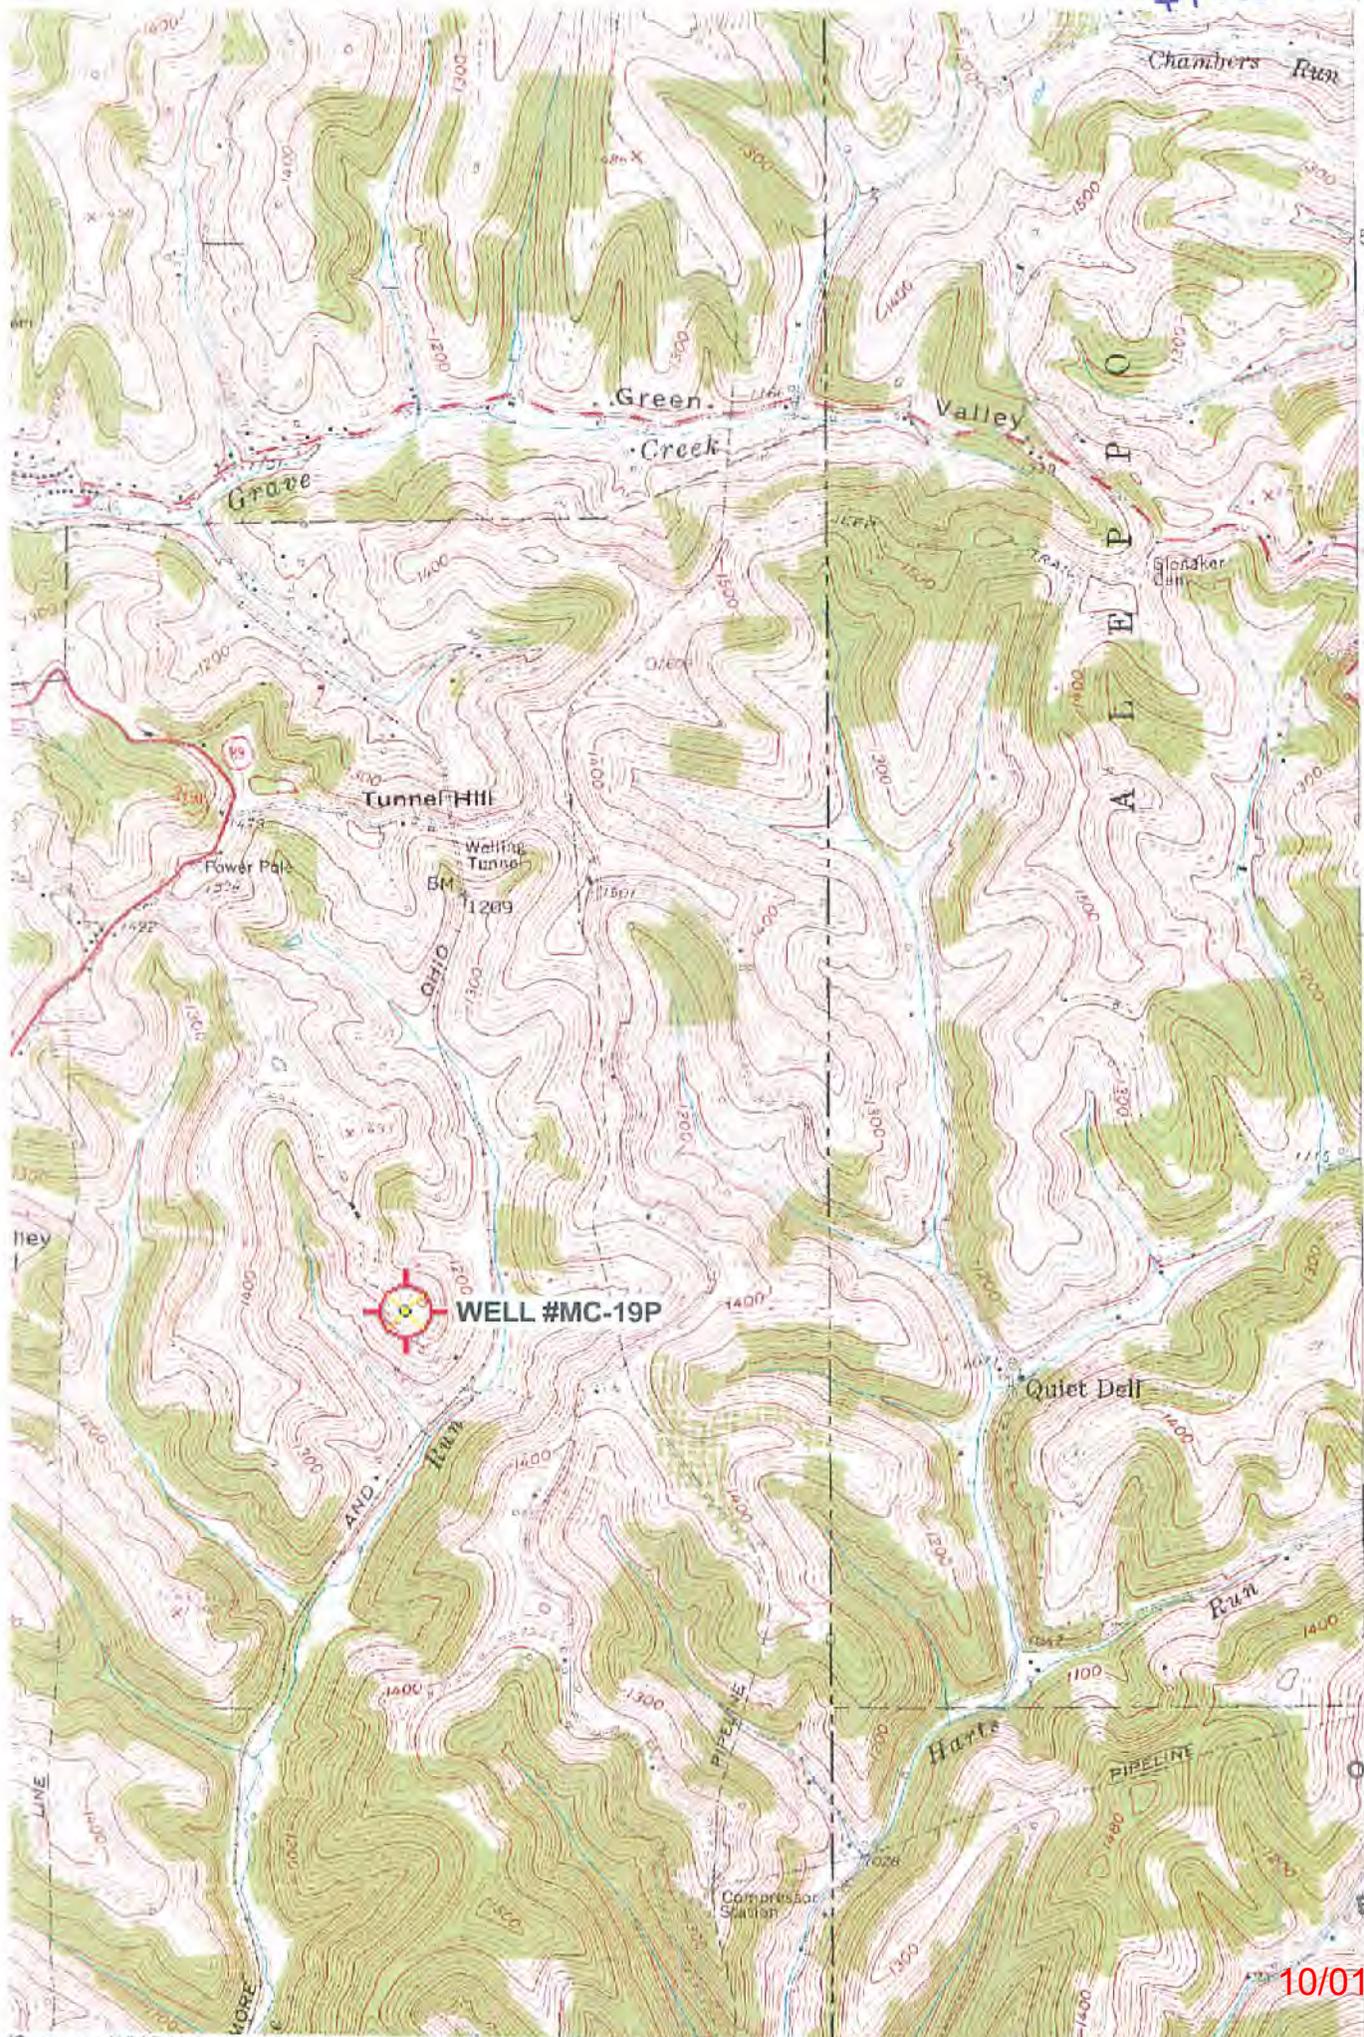

50'

4409

4408

4408







4406

4406

4406

4405

4405

47'30"

47'35"


RECEIVED  
Office of Oil and Gas

APR 8 2021

Environmental Protection

10/01/2021

47-051-01152P

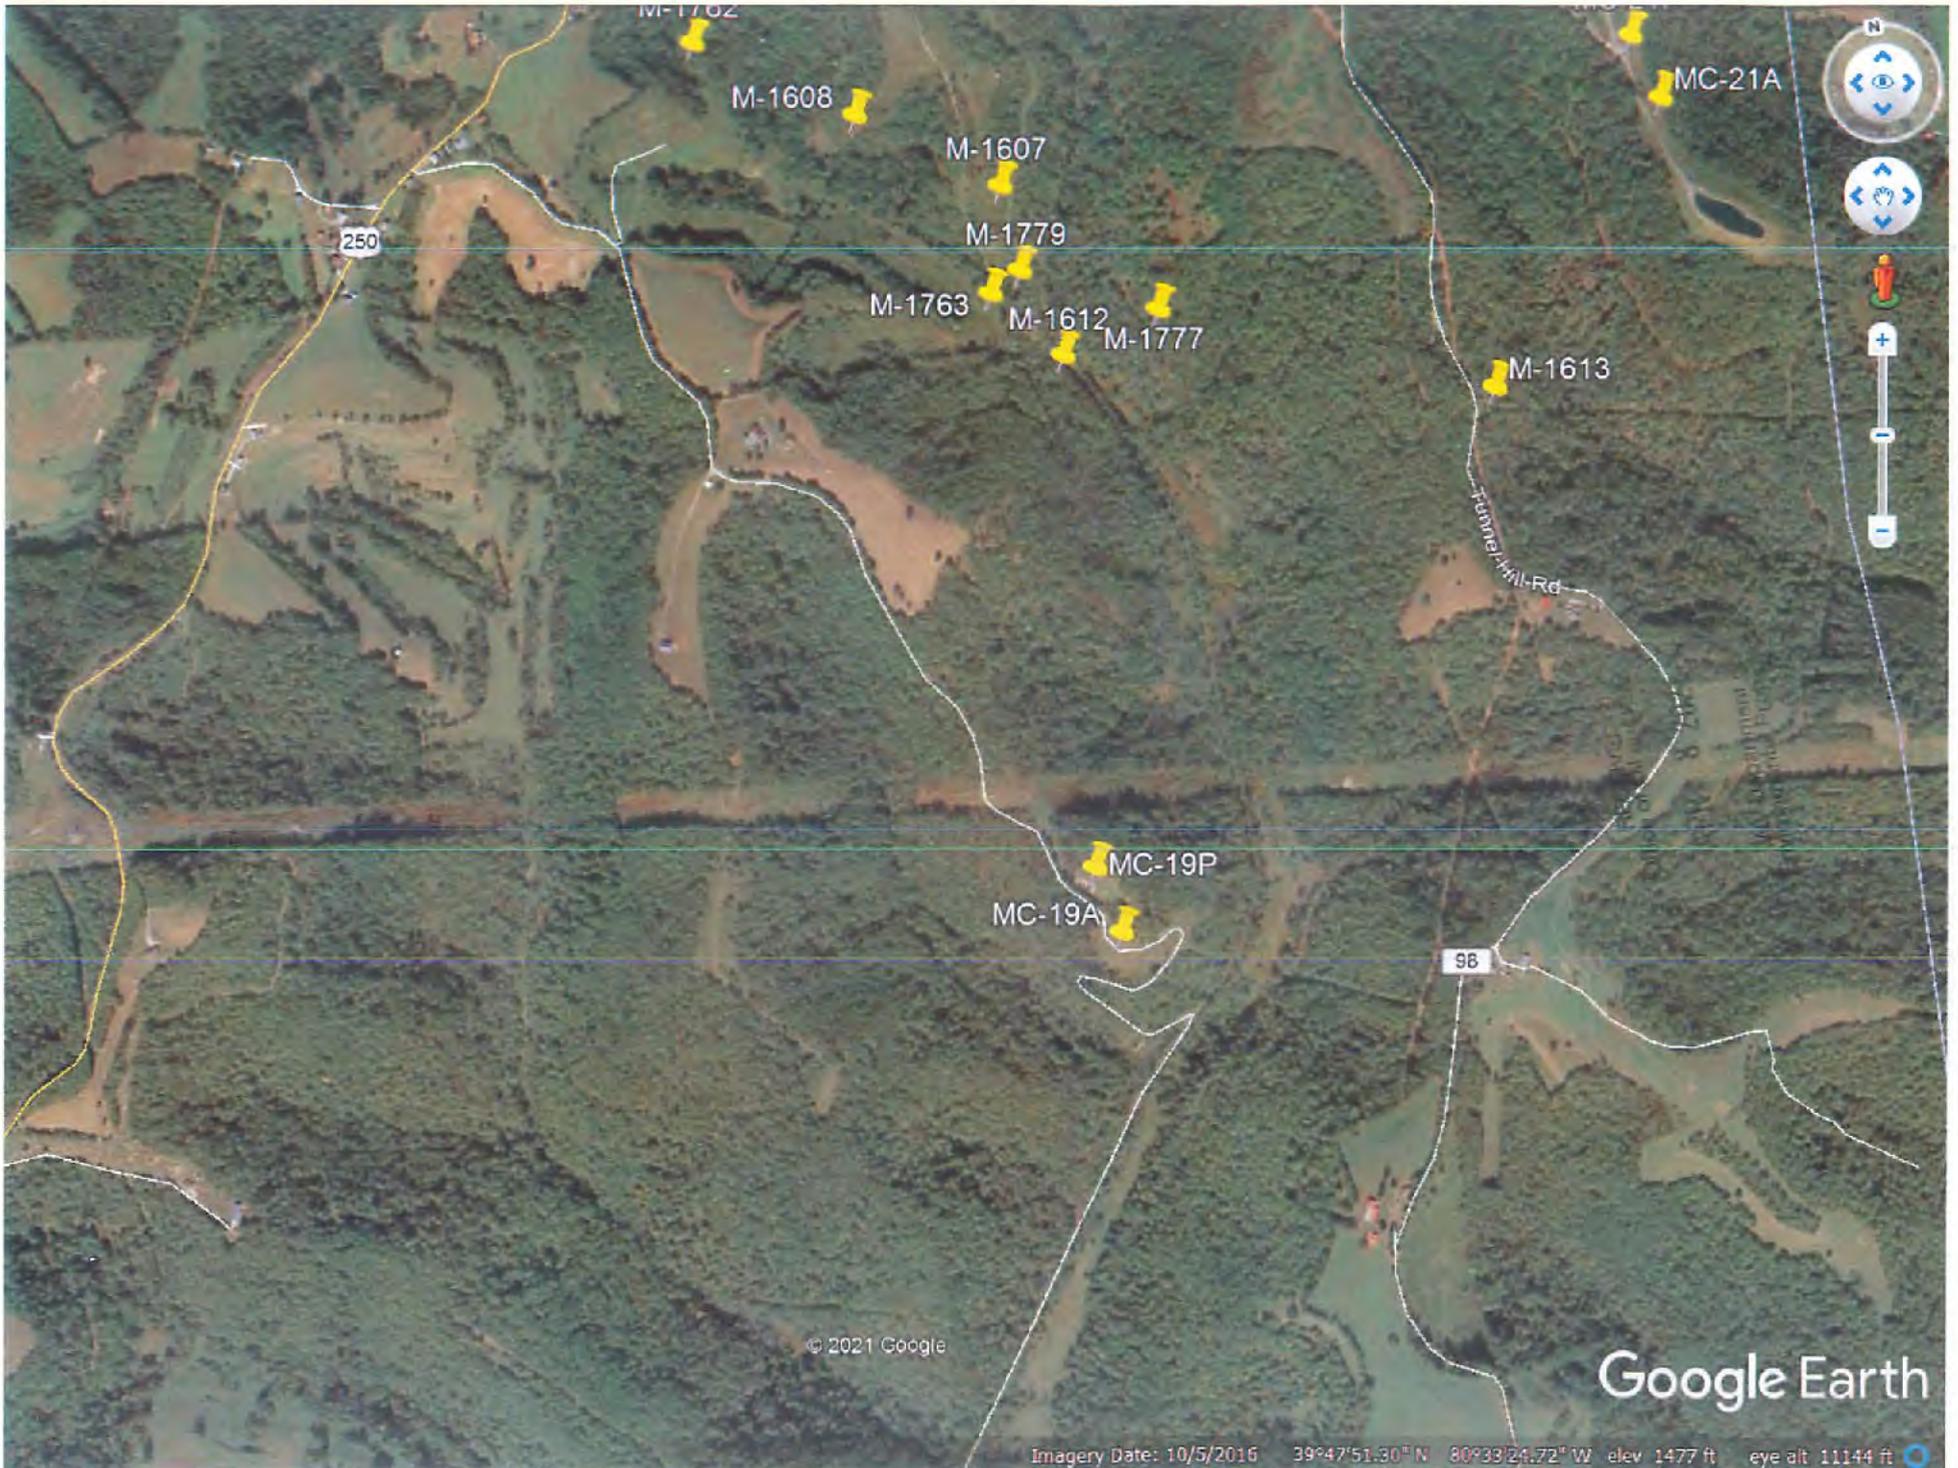


© 2021 Google

Google Earth

Imagery Date: 10/5/2016 39°47'51.30" N 80°33'24.72" W elev 1477 ft eye alt 11144 ft

4705101153P

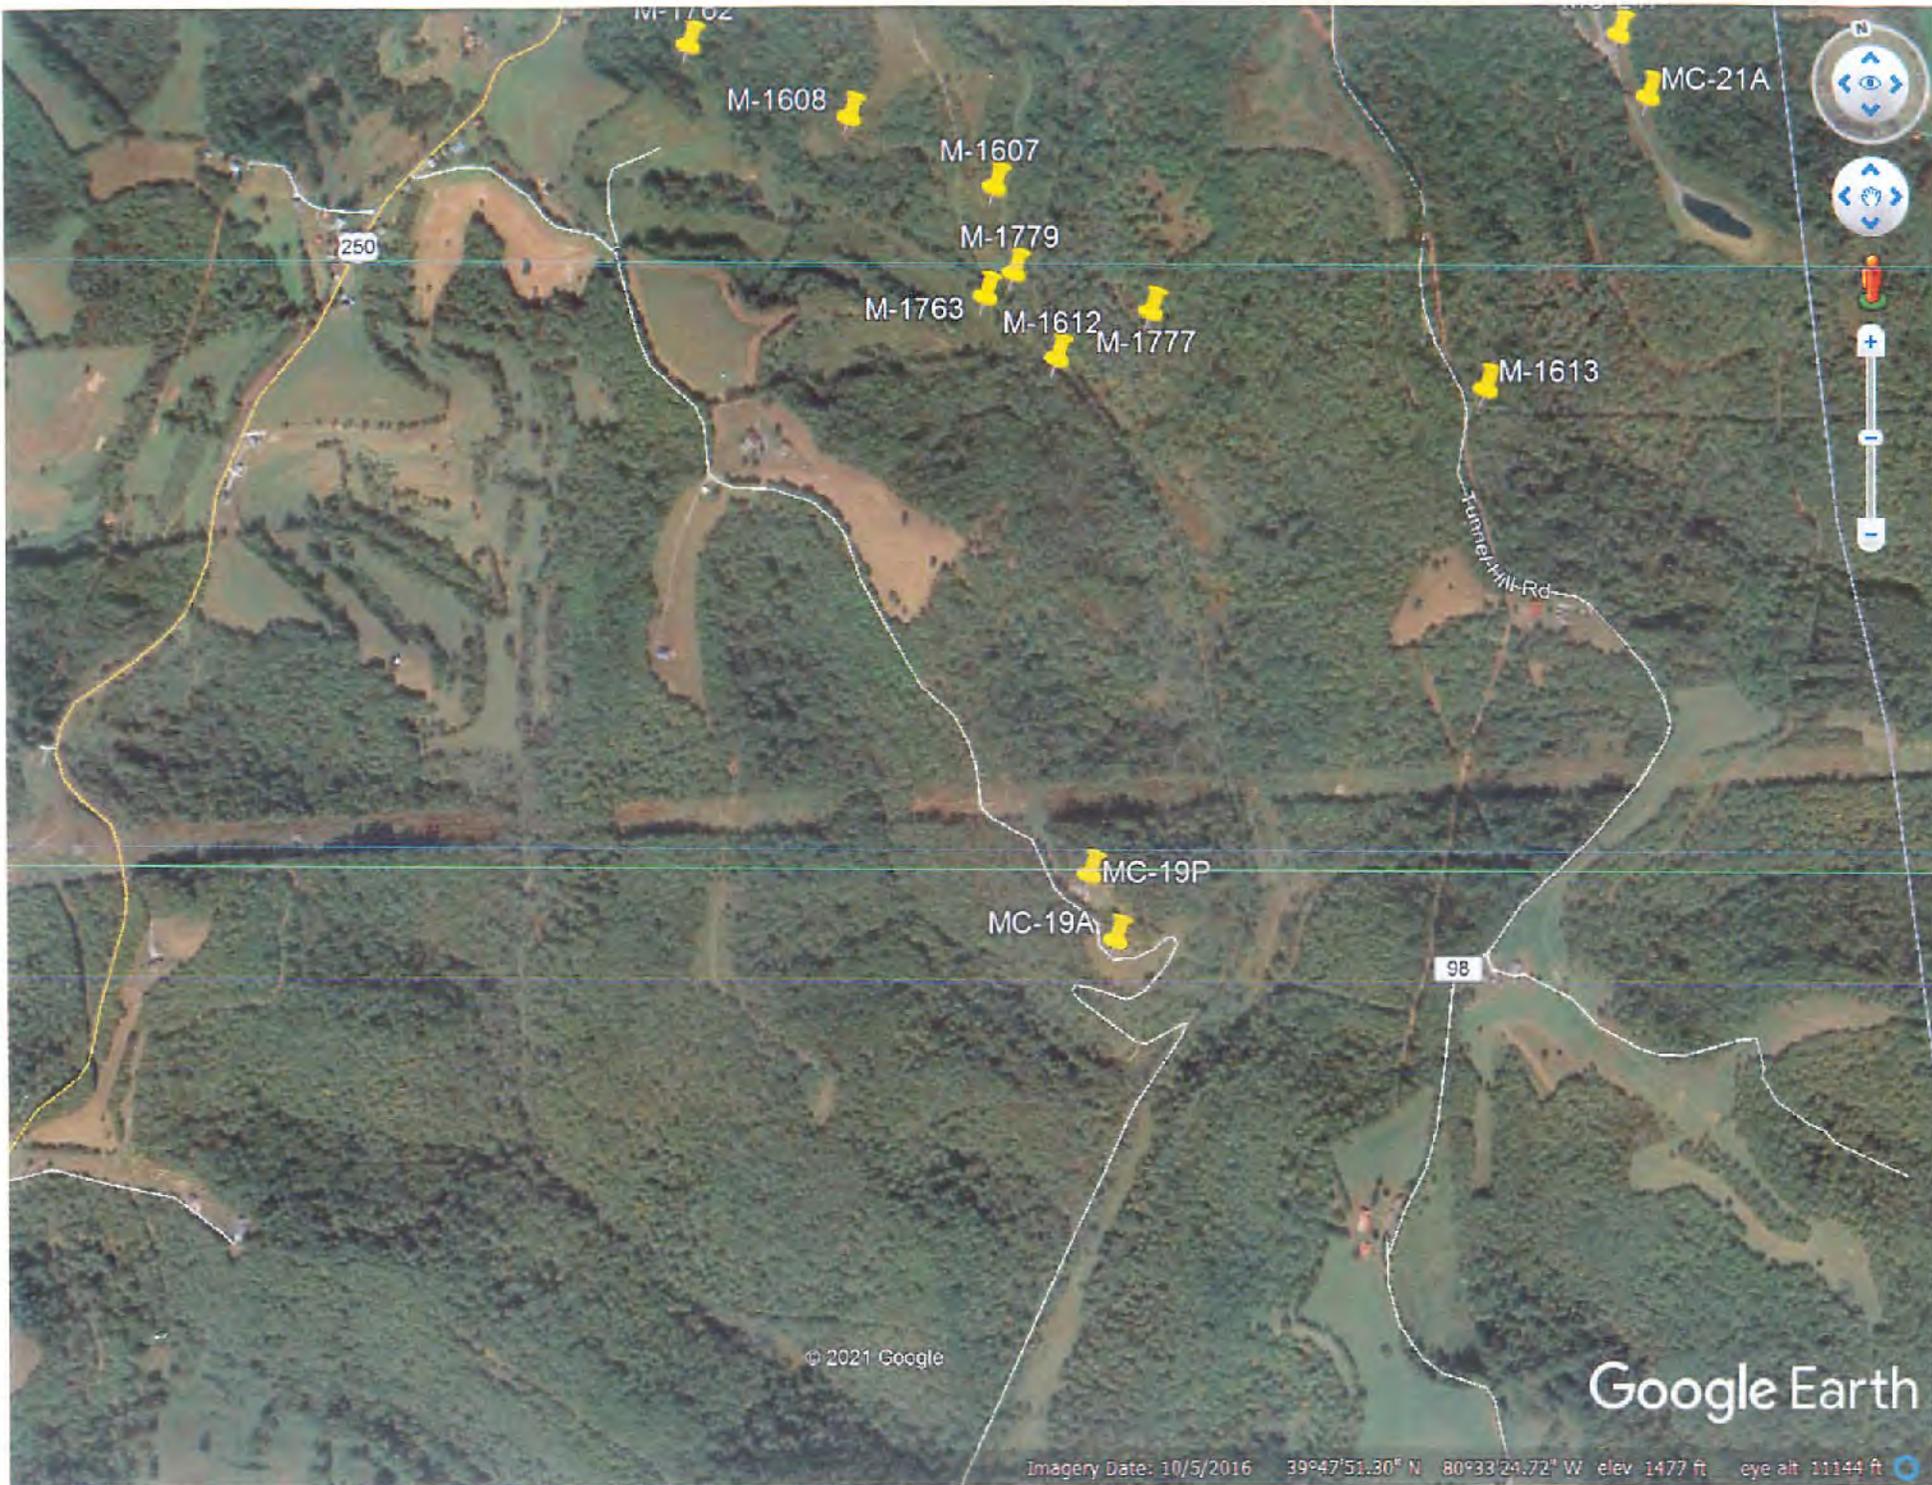


© 2021 Google

Google Earth

Imagery Date: 10/5/2016 39°47'51.30" N 80°33'24.72" W elev 1477 ft eye alt 11144 ft

47-051-01152P


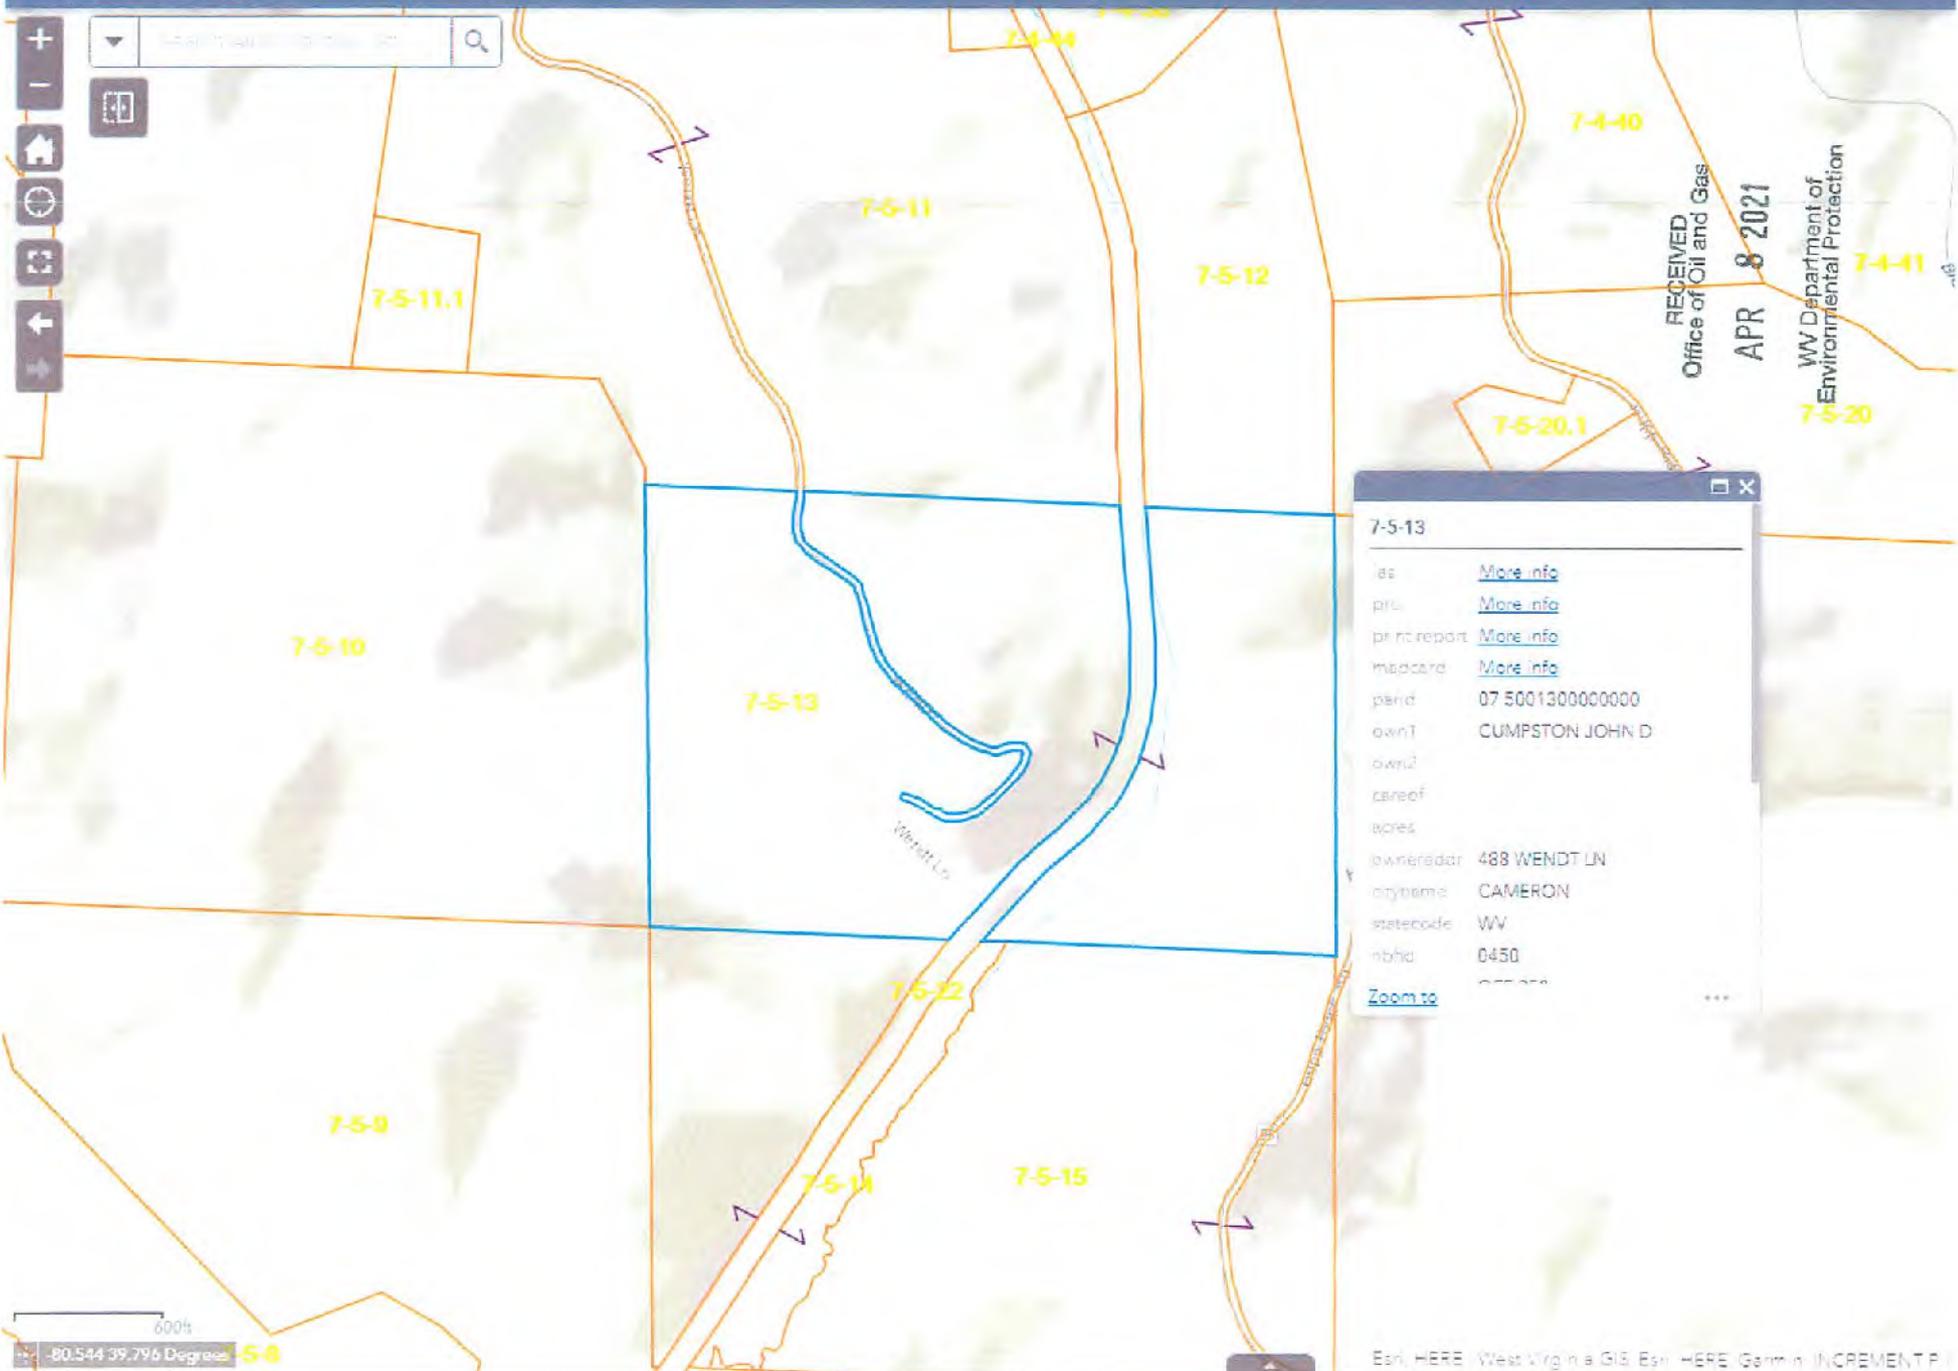

RECEIVED  
Office of Oil and Gas  
APR 8 2021  
WV Department of  
Environmental Protection

7-5-13

lat	<a href="#">More info</a>
prc	<a href="#">More info</a>
prnt report	<a href="#">More info</a>
mapcard	<a href="#">More info</a>
perid	07 5001300000000
own1	CUMPSTON JOHN D
own2	
careof	
acres	
owneraddr	488 WENDT LN
orgname	CAMERON
statecode	WV
nbhd	0450
...	...

[Zoom to](#) ...

600ft  
-80.544 39.796 Degrees -5-8