

WW-7
8-30-06



West Virginia Department of Environmental Protection
Office of Oil and Gas
WELL LOCATION FORM: GPS

API: 47-051-01153 WELL NO.: MC-19A

FARM NAME: JOHN D. CUMPSTON

RESPONSIBLE PARTY NAME: WEST VIRGINIA LAND RESOURCES INC.

COUNTY: MARSHALL DISTRICT: LIBERTY

QUADRANGLE: CAMERON WV, PA

SURFACE OWNER: JOHN D. CUMPSTON

ROYALTY OWNER: _____

UTM GPS NORTHING: 4,405,894 m

(1276')

UTM GPS EASTING: 539,843 m GPS ELEVATION: 389 m

The Responsible Party named above has chosen to submit GPS coordinates in lieu of preparing a new well location plat for a plugging permit or assigned API number on the above well. The Office of Oil and Gas will not accept GPS coordinates that do not meet the following requirements:


- Datum: NAD 1983, Zone: 17 North, Coordinate Units: meters, Altitude: height above mean sea level (MSL) – meters.
- Accuracy to Datum – 3.05 meters
- Data Collection Method:

Survey grade GPS : Post Processed Differential _____
Real-Time Differential

Mapping Grade GPS _____ : Post Processed Differential _____
Real-Time Differential _____

- Letter size copy of the topography map showing the well location.

I the undersigned, hereby certify this data is correct to the best of my knowledge and belief and shows all the information required by law and the regulations issued and prescribed by the Office of Oil and Gas.

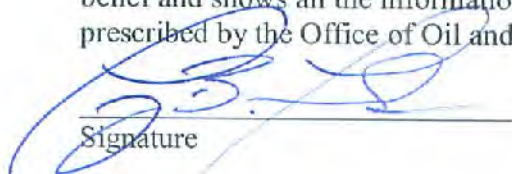
Signature

Professional Surveyor
Title


MARCH 3, 2021
Date

RECEIVED
Office of Oil and Gas

APR 8 2021

10/01/2021

47-051-01153C1

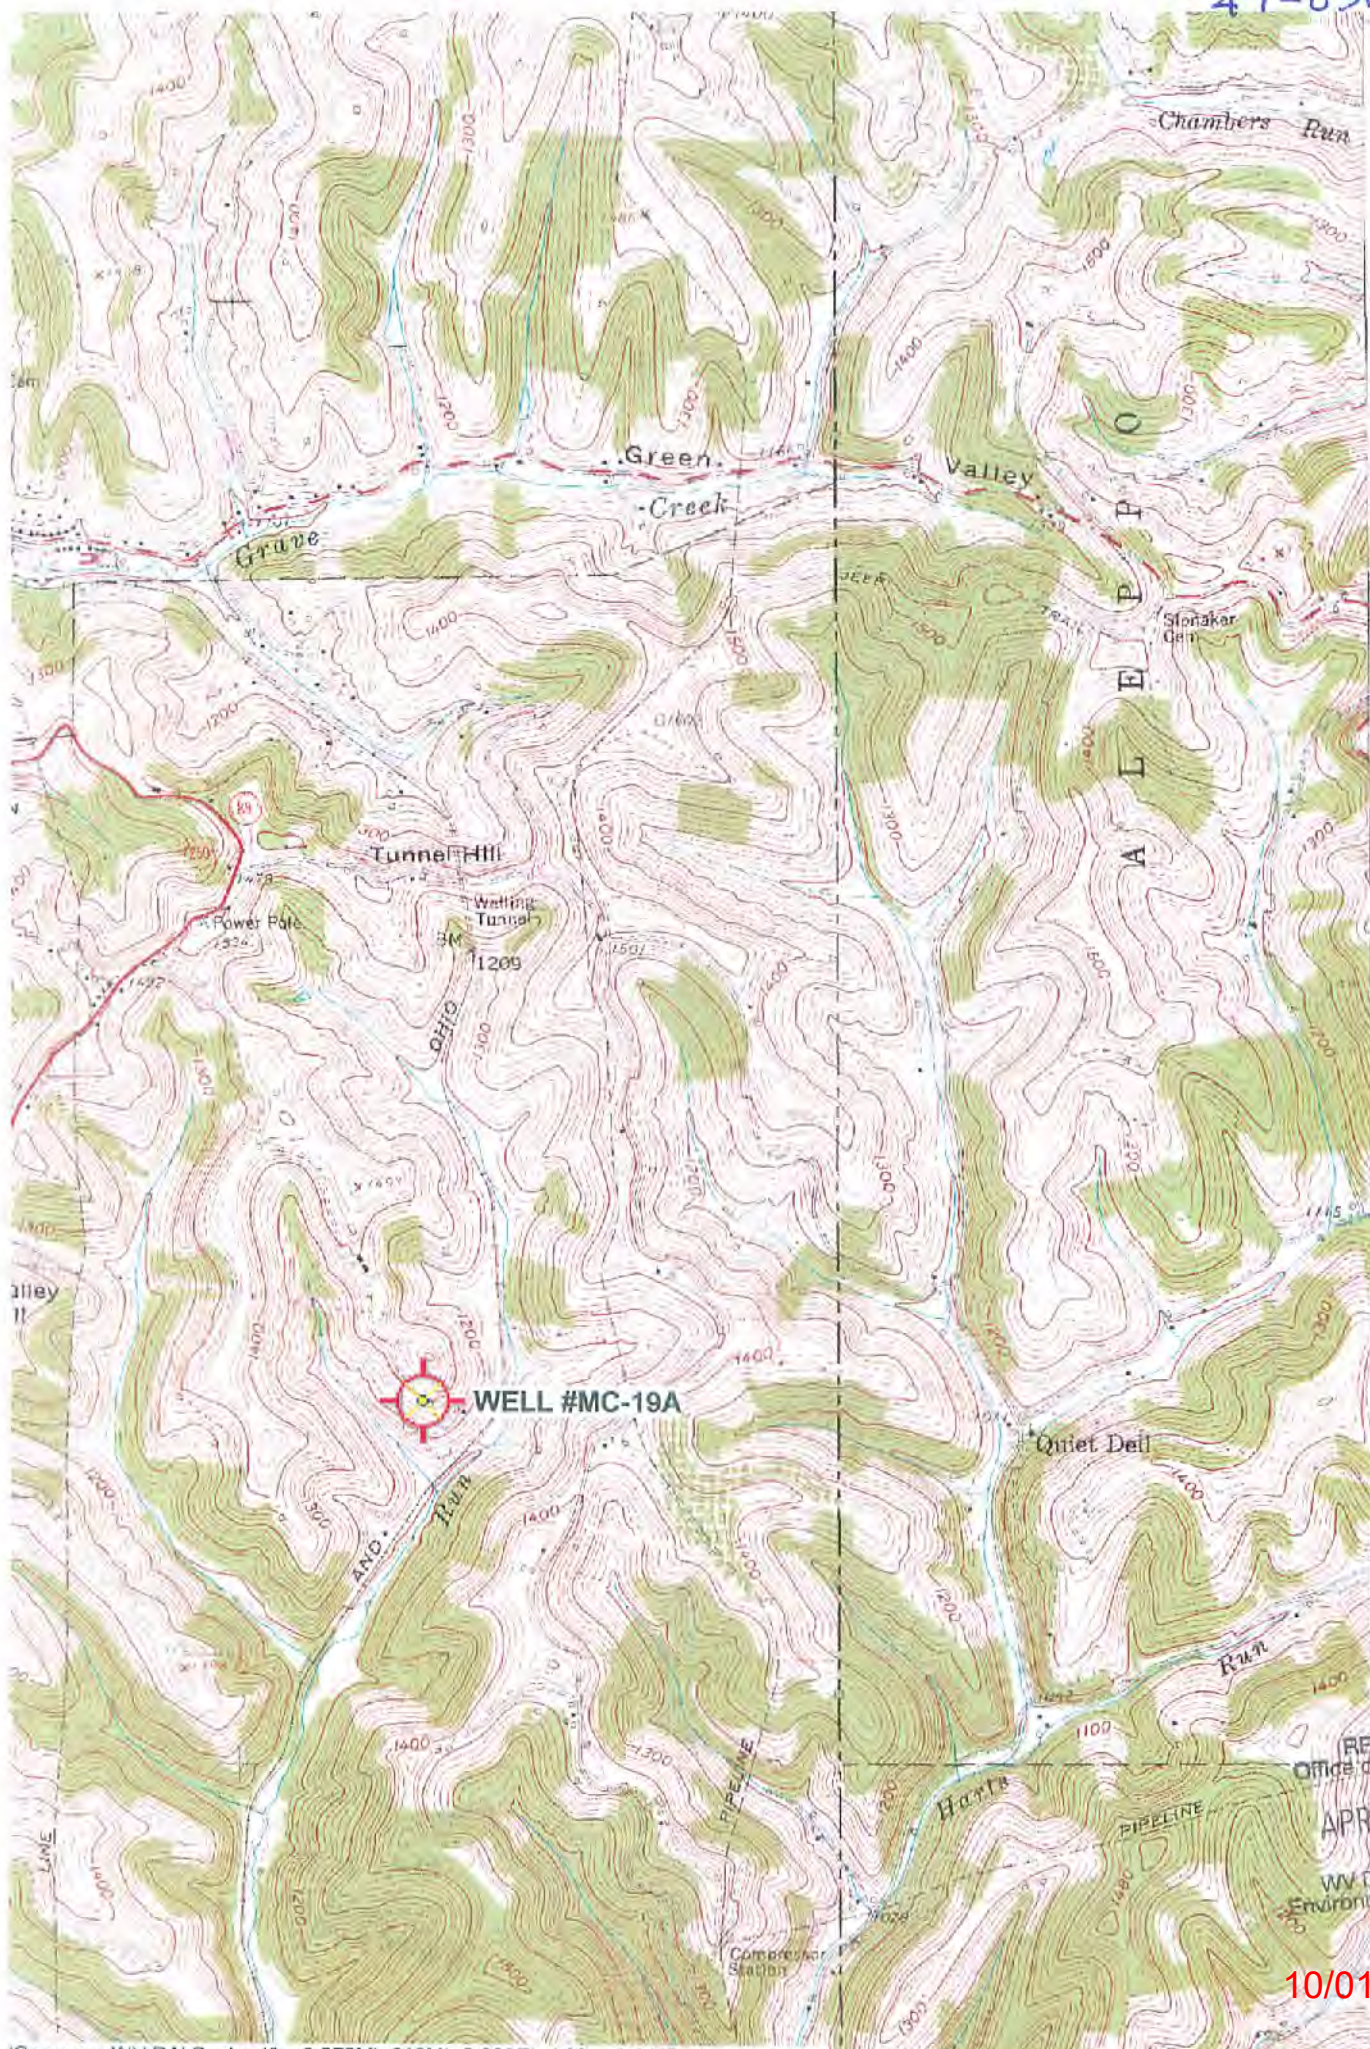

4410
50'
4409
4408
(NEW FREIGHT)
4963 IV SW
4406
4405

WELL #MC-19A

RECEIVED
Office of Oil and Gas
APR 8 2021
WV Department of
Environmental Protection

10/01/2021

4705101153P



RECEIVED
Office of Oil and Gas

APR 8 2021

WV Department of
Environmental Protection

4705101153

Search All or Choose Layer



RECEIVED
Office of Citizens' Int.
APR 18 2012
WV Department of
Environmental Protection

7-5-13

id: [More info](#)

pid: [More info](#)

pin: [More info](#)

perc: [More info](#)

medcard: [More info](#)

perc: 07 5001300000000

own1: CUMPSTON JOHN D

own2:

careof:

acres:

owneraddr: 488 WENDT LN

cityname: CAMERON

statecode: WV

rbhd: 0450

zoning: 000000

[Zoom to](#)

300ft
-80.536 39.799 Degrees

4705101153

