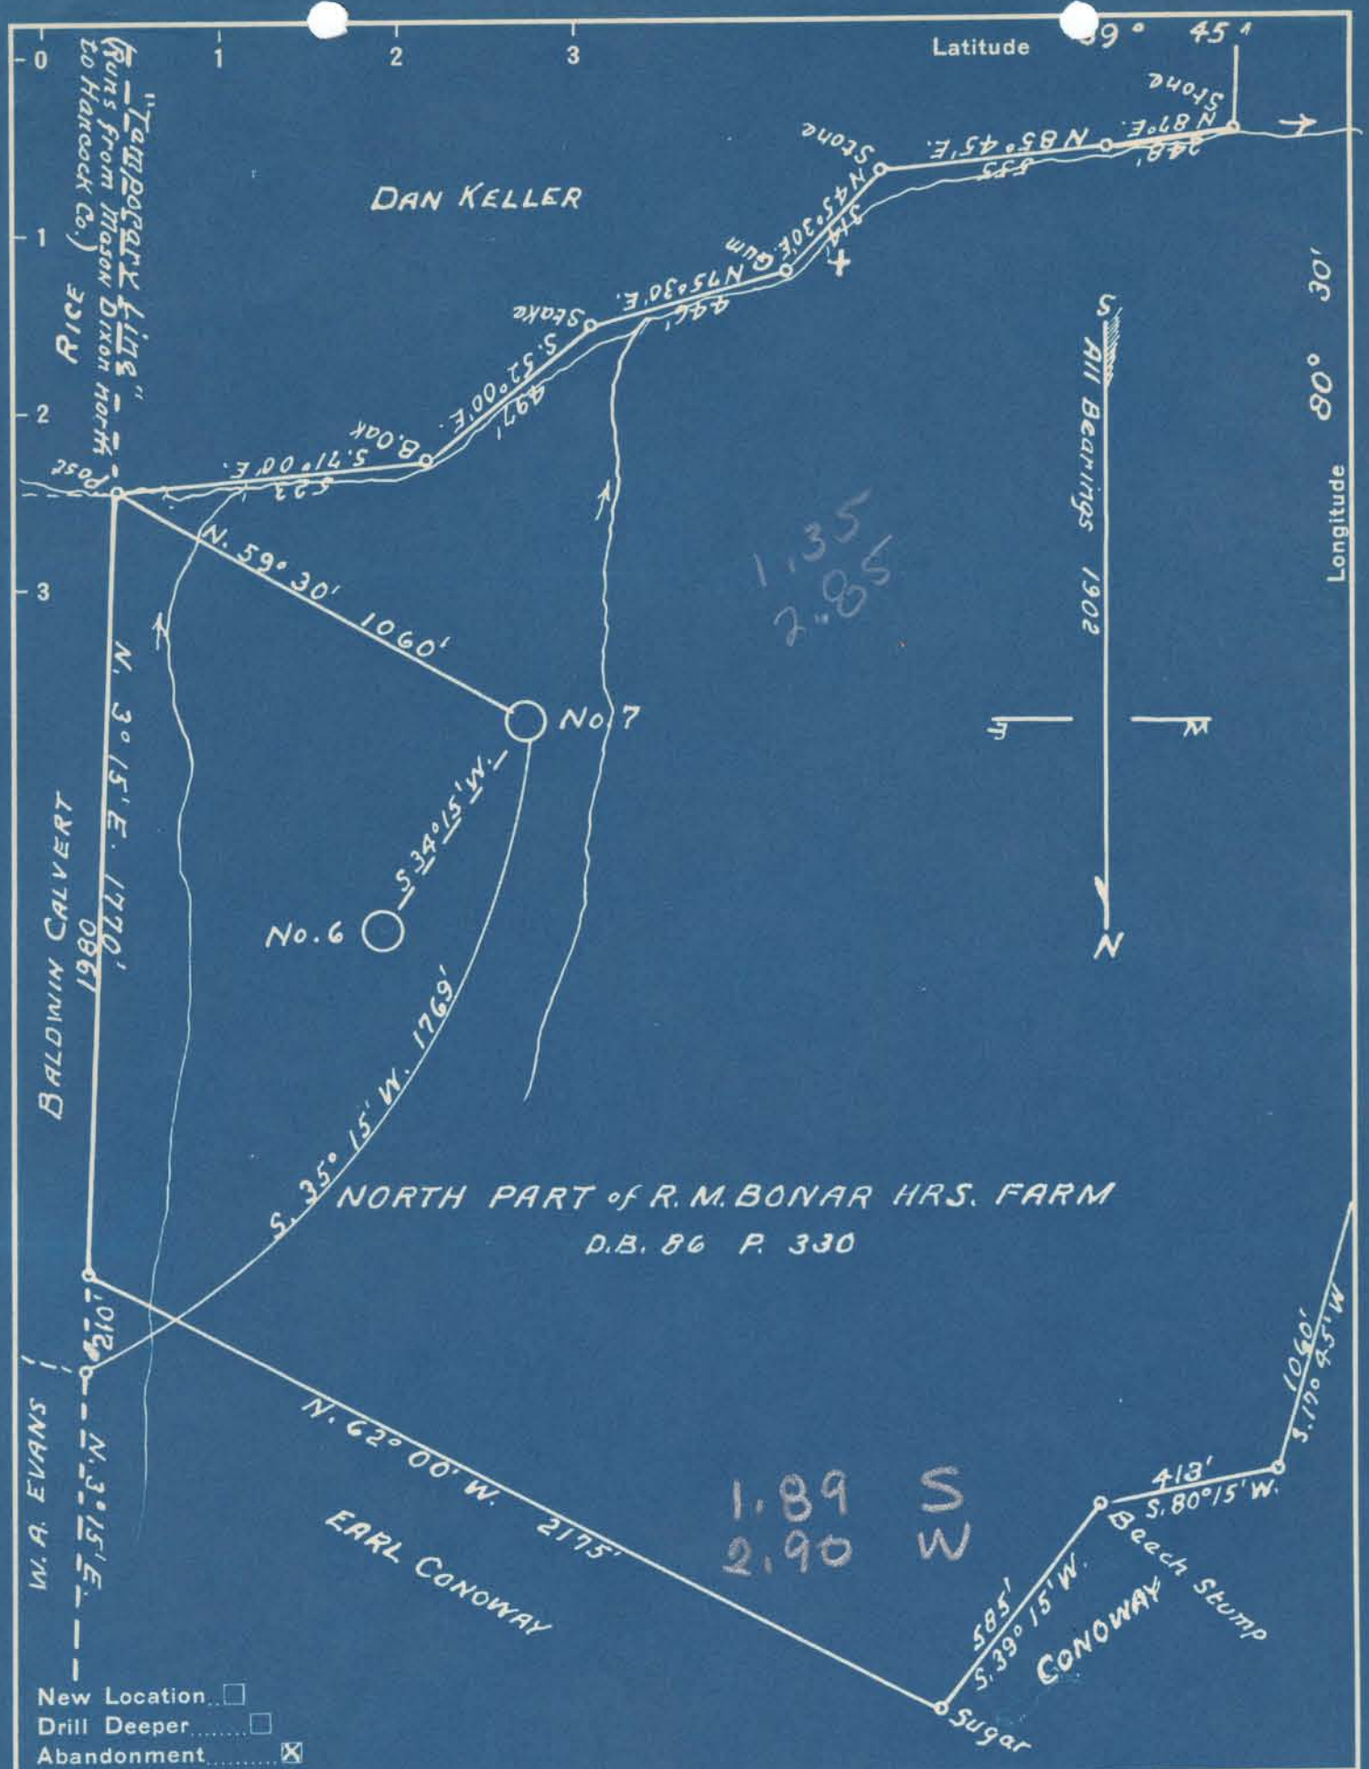

Company DENVER OIL & GAS CO.

Address CAMERON, W. VA.

Farm R. M. BONAR HRS. NE

Tract _____ Acres 256.1 Lease No. _____

Well (Farm) No. 7 Serial No. _____

Elevation (Spirit Level) 1209

Quadrangle CAMERON

County MARSHALL District LIBERTY

Engineer GORDON W. SAMMONS

Engineer's Registration No. 509

File No. _____ Drawing No. _____

Date 7-3-1948 Scale 1" = 400'

"IMPERIAL" TRACING CLOTH
K & E CO., N. Y.

STATE OF WEST VIRGINIA
DEPARTMENT OF MINES
OIL AND GAS DIVISION
CHARLESTON

WELL LOCATION MAP

FILE NO. MARS-283-A-#7

+ Denotes location of well on United States Topographic Maps, scale 1 to 62,500, latitude and longitude lines being represented by border lines as shown.

— Denotes one inch spaces on border line of original tracing.

(042)