


Cameron dist

39°50'

80°35'

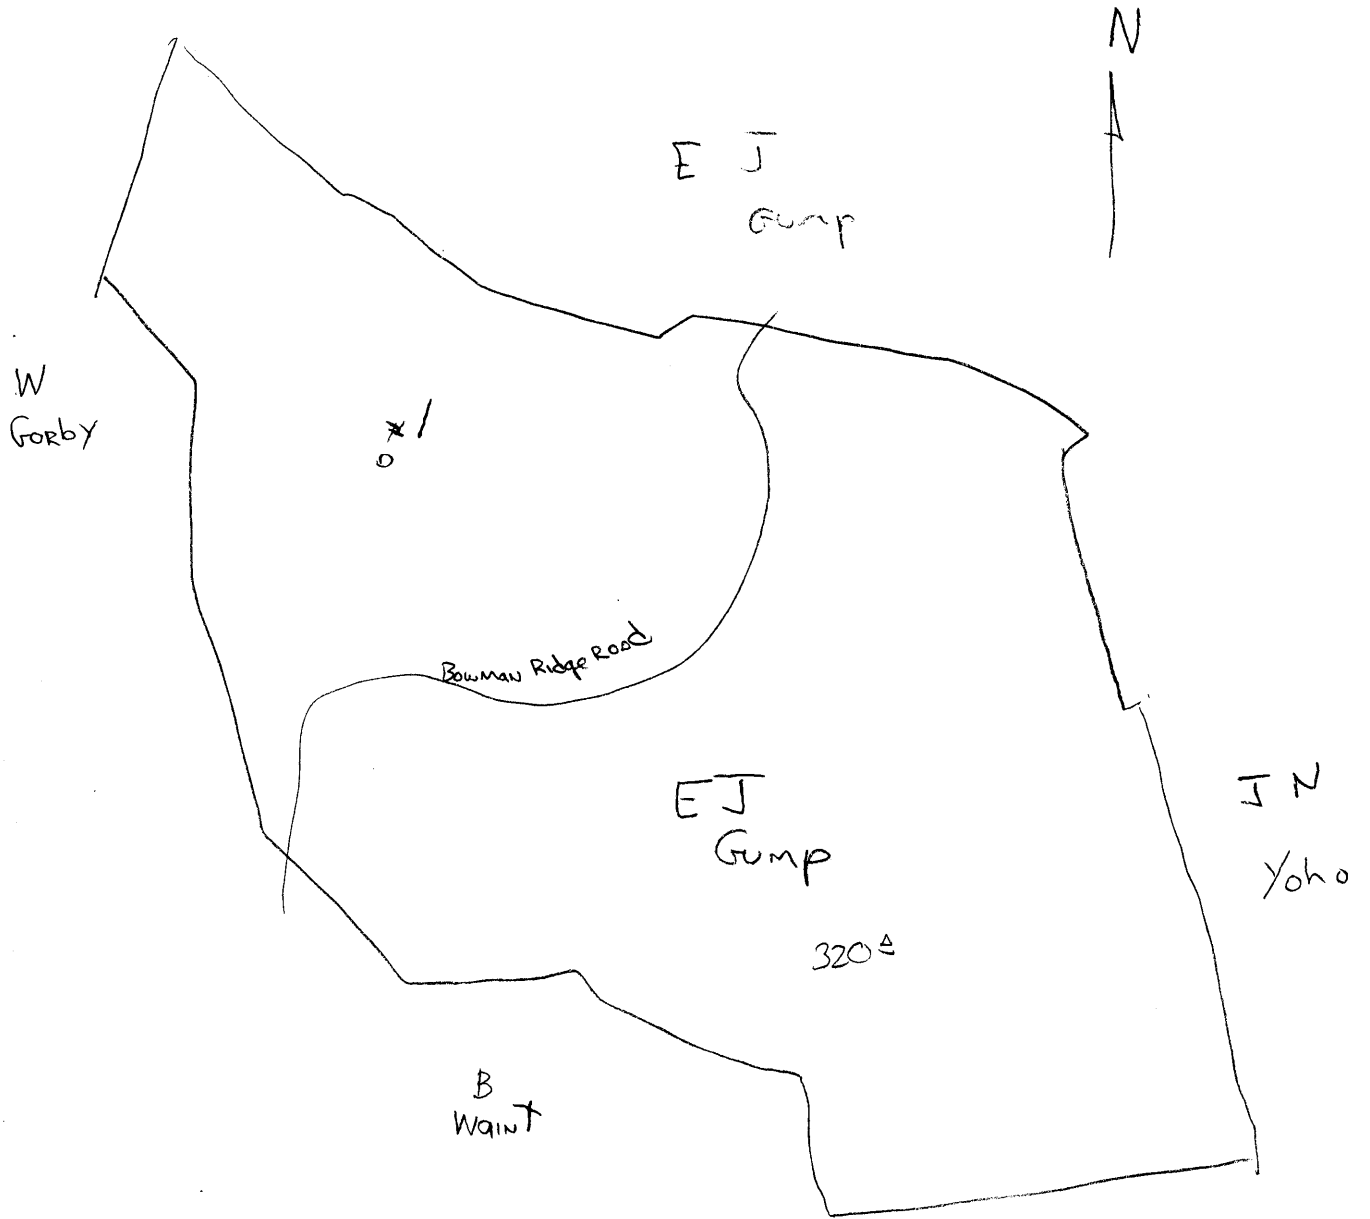

30329