

6100554P

WW-7  
5-02

West Virginia Department of Environmental Protection  
Office of Oil & Gas

**WELL LOCATION FORM: GPS**

API: 47- 061 - 0554 WELL NO: No.2

FARM NAME: James Eddy

RESPONSIBLE PARTY NAME: HG Energy, LLC

COUNTY: Monongalia DISTRICT: Clay (2)

QUADRANGLE: Blacksville 7.5'

SURFACE OWNER: Darrell & Almeida Eddy

ROYALTY OWNER: HG Energy LLC et al.

UTM GPS NORTHING: 4,386,999

UTM GPS EASTING: 568,396 GPS ELEVATION: 348 m.


The Responsible Party named above has chosen to submit GPS coordinates in lieu of preparing a new well location plat for a plugging permit on the above well. The Office of Oil & Gas will not accept GPS coordinates that do not meet the following requirements:

1. Datum: NAD 1983, Zone: 17 North, Coordinate Units: meters, Altitude: height above mean sea level (MSL) - meters.
2. Accuracy to Datum - 3.05 meters
3. Data Collection Method:

Survey Grade GPS  Post Processed Differential   
 Real-Time Differential

Mapping Grade GPS  Post Processed Differential   
 Real-Time Differential

I the undersigned, hereby certify this data is correct to the best of my knowledge and belief and shows all the information required by law and the regulations issued and prescribed by the Office of Oil and Gas.

  
Signature Timothy P. Roush


Professional Surveyor  
Title

February 13, 2013  
Date

RECEIVED  
APR 9 2013  
Department of Environmental Protection

04/19/2013

SUBJECT WELL  
James Eddy No.2  
47-061-0554

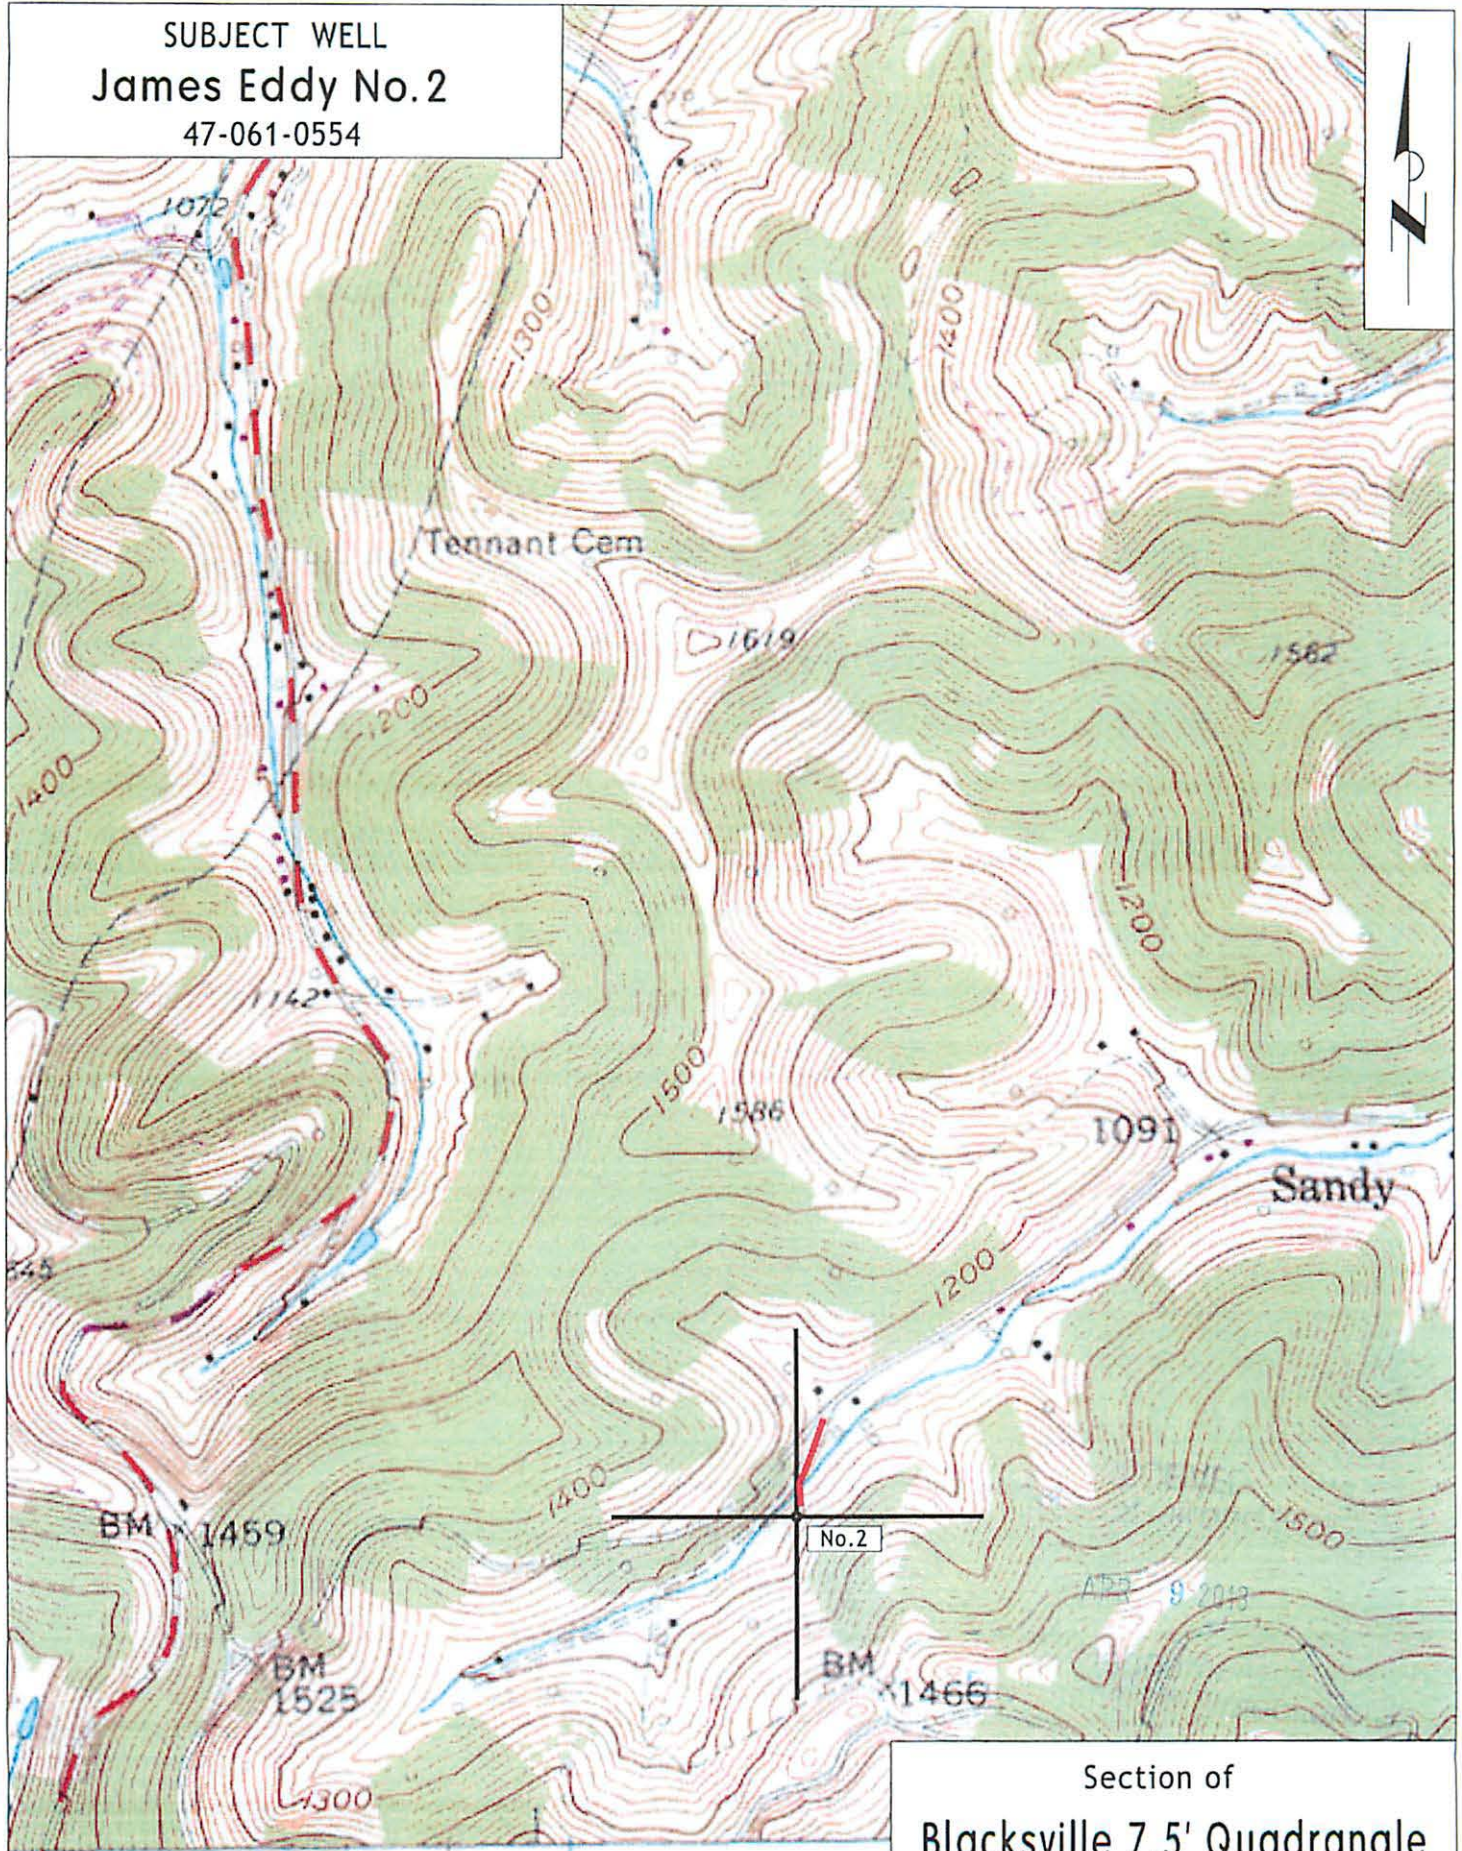

7 FAIRVIEW 2.7 MI.  
GRANT TOWN 7.3 MI

12'30"

Section of  
Blacksville 7.5' Quadrangle

SCALE 1"=1000'  
APR 9 2013