


FILE NO. _____
 DRAWING NO. _____
 SCALE 1" = 300'
 MINIMUM DEGREE OF ACCURACY 1:6000
 PROVEN SOURCE OF ELEVATION COMPANY SURVEY TIED INTO U.S.G.S. NETWORK

I THE UNDERSIGNED, HEREBY CERTIFY THAT THIS PLAT IS CORRECT TO THE BEST OF MY KNOWLEDGE AND BELIEF AND SHOWS ALL THE INFORMATION REQUIRED BY LAW AND THE REGULATIONS ISSUED AND PRESCRIBED BY THE DEPARTMENT OF MINES.
 (SIGNED) Robert Nelson McCoy
 R.P.E. _____ L.L.S. 110

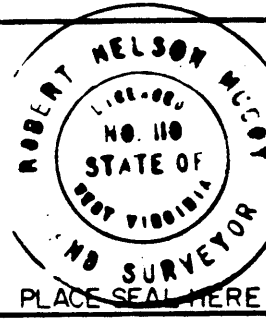

(+) DENOTES LOCATION OF WELL ON UNITED STATES TOPOGRAPHIC MAPS
 FORM IV-6 (8-78)



STATE OF WEST VIRGINIA
 DEPARTMENT OF MINES
 OIL AND GAS DIVISION

DATE FEBRUARY 3, 1982
 OPERATOR'S WELL NO. 4258
 API WELL NO. _____
47 - 061 - 0647-R-P
 STATE COUNTY PERMIT
 # 106
 1912 GRt
 # 70214

WELL TYPE: OIL GAS _____ LIQUID INJECTION _____ WASTE DISPOSAL _____
 (IF "GAS") PRODUCTION _____ STORAGE _____ DEEP _____ SHALLOW _____
 LOCATION: ELEVATION 1445.98 WATER SHED RANGE RUN
 DISTRICT BATTELLE COUNTY MONONGALIA
 QUADRANGLE WADESTOWN, 7 1/2 MINUTE SERIES
 SURFACE OWNER ROBERT FLUHARTY ACREAGE 29
 OIL & GAS ROYALTY OWNER _____ LEASE ACREAGE _____
 LEASE NO. _____
 PROPOSED WORK: DRILL _____ CONVERT _____ DRILL DEEPER _____ REDRILL FRACTURE OR STIMULATE _____ PLUG OFF OLD FORMATION PERFORATE NEW FORMATION _____ OTHER PHYSICAL CHANGE IN WELL (SPECIFY) _____

MAR 29 1982

PLUG AND ABANDON CLEAN OUT AND REPLUG _____
 TARGET FORMATION _____ ESTIMATED DEPTH UNKNOWN
 WELL OPERATOR CONSOLIDATION COAL COMPANY DESIGNATED AGENT GEORGE M. CONNER
 ADDRESS P.O. BOX 1314 ADDRESS P.O. BOX 1314
MORGANTOWN, WV 26505 MORGANTOWN, WV 26505

(Observed)

(Revised 3-81)



Farm Robert Fluharty
API #47 - 061-0647-RED.
Date February 10, 1982

STATE OF WEST VIRGINIA
OFFICE OF OIL AND GAS - DEPARTMENT OF MINES

OIL AND GAS WELL PERMIT APPLICATION

WELL TYPE: Oil X / Gas ___ /

(If "Gas", Production ___ / Underground storage ___ / Deep ___ / Shallow ___)

LOCATION: Elevation: 1445.98 Watershed: Range Run
District: Battelle County: Monongalia Quadrangle: Wadestown 7 1/2'

WELL OPERATOR Consolidation Coal Company
Address P. O. Box 1314
Morgantown, WV 26507-1314

DESIGNATED AGENT Roger E. Duckworth
Address P. O. Box 1314
Morgantown, WV 26507-1314

OIL AND GAS ROYALTY OWNER Unknown
Address _____

COAL OPERATOR Consolidation Coal Co.
Address Same as above

Acreage _____

SURFACE OWNER Robert Fluharty
Address _____

COAL OWNER(S) WITH DECLARATION ON RECORD:
NAME Consolidation Coal Company
Address Same as above

Acreage _____

NAME _____
Address _____

FIELD SALE (IF MADE) TO:
NAME N/A
Address _____

COAL LESSEE WITH DECLARATION ON RECORD:
NAME Consolidation Coal Company
Address Same as above

OIL AND GAS INSPECTOR TO BE NOTIFIED:
NAME William Blosser
Address Colfax, WV
Telephone 363-9105

The undersigned well operator is entitled to operate for oil or gas purposes at the above location under a deed ___ / lease ___ / other contract X / dated _____, 19__ to the undersigned well operator from Robert Fluharty

(If said deed, lease, or other contract has been recorded:)

Recorded on _____, 19__, in the office of the Clerk of County Commission of _____ County, West Virginia, in _____ Book at page _____. A permit is requested as follows:

PROPOSED WORK: Drill ___ / Drill Deeper ___ / Redrill X / Fracture or stimulate ___
Plug off old formation ___ / Perforate new formation ___ /
Other physical change in well (specify) _____

Redrill to plug
--planned as shown on the work order on the reverse side hereof.

The above named coal operator, coal owner(s), and coal lessee are hereby notified that any objection they wish to make or are required to make by Code §22-4-3 must be filed with the Department of Mines within fifteen (15) days after receipt of this Application by the Dept. Copies of this Permit Application and the enclosed plat and reclamation plan have been mailed by registered mail or delivered by hand to the above named coal operator, coal owner(s), and coal lessees on or before the day of the mailing or delivery of this Application to the Department of Mines at Charleston, West Virginia.

PLEASE SUBMIT COPIES OF ALL
GEOPHYSICAL LOGS DIRECTLY TO:
WEST VIRGINIA OIL AND GAS
CONSERVATION COMMISSION
1613 WASHINGTON ST., E.
CHARLESTON, WV 25311
Telephone - 304/348-3092

CONSOLIDATION COAL COMPANY
Well Operator
By: Roger E. Duckworth
Its: Project Engineer

PROPOSED WORK ORDER

THIS IS AN ESTIMATE ONLY:
ACTUAL INFORMATION MUST BE SUBMITTED ON FORM IV-35 UPON COMPLETION

DRILLING CONTRACTOR (IF KNOWN) G & D Drilling Company
Address P. O. Box 110
Fairview, WV 26570

GEOLOGICAL TARGET FORMATION N/A
Estimated depth of completed well N/A feet. Rotary / Cable tools /
Approximate water strata depths: Fresh, N/A feet; salt, N/A feet.
Approximate coal seam depths: _____
Is coal being mined in this area: Yes / No /

CASING OR TUBING TYPE	SPECIFICATIONS				FOOTAGE INTERVALS		CEMENT FILL UP OR SACKS Cubic ft.	PACKERS
	Size	Grade	Weight per ft	New	Used	For Drilling		
Conductor								Kinds
Fresh water								
Coal								Sizes
Intermed.								
Production Tubing		SEE EXHIBIT #1						Depths set
Liners								Perforations: Top Bottom

NOTE: Regulation 7.02 of the Department of Mines provides that the original and four copies of Form IV-2 must be filed with the Department, accompanied by (i) a plat in the form prescribed by Regulation 11, (ii) a bond in one of the forms prescribed by Regulation 12, or in lieu thereof the other security allowed by Code §22-4-2, (iii) Form IV-9, "Reclamation Plan" applicable to the reclamation required by Code §22-4-12b and Regulation 23, (iv) unless previously paid on the same well, the fee required by Code §22-4-12a, and (v) if applicable, the consent required by Code §22-4-8a from the owner of any water well or dwelling within 200 feet of the proposed well.
A separate Form IV-2 shall not be required for fracturing or stimulating a well where fracturing or stimulating is to be part of the work for which a permit is sought and is noted as such on the Form IV-2 filed in connection therewith.

THIS PERMIT MUST BE POSTED AT THE WELL SITE.
ALL PROVISIONS BEING IN ACCORDANCE WITH CHAPTER 22,
ARTICLE 4 OF THE W. VA. CODE, THE LOCATION IS HEREBY
APPROVED FOR redrilling. THIS PERMIT SHALL EXPIRE
IF OPERATIONS HAVE NOT COMMENCED BY 11-1-82.
BY [Signature]

The following waiver must be completed by the coal operator and by any coal owner or coal lessee who has recorded a declaration under Code §22-4-20, if the permit is to be issued within fifteen (15) days of receipt thereof:

W A I V E R

I, the undersigned coal operator _____ / owner _____ / lessee _____ / of the coal under this well location has examined this proposed well location. If a mine map exists which covers the area of the well location, the well location has been added to the mine map. The undersigned has no objection to the work proposed to be done at this location, provided the coal operator has complied with all applicable requirements of the West Virginia Code and all governing regularions.

Date: _____, 19____.

CONSOLIDATION COAL COMPANY
By: [Signature]
Its: Senior Vice President

STATE OF WEST VIRGINIA
DEPARTMENT OF MINES
OIL AND GAS WELLS DIVISION

RECEIVED

SEP - 8 1982

OIL AND GAS DIVISION
WV DEPARTMENT OF MINES

AFFIDAVIT OF PLUGGING AND FILLING WELL

AFFIDAVIT SHOULD BE MADE IN TRIPLICATE, ONE COPY MAILED TO THE DEPARTMENT, ONE COPY TO BE RETAINED BY THE WELL OPERATOR AND THE THIRD COPY (AND EXTRA COPIES IF REQUIRED) SHOULD BE MAILED TO EACH COAL OPERATOR AT THEIR RESPECTIVE ADDRESSES.

<u>Consolidation Coal Company</u> <small>COAL OPERATOR OR OWNER</small> <u>P. O. Box 1314, Morgantown, WV 26507-1314</u> <small>ADDRESS</small> <u>Same</u> <small>COAL OPERATOR OR OWNER</small> <u>Robert Fluharty</u> <small>ADDRESS</small> <u>Wadestown, WV</u> <small>LEASE OR PROPERTY OWNER</small> <small>ADDRESS</small>	<u>Consolidation Coal Company</u> <small>NAME OF WELL OPERATOR</small> <u>P. O. Box 1314, Morgantown, WV 26507-1314</u> <small>COMPLETE ADDRESS</small> <u>August 30, 19 82</u> <small>WELL AND LOCATION</small> <u>Battelle</u> <u>District</u> <u>Monongalia</u> <u>County</u> <u>Well No.</u> <u>Consol No. 4258</u> <u>Robert Fluharty</u> <u>Farm</u>
--	---

STATE INSPECTOR SUPERVISING PLUGGING William Blosser, Colfax, WV

AFFIDAVIT

STATE OF WEST VIRGINIA,
County of Monongalia } ss:

Jim Lang and Calvin Lofton
being first duly sworn according to law depose and say that they are experienced in the work of plugging and filling oil and gas wells and were employed by Consolidation Coal Company, well operator, and participated in the work of plugging and filling the above well, that said work was commenced on the 29th day of April, 19 82, and that the well was plugged and filled in the following manner:

SAND OR ZONE RECORD	FILLING MATERIAL	PLUGS USED	CASING	
			CSG PULLED	CSG LEFT IN
FORMATION		SIZE & KIND		
Cut and pulled 2339' 5 1/2" O.D. casing. Cut and pulled 1730' 7" O.D. casing. Cut and pulled 1400' 8 5/8" O.D. casing. Ran coal protection string as follows: 2 3/8" tubing from 2286' to 1416' and 4 1/2" O.D. casing from 1416' to surface. Latch down plug at 1353', flapper valve at 1397' and swedge at 1416'. Ran cement as follows: 850 sacks of Pozmix followed by 375 sacks of expanding cement.		2 3/8 tubing 4 1/2" casing	2286' to 1416'	1416' to surface.
Displaced 4 1/2" casing to 1353' with water and swabbed dry. NOTE: Cement was circulated to surface.				
COAL BEAMS		DESCRIPTION OF MONUMENT		
(NAME) Pittsburgh	1264' to 1272'	5' of 4 1/2" casing above surface with plaque stating: Consol 4258', 47-061-0647-RED-P		
(NAME)				
(NAME)				
(NAME)				

and that the work of plugging and filling said well was completed on the 9th day of June, 19 82.

And further deponents saith not.

Sworn to and subscribed before me this 3rd day of Sept, 19 82.

My commission expires:

Sept. 8, 1988

James R. Long
Calvin Lofton
J. R. Emmit

Notary Public.

Permit No. 47-061-0647-RED-P

Mon. - 0647-RED-P