

WW-7
8-30-06



West Virginia Department of Environmental Protection
Office of Oil and Gas
WELL LOCATION FORM: GPS

API: 4704901448 WELL NO.: L53

FARM NAME: Bowsher

RESPONSIBLE PARTY NAME: CNX Gas Company

COUNTY: Monongalia DISTRICT: Battelle

QUADRANGLE: Mannington

SURFACE OWNER: Range Run Retreat LLC

ROYALTY OWNER: _____

UTM GPS NORTHING: 4386253.43

UTM GPS EASTING: 556469.45 GPS ELEVATION: 383.97m / 1259.76 ft

The Responsible Party named above has chosen to submit GPS coordinates in lieu of preparing a new well location plat for a plugging permit or assigned API number on the above well. The Office of Oil and Gas will not accept GPS coordinates that do not meet the following requirements:

1. Datum: NAD 1983, Zone: 17 North, Coordinate Units: meters, Altitude: height above mean sea level (MSL) – meters.
2. Accuracy to Datum – 3.05 meters
3. Data Collection Method:

Survey grade GPS _____: Post Processed Differential _____

Real-Time Differential _____

Mapping Grade GPS X: Post Processed Differential X

Real-Time Differential _____


4. **Letter size copy of the topography map showing the well location.**

I the undersigned, hereby certify this data is correct to the best of my knowledge and belief and shows all the information required by law and the regulations issued and prescribed by the Office of Oil and Gas.

Raymond Allen
Signature

Project MANAGER
Title

12-4-19
Date

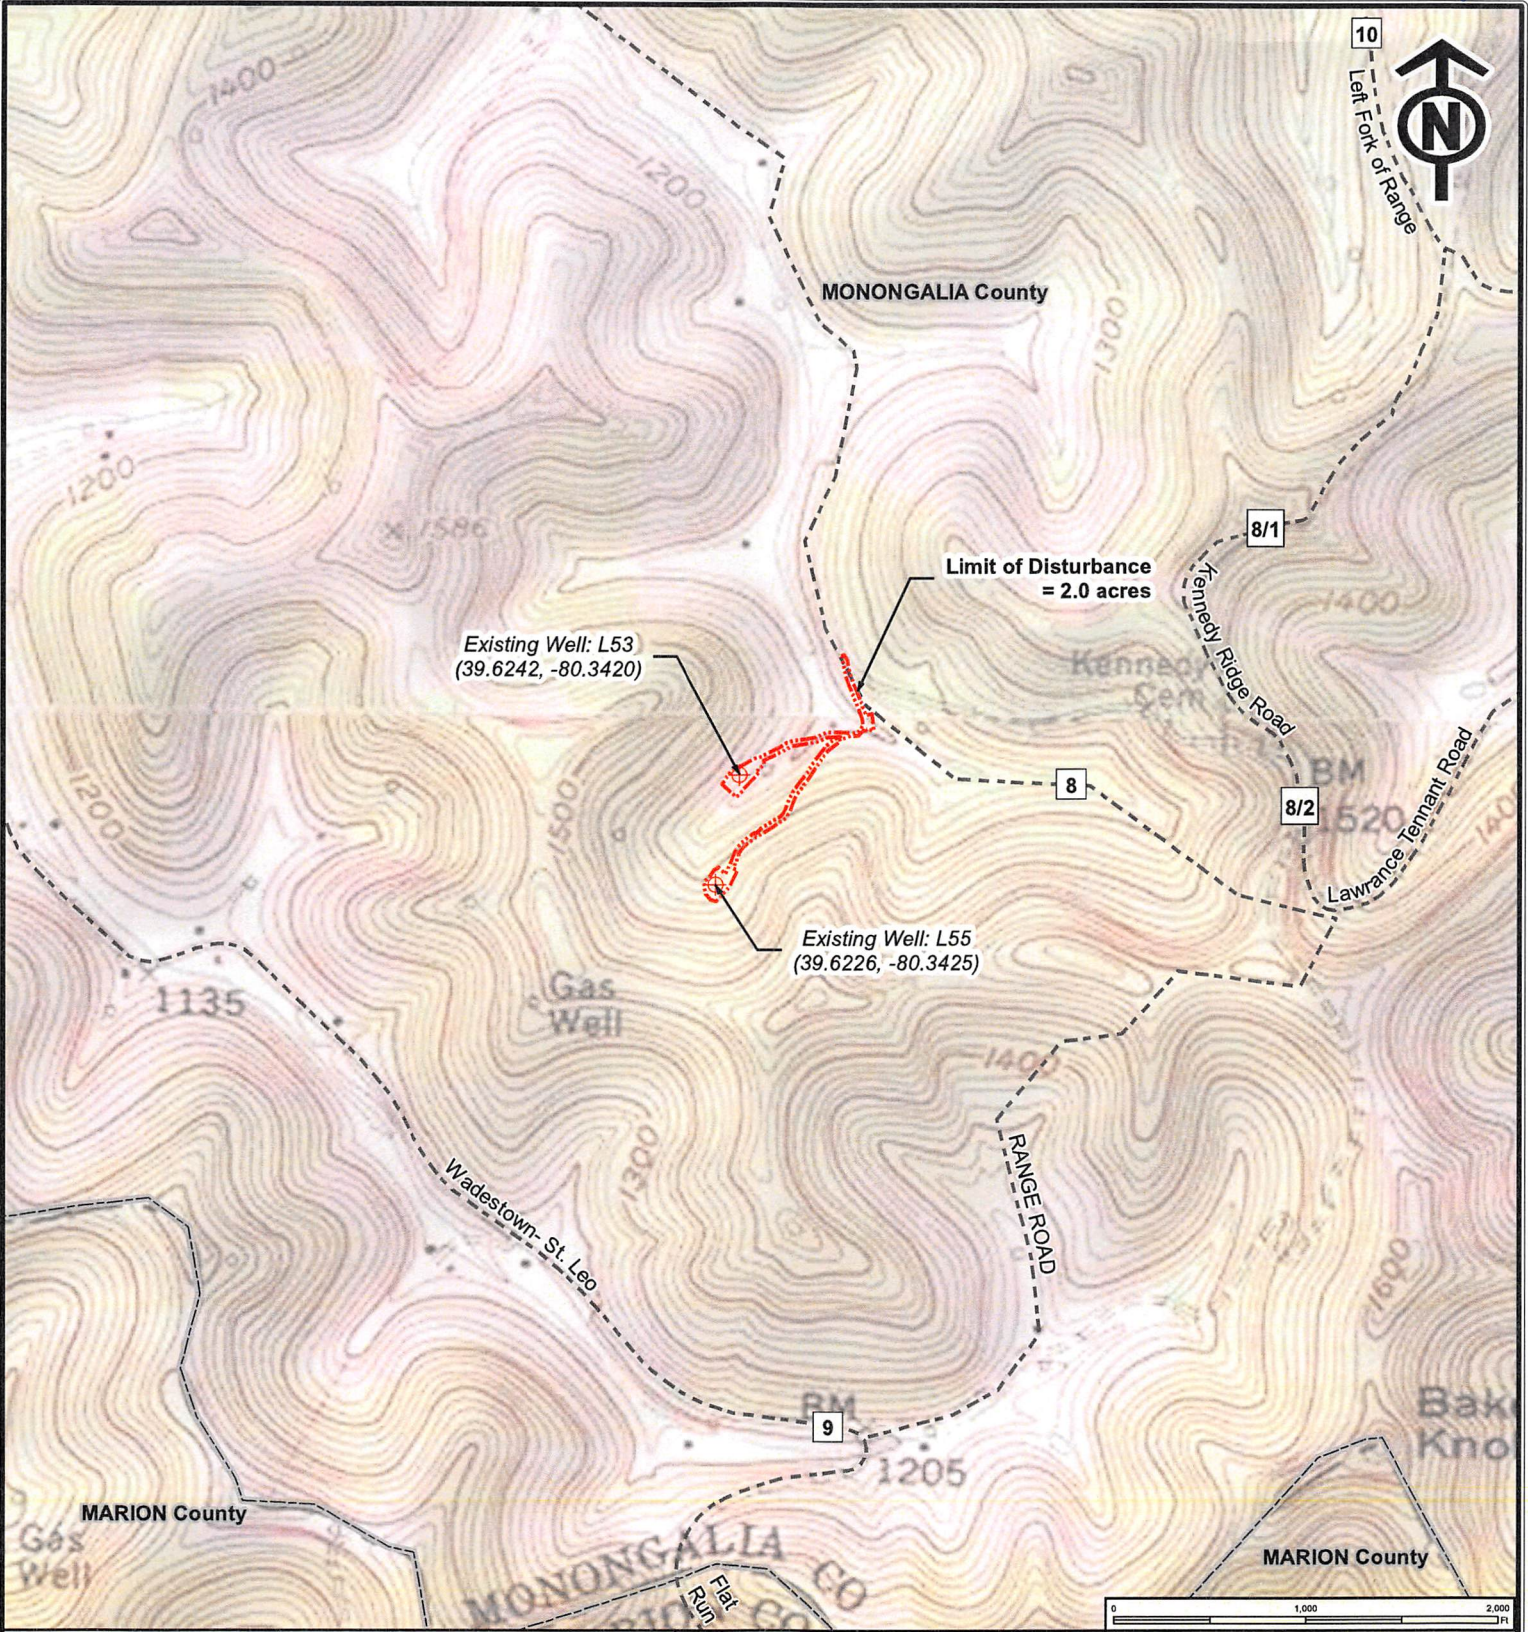

LEGEND

- Existing Well
- Limit of Disturbance
- Road
- County Boundary

Prepared By: **KEYSTONE CONSULTANTS INC.**
www.keystoneconsultants.net 412-278-2100

REV	DESCRIPTION	DATE

DWN BY: AMW APR BY: STK DATE: 11/13/2019

**L53/L55 Well Plugging
Site Location Topographic Map**

Marion County, WV

DRAWING NUMBER: 001

SCALE: 1" = 1,000 feet SHEET: 1 OF 2

BASEMAP: USGS TOPOGRAPHIC QUADRANGLE WADESTOWN, MANNINGTON, WV
Roads: West Virginia Department of Transportation(WVDOT) https://transportation.wv.gov