

WW-7
8-30-06



West Virginia Department of Environmental Protection
Office of Oil and Gas
WELL LOCATION FORM: GPS

API: 47-061-01644 WELL NO.: 4379
 FARM NAME: E. B. HALL
 RESPONSIBLE PARTY NAME: WEST VIRGINIA LAND RESOURCES INC.
 COUNTY: MONONGALIA DISTRICT: BATTELLE
 QUADRANGLE: WADESTOWN W.VA,PA
 SURFACE OWNER: CONSOL MINING COMPANY LLC.(C/O ACNR INC.)
 ROYALTY OWNER: _____
 UTM GPS NORTHING: 4,388,109 m (1079')
 UTM GPS EASTING: 554,162 m GPS ELEVATION: 329 m

The Responsible Party named above has chosen to submit GPS coordinates in lieu of preparing a new well location plat for a plugging permit or assigned API number on the above well. The Office of Oil and Gas will not accept GPS coordinates that do not meet the following requirements:

1. Datum: NAD 1983, Zone: 17 North, Coordinate Units: meters, Altitude: height above mean sea level (MSL) – meters.
2. Accuracy to Datum – 3.05 meters
3. Data Collection Method:

Survey grade GPS _____ : Post Processed Differential _____


Real-Time Differential _____

Mapping Grade GPS : Post Processed Differential

Real-Time Differential _____

4. **Letter size copy of the topography map showing the well location.**

I the undersigned, hereby certify this data is correct to the best of my knowledge and belief and shows all the information required by law and the regulations issued and prescribed by the Office of Oil and Gas.

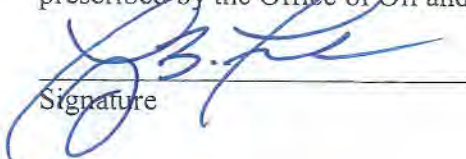
Signature

Professional Surveyor
Title

MAY 27, 2021
Date

RECEIVED
Office of Oil and Gas

JUN 14 2021

WV Department of
Environmental Protection

47061016448



191
40'
199
40,000 FEET
(W. VA.)
198
197


39°37'30" 80°22'30" 54 55 1:260,000 FEET (W. VA.)

Office of Oil and Gas

(G-OVERGAP)
2002 II. STY

Mapped, edited, and published by the Geological Survey
Control by USGS and USC&GS
Topography from aerial photographs by photogrammetric methods
Aerial photographs taken 1956. Field check 1958

Polycyclic protection. 1927 North American datum
10,000-foot grids based on West Virginia coordinate system,
north zone, and Pennsylvania coordinate system, south zone

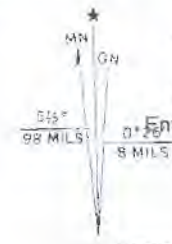

JUN 14 2021

WV Department of Environmental Protection

07/02/2021

