

LATITUDE 39° 42' 30"

2,601'

3,477'

LONGITUDE 80° 12' 30"

TOPO. LOC.  
BLACKSVILLE QUAD.  
7 1/2' SERIES

RALPH HUSK  
08-08-17  
58.96 ACRES

CALVIN BRAY  
08-08-18  
25.9 ACRES

GARY SIMPSON  
08-07-05  
59.75 ACRES

AARON FISHER  
08-08-21  
10.49 ACRES

AARON FISHER  
08-07-06  
40.6 ACRES

AARON FISHER  
08-08-23  
35.653 ACRES

WELL LOCATION  
UTM, NAD 83  
17-84W to 78W, Meters  
N: 4,394,630.1  
E: 567,100.0  
Elevation: 375.7

FILE NO. WELL F2-565  
DRAWING NO. F2-565 PLAT  
SCALE 1"=400'  
MINIMUM DEGREE OF  
ACCURACY 1/2500'  
PROVEN SOURCE OF  
ELEVATION USGS B.M.

I THE UNDERSIGNED, HEREBY CERTIFY  
THAT THIS PLAT IS CORRECT TO THE  
BEST OF MY KNOWLEDGE AND BELIEF AND  
SHOWS ALL THE INFORMATION REQUIRED  
BY LAW AND THE REGULATIONS ISSUED  
AND PRESCRIBED BY THE DEPARTMENT OF  
MINES.  
(SIGNED) John F. Ewell Jr.  
R.P.E. 11133 L.L.S.



(+) DENOTES LOCATION OF  
WELL ON UNITED STATES  
TOPOGRAPHIC MAPS

DATE DEC 19, 20 14  
OPERATOR'S WELL NO. F2-565  
API WELL NO.

FORM IV-6

47-061-01702P  
STATE COUNTY PERMIT

(8-78)

STATE OF WEST VIRGINIA  
DEPARTMENT OF ENVIRONMENTAL PROTECTION  
OIL AND GAS DIVISION

WELL TYPE: OIL  GAS  LIQUID INJECTION  WASTE DISPOSAL   
(IF "GAS", PRODUCTION  STORAGE  DEEP  SHALLOW

LOCATION: ELEVATION 1,233' WATERSHED KINGS RUN  
DISTRICT CLAY COUNTY MONONGALIA  
QUADRANGLE BLACKSVILLE


SURFACE OWNER AARON FISHER ACREAGE 40.6  
OIL & GAS ROYALTY OWNER UNKNOWN LEASE ACREAGE                     

LEASE NO.                       
PROPOSED WORK: DRILL  CONVERT  DRILL DEEPER  REDRILL  FRACTURE OR  
STIMULATE  PLUG OFF OLD FORMATION  PERFORATE NEW  
FORMATION  OTHER PHYSICAL CHANGE IN WELL (SPECIFY)                     

PLUG AND ABANDON  CLEAN OUT AND REPLUG   
TARGET FORMATION BAYARD SAND ESTIMATED DEPTH 3,250'  
WELL OPERATOR EASTERN ASSOC. COAL LLC DESIGNATED AGENT                       
ADDRESS 1044 MIRACLE RUN ROAD ADDRESS                       
FAIRVIEW WV. 26570

MATTHEW L. BONNELL  
1044 MIRACLE RUN ROAD  
FAIRVIEW WV. 26570

01/30/2015

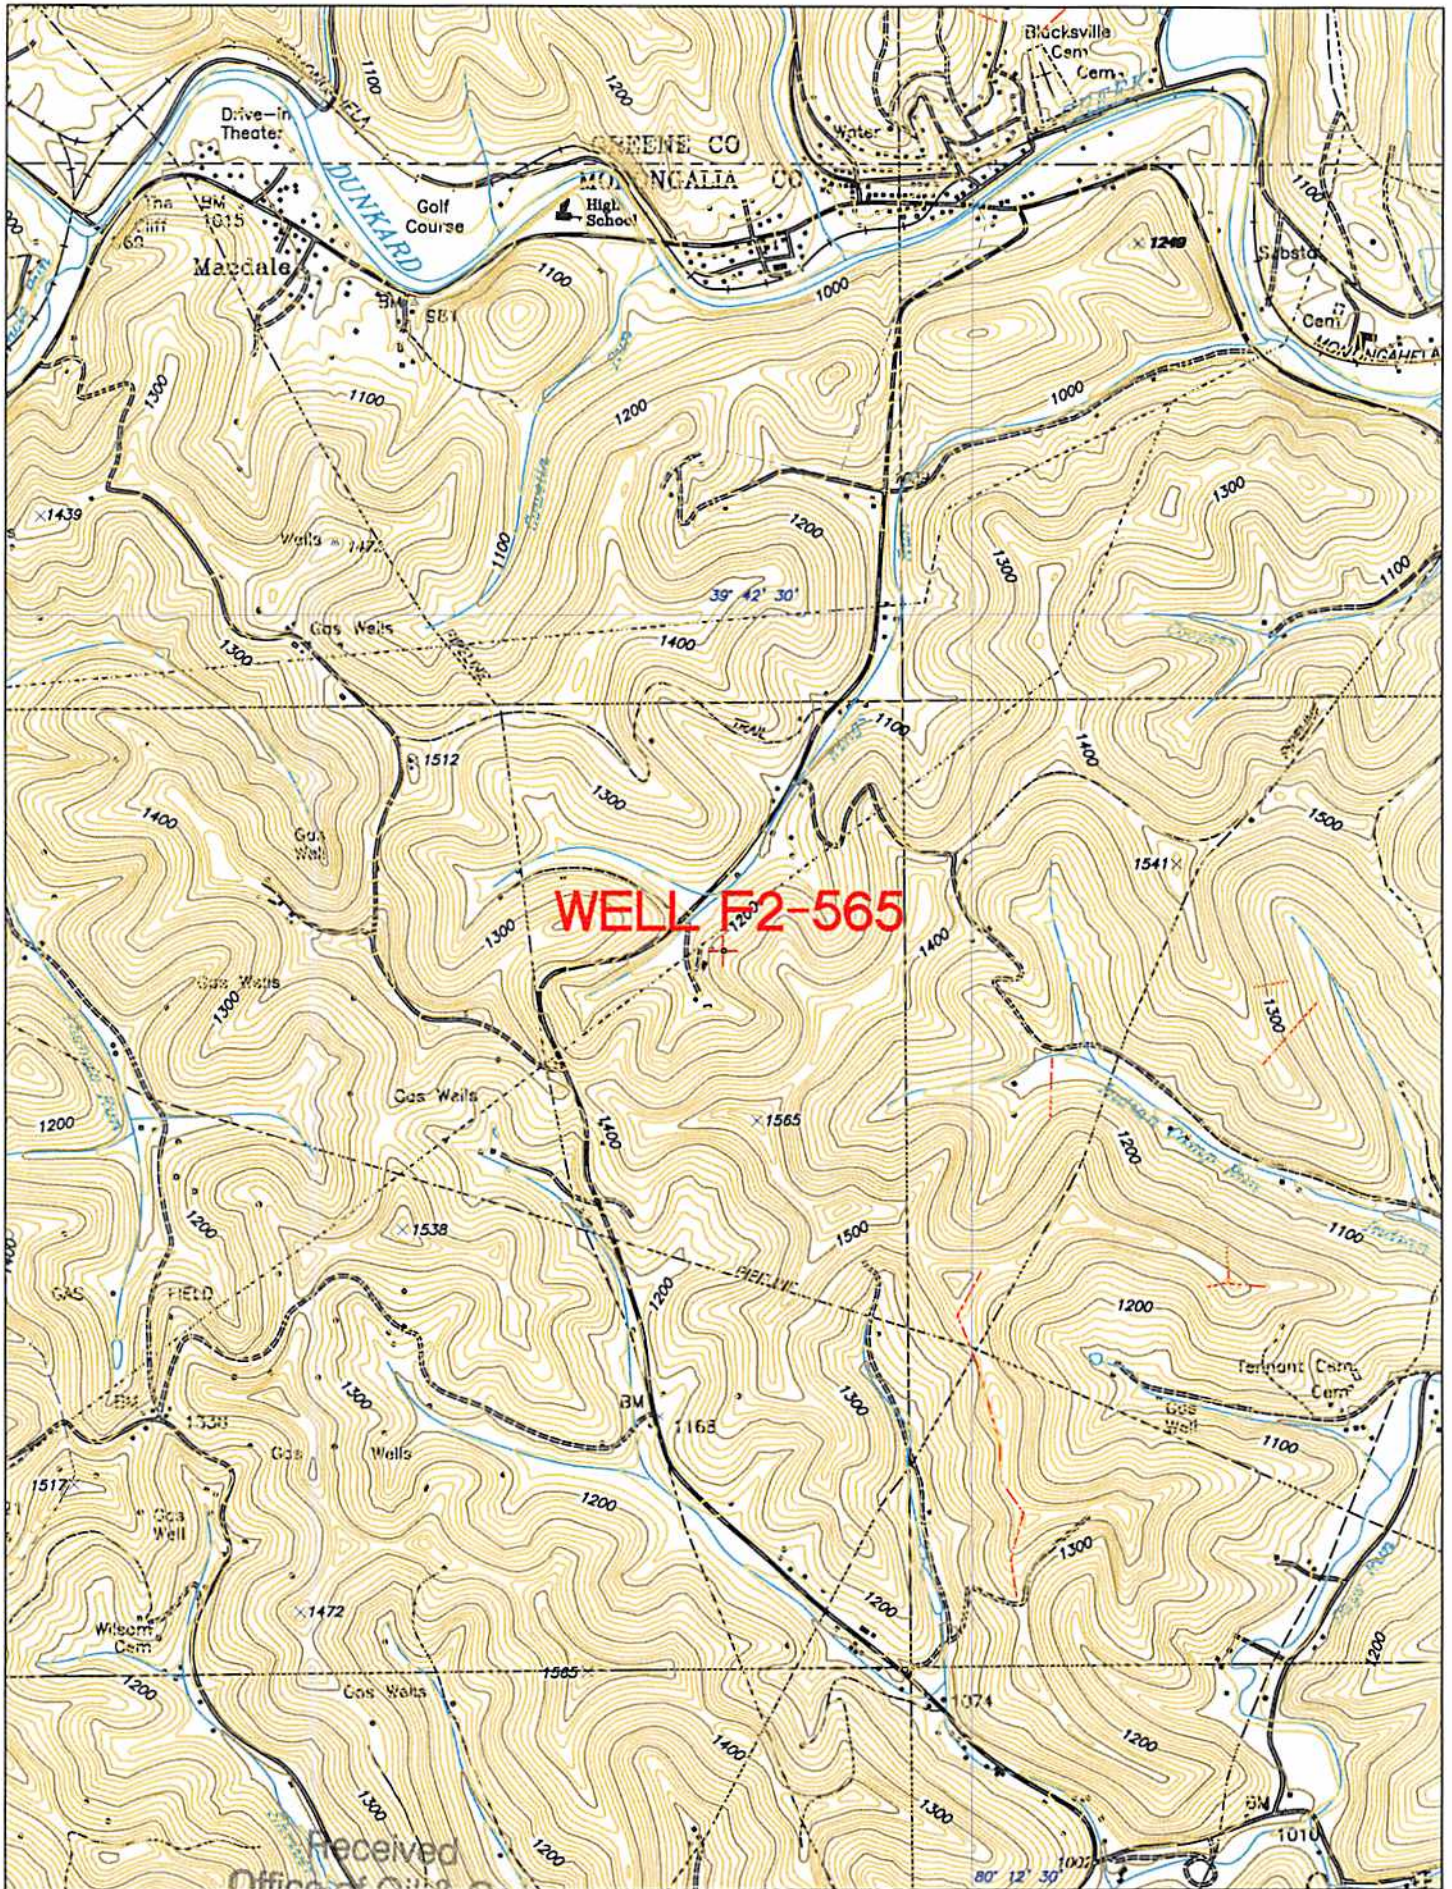

Received  
Office of Oil & Gas

DEC 23 2014