

REFERENCE NOTES
 Boundaries as shown taken from deeds, tax maps and field locations. A full boundary survey is not expressed nor implied. All bearings are based on true north. Ownership taken from public records Monongalia County, West Virginia JANUARY 2011
 State Plane Coordinates & NAD 83 Lat/Long by differential submeter mapping grade GPS
 Drafted by: E.A.M.


WELL (SURFACE HOLE) MIP 1S (DRILLED) WV-N (NAD 83)
 N: 401707.2
 E: 1834312.1
 UTM (NAD 83)
 N: 4384076.5
 E: 587894.0

WELL (SURFACE HOLE) MIP 1S (PROPOSED) WV-N (NAD 83)
 N: 401711.5
 E: 1834320.8
 UTM (NAD 83)
 N: 4384077.9
 E: 587896.7

TOP HOLE (UTM NAD 83)
 N: 4384077.9
 E: 587896.7

FILE #: NNE004
 DRAWING #: 1419
 SCALE: PLAT: 1"=400' TICK: 1"=2000'
 MINIMUM DEGREE OF ACCURACY: 1/200
 PROVEN SOURCE SUBMETER MAPPING OF ELEVATION: GRADE GPS

I, THE UNDERSIGNED, HEREBY CERTIFY THAT THIS PLAT IS CORRECT TO THE BEST OF MY KNOWLEDGE AND BELIEF AND SHOWS ALL THE INFORMATION REQUIRED BY LAW AND THE REGULATIONS ISSUED AND PRESCRIBED BY THE DEPARTMENT OF ENVIRONMENTAL PROTECTION.
 Signed: *[Signature]*
 L.L.S. #2124 : Ernest J. Benchek III

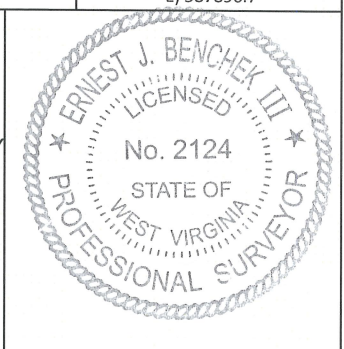

(+) DENOTES LOCATION OF WELL ON UNITED STATES TOPOGRAPHIC MAPS
WVDEP OFFICE OF OIL & GAS
 601 57TH STREET
 CHARLESTON, WV 25304

DATE: MARCH 1, 2024
 OPERATOR'S WELL #: MIP 1S
 API WELL #: 47 61
 STATE COUNTY PERMIT

Well Type: Oil Waste Diposal Production Deep Geothermal
 Gas Liquid Injection Storage Shallow Test

WATERSHED: DUNKARD AS-BUILT ELEVATION : 1,057.55'

COUNTY/DISTRICT: MONONGALIA/GRANT QUADRANGLE: MORGANTOWN SOUTH
 SURFACE OWNER: ENROUTE PROPERTIES LLC. ACREAGE: 25.998 +/-
 OIL & GAS ROYALTY OWNER: ENROUTE PROPERTIES LLC. ACREAGE: 65.796 +/- **02/23/2024**
 LEASE NUMBERS: _____

DRILL CONVERT DRILL DEEPER REDRILL FRACTURE OR STIMULATE
 PLUG OFF FORMATION PERFORATE NEW FORMATION PLUG & ABANDON
 CLEAN OUT & REPLUG OTHER CHANGE (SPECIFY): CORING FOR SCIENCE

TARGET FORMATION: POINT PLEASANT
 WELL OPERATOR : NORTHEAST NATURAL ENERGY DRILLED DEPTH: TVD: 10,535'
 ADDRESS: 707 VIRGINIA STREET - SUITE 1200 DESIGNATED AGENT : JOHN ADAMS
 CITY: CHARLESTON STATE: WV ZIP CODE: 25301 CITY: CHARLESTON STATE: WV ZIP CODE: 25301