


4706101937P

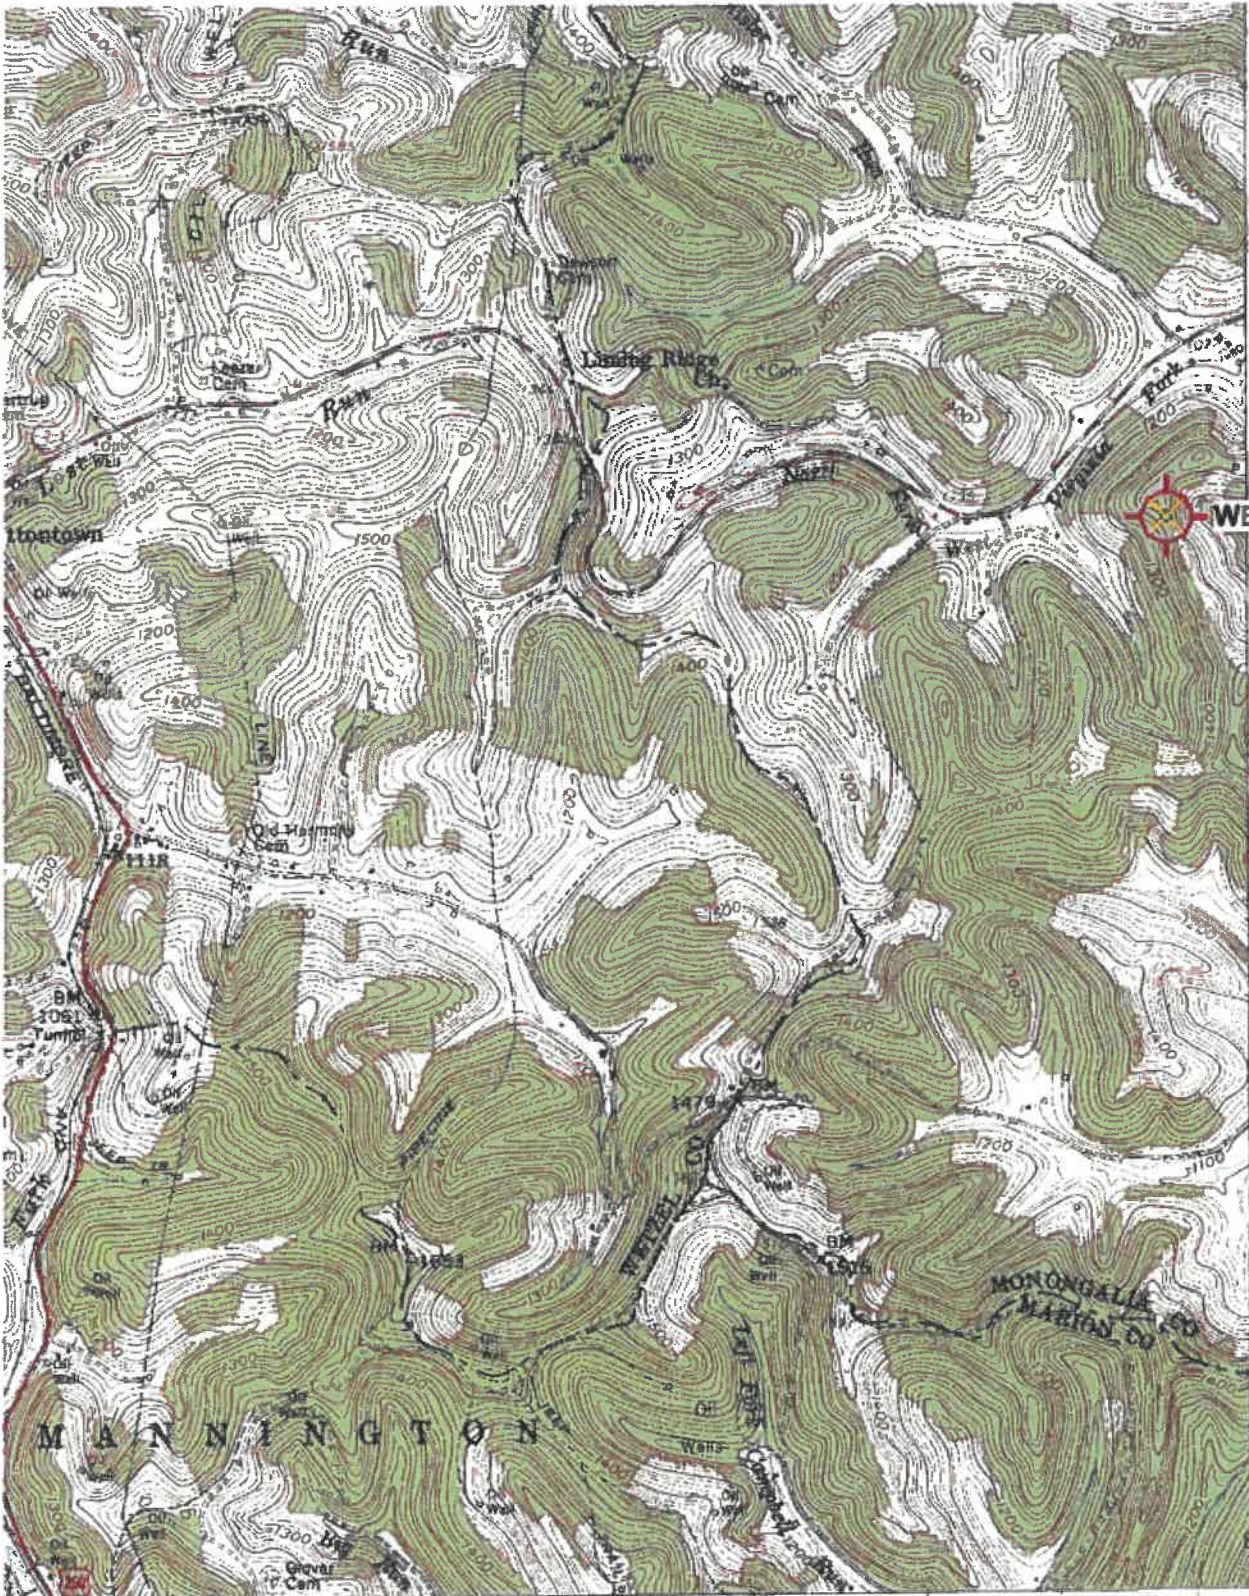












WELL #4388

120 000 FEET (PA.)

RECEIVED Office of Oil and Gas

MAY 15 2023

WV Department of Environmental Protection

39° 37' 30"

80° 22' 30"

(MANNINGTON) 15' QUADRANGLE

ROAD CLASSIFICATION

- Heavy-duty Light-duty
- Medium-duty Unimproved dirt
- U. S. Route State Route




QUADRANGLE LOCATION

HUNDRED, W. VA.—PA. NW/4 MANNINGTON 15' QUADRANGLE N 3937.5—W 8022.5/7.5

06/16/2023

'Hundred' WV, PA' Scale: 1" = 0.379Mi 610M 2 000Ft 1 Mi = 2 640' 1 cm = 240M

Well# 4388  
HUNDRED WV / PA 7.5' Quad  

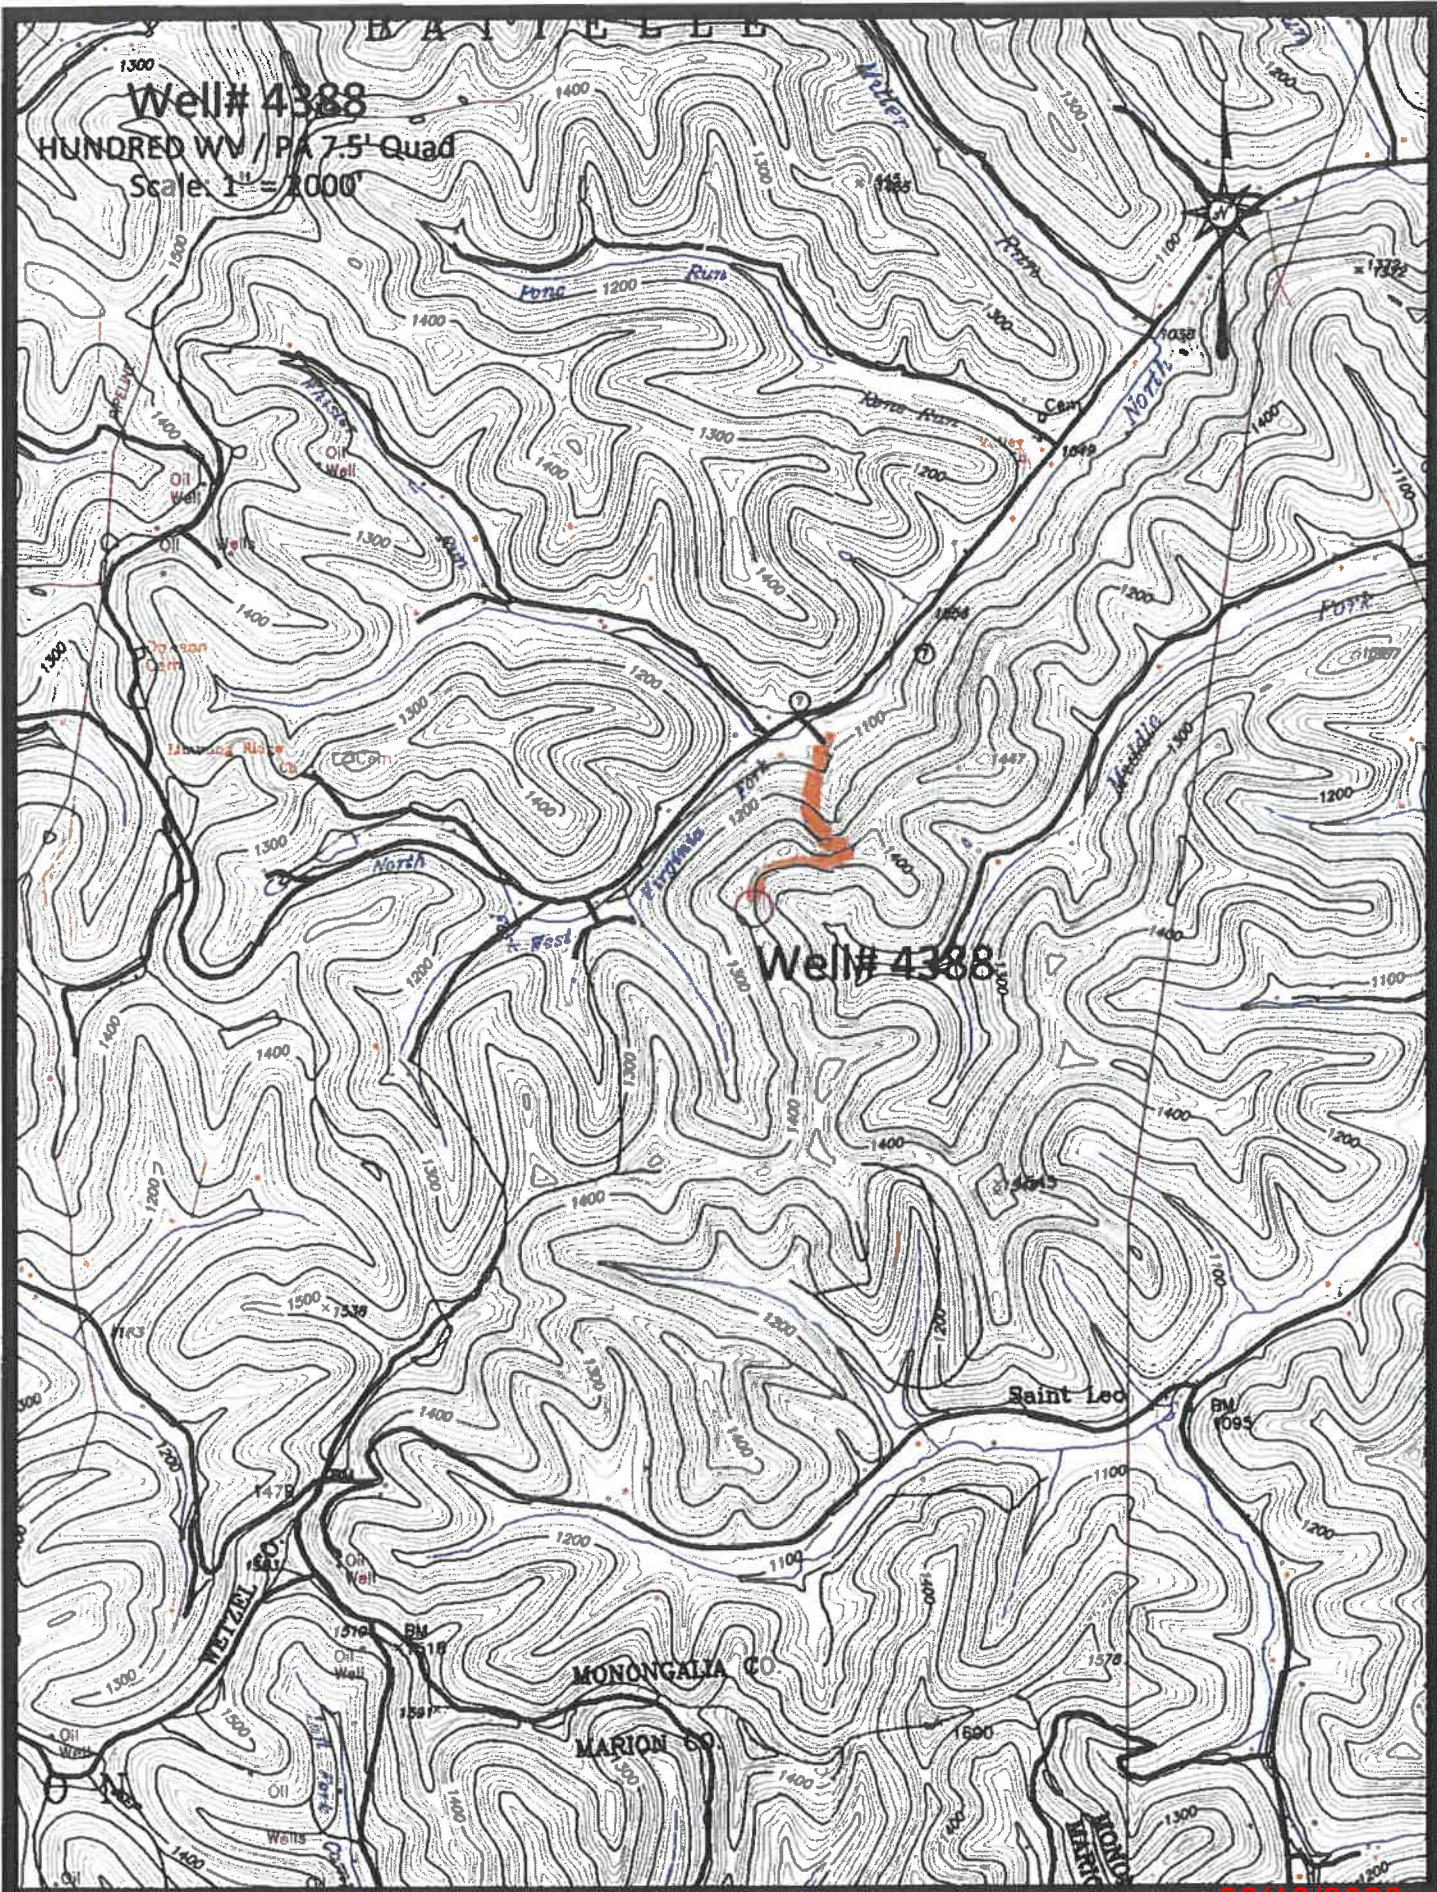

Well# 4388

MONONGALIA CO

MARION CO

Saint Leo

WETZEL CO

Area 1

06/16/2023

WW-7  
8-30-06



West Virginia Department of Environmental Protection  
Office of Oil and Gas

WELL LOCATION FORM: GPS

API: 47-061-71882 WELL NO.: 4388

FARM NAME: J.H. LIMING HRS.

RESPONSIBLE PARTY NAME: WEST VIRGINIA LAND RESOURCES INC.

COUNTY: MONONGALIA DISTRICT: BATTELLE

QUADRANGLE: HUNDRED W.VA, PA

SURFACE OWNER: FREDERICK A. SIX

ROYALTY OWNER: \_\_\_\_\_

UTM GPS NORTHING: 4,389,879 m

UTM GPS EASTING: 553,371 m GPS ELEVATION: 429 m (1407')

The Responsible Party named above has chosen to submit GPS coordinates in lieu of preparing a new well location plat for a plugging permit or assigned API number on the above well. The Office of Oil and Gas will not accept GPS coordinates that do not meet the following requirements:

1. Datum: NAD 1983, Zone: 17 North, Coordinate Units: meters, Altitude: height above mean sea level (MSL) – meters.
2. Accuracy to Datum – 3.05 meters
3. Data Collection Method:

Survey grade GPS \_\_\_\_\_: Post Processed Differential \_\_\_\_\_

Real-Time Differential \_\_\_\_\_

Mapping Grade GPS X: Post Processed Differential X

Real-Time Differential \_\_\_\_\_

4. Letter size copy of the topography map showing the well location.

I the undersigned, hereby certify this data is correct to the best of my knowledge and belief and shows all the information required by law and the regulations issued and prescribed by the Office of Oil and Gas.

[Signature]  
Signature

Professional Surveyor  
Title

MARCH 28, 2023  
Date

RECEIVED  
Office of Oil and Gas  
MAY 15 2023  
WV Department of  
Environmental Protection