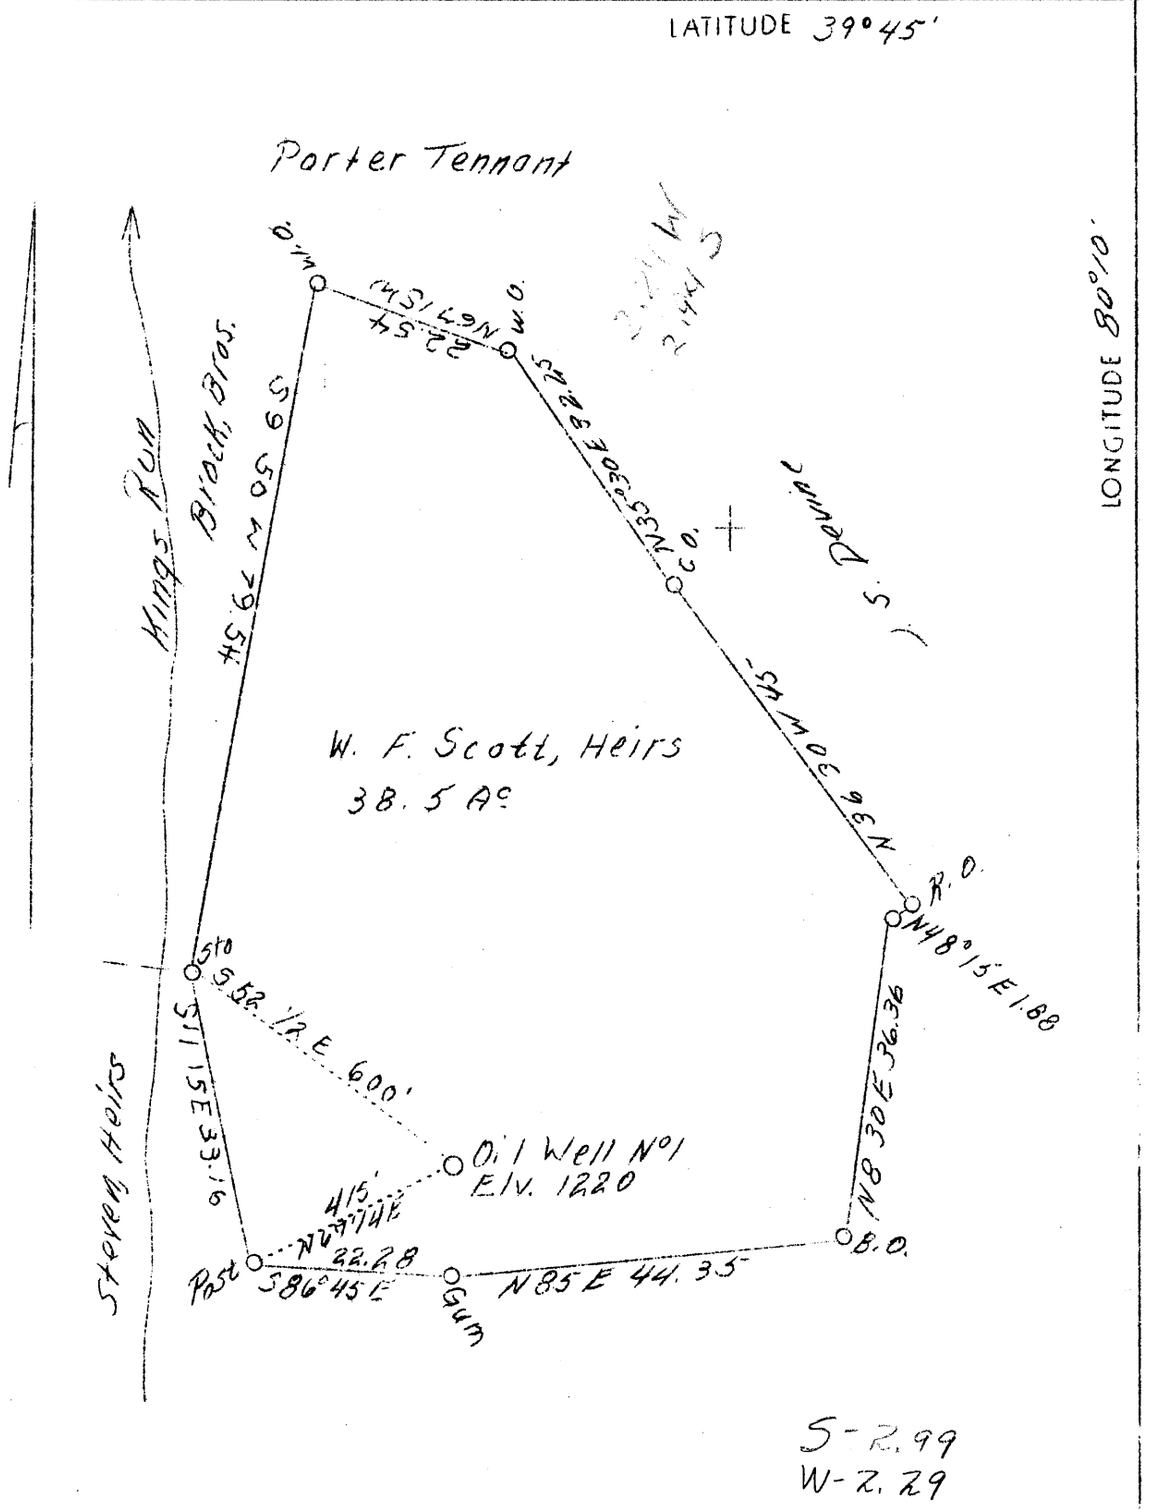

ABD.

Company	J.M.Raad
Address	Salem, W.Va.
Farm	W.F.Scott, Heirs
Acres	38.5
Well(Farm)No.	1
El.(S.L.)	1220
Quadrangle NW	Blackville
County	Monongalia
District	Clay
Eng.	C.C.Fittro,C.E.
Eng. Reg. No.	818
File No.	XYZ
Drawing No.	125
Date	8/29/39
Scale	1" - 200'

STATE OF WEST VIRGINIA
Department of Mines
OIL AND GAS DIVISION
Charleston

WELL LOCATION MAP

File No. MON-208-A

x Denotes location of well on U.S. Topographic Maps, scale 1 to 62,500, latitude and longitude lines being represented by border lines as shown.

- Denotes one inch spaces on border line of original tracing.