39° 42' 30"

Latitude

.47s
1.32w

Longitude

Topo Location

7.5' Loc. _____ 15' Loc. _____
(calc.)

Company Carnegie Nat Gas Co

Farm Lee R Shriver #1

15' Quad _____
(sec.)

7.5' Quad Blacksville

District Clay

WELL LOCATION PLAT

County 061 Permit 30287

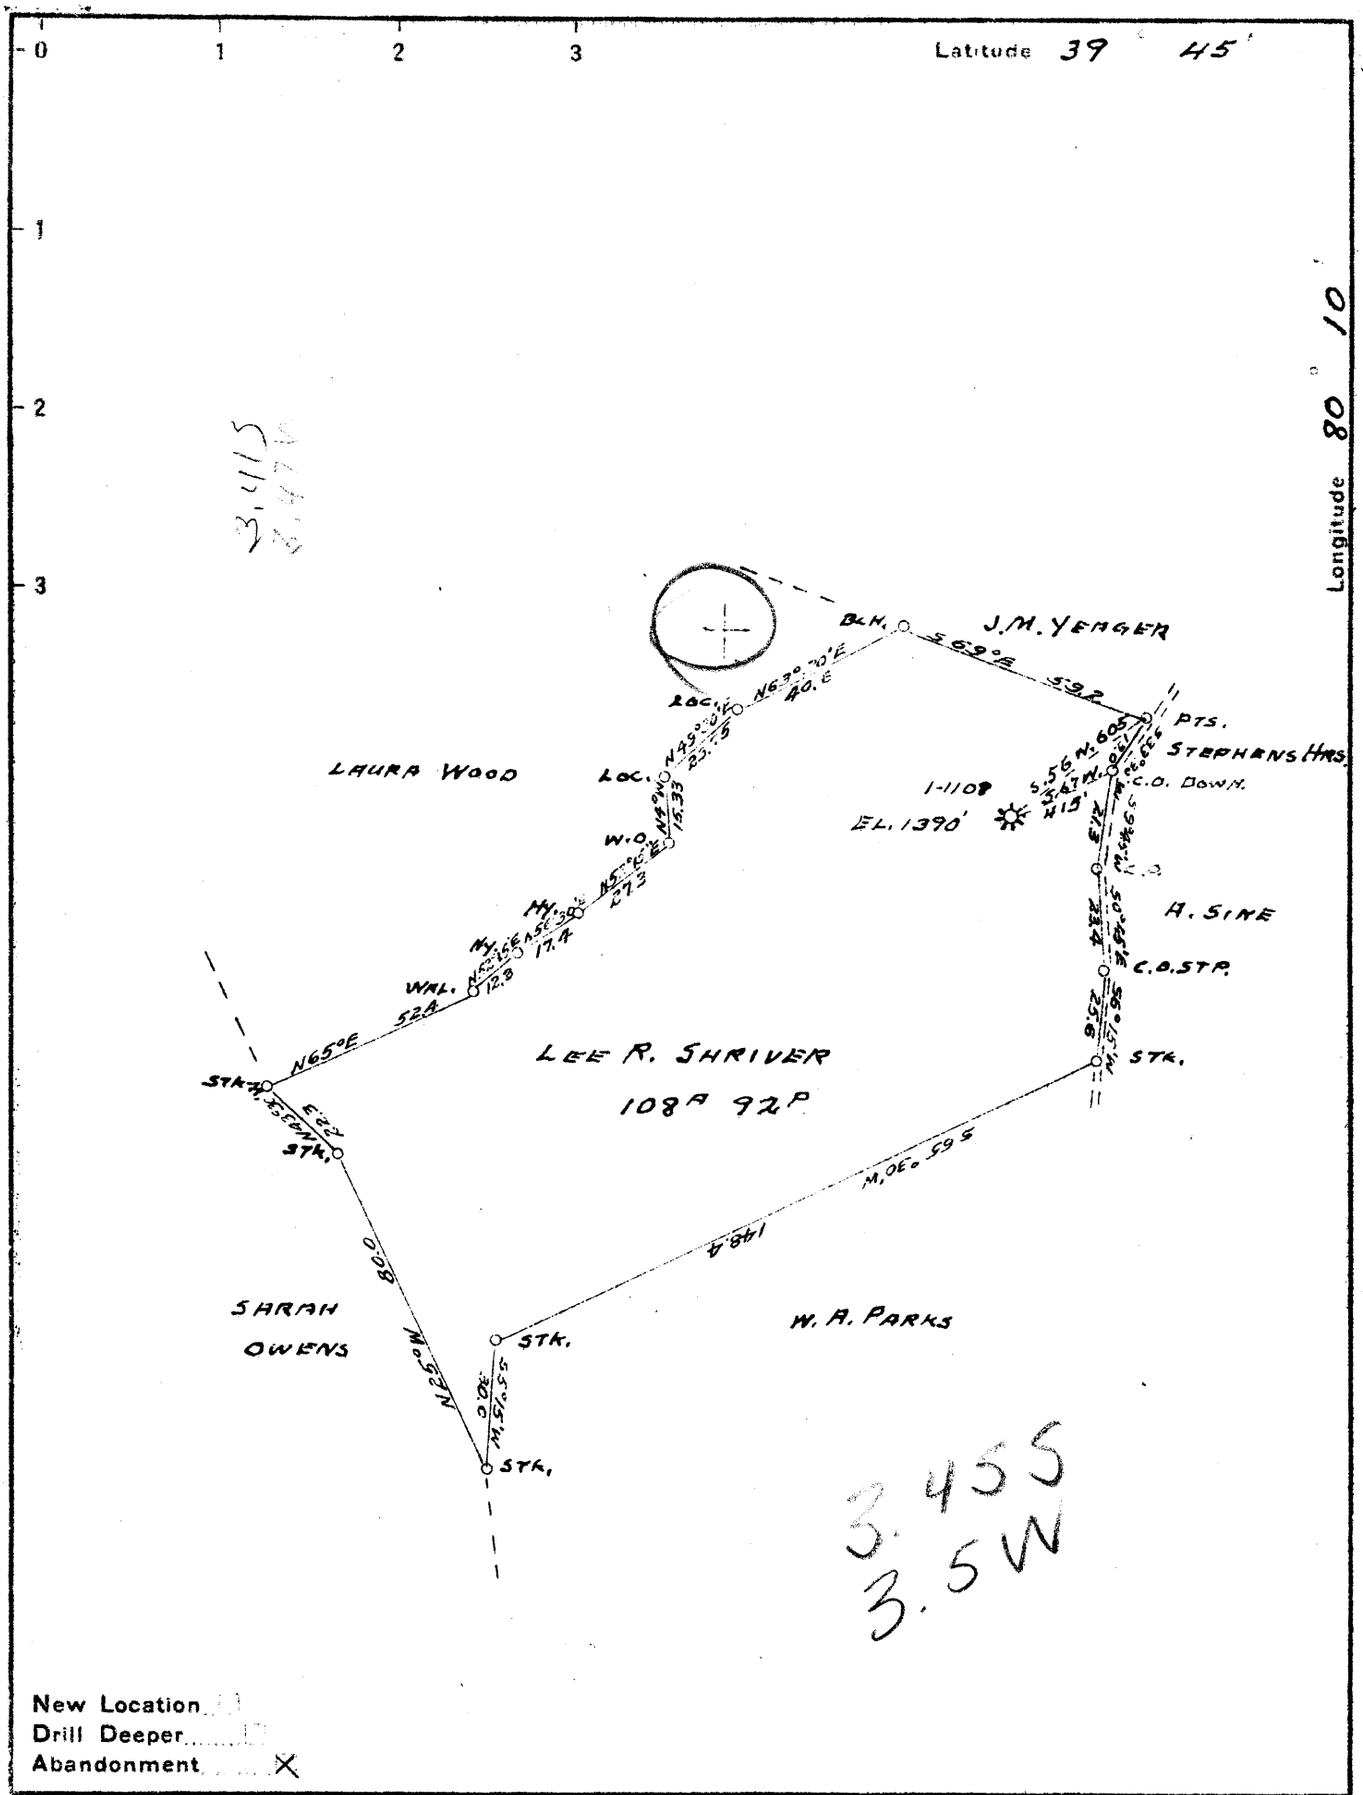

New Location
Drill Deeper
Abandonment X

Company CARNEGIE NATURAL GAS CO.,
Address PITTSBURGH, PENNA.
Farm LEE R. SHRIVER
Tract ONE Acres 125 Lease No. E-1086856
Well (Farm) No. 1 Serial No. 1108
Elevation (Spirit Level) 1390'
Quadrangle BLACKSVILLE N.W. 1/4
County MONONGALIA District CLAY
Engineer D.T. BRITTON
Engineer's Registration No.
File No. Drawing No.
Date 2-17-1943 Scale 1" = 40 P.

STATE OF WEST VIRGINIA
DEPARTMENT OF MINES
OIL AND GAS DIVISION
CHARLESTON

WELL LOCATION MAP

FILE NO. MON-287A

+ Denotes location of well on United States Topographic Maps, scale 1 to 62,500, latitude and longitude lines being represented by border lines as shown.

— Denotes one inch spaces on border line of original tracing.