


Latitude

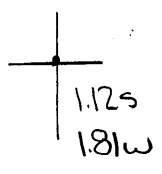

Longitude

Topo Location

7.5' Loc. _____ 15' Loc. _____
 _____ (scale) _____

Company Steve DeClworth

Farm Raymond J+JM Kozlowski

15' Quad _____
(sec.)

7.5' Quad Wheeling

District Richmond

WELL LOCATION PLAT


County 069 Permit 27

Ch 8/7

9600'

LATITUDE 40°07'30"
40° 10'

LONGITUDE 80°40'00"
5950'

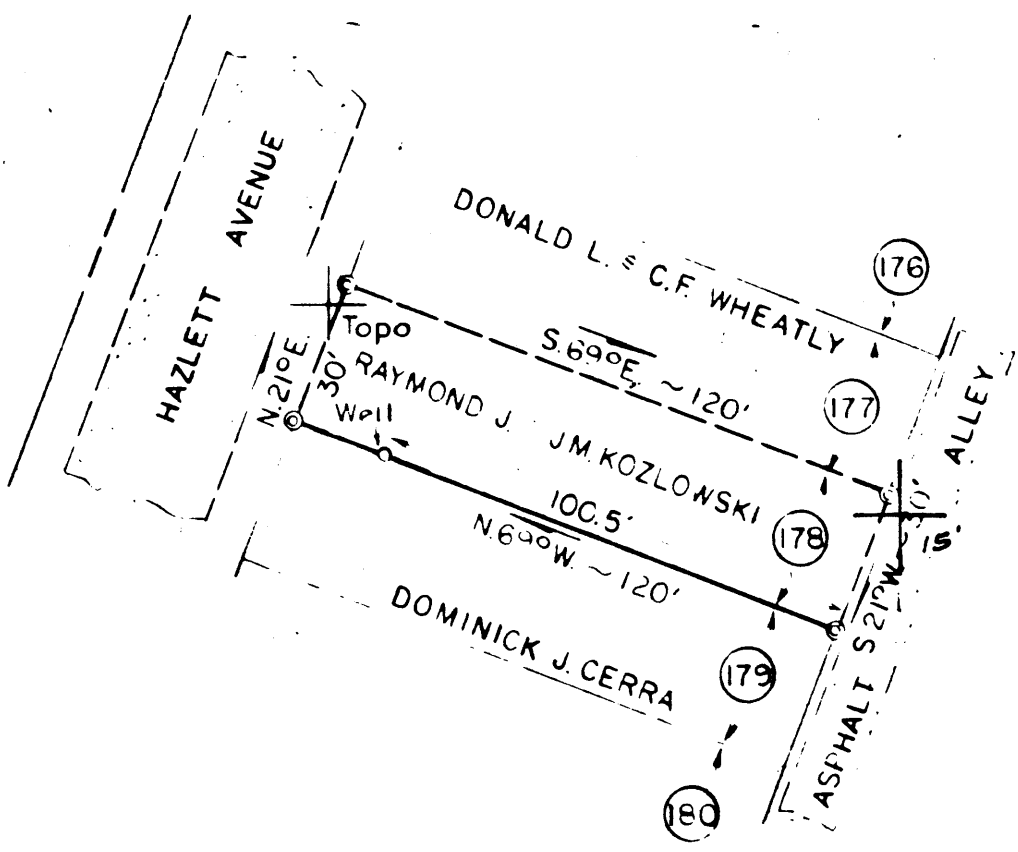

FILE NO _____
DRAWING NO. _____
SCALE 1" = 40'
MINIMUM DEGREE OF ACCURACY 1 in 200
PROVEN SOURCE OF ELEVATION Scaled from USGS. topo Map - 639'

I THE UNDERSIGNED, HEREBY CERTIFY THAT THIS PLAT IS CORRECT TO THE BEST OF MY KNOWLEDGE AND BELIEF AND SHOWS ALL THE INFORMATION REQUIRED BY LAW AND THE REGULATIONS ISSUED AND PRESCRIBED BY THE DEPARTMENT OF MINES.
(SIGNED) _____
RPE No 6918 LLS _____

PLACE SEAL HERE

(+) DENOTES LOCATION OF WELL ON UNITED STATES TOPOGRAPHIC MAPS
FORM IV-6 (8-78)



DATE April 16 19 81
OPERATOR'S WELL NO. ONC
API WELL NO. 47 - OHIO - 0027-R-P
STATE COUNTY PERMIT

STATE OF WEST VIRGINIA
DEPARTMENT OF MINES
OIL AND GAS DIVISION

WELL TYPE: OIL ___ GAS ___ LIQUID INJECTION ___ WASTE DISPOSAL ___
(IF "GAS,") PRODUCTION ___ STORAGE ___ DEEP ___ SHALLOW ___
LOCATION: ELEVATION 639' WATER SHED _____
DISTRICT Richland COUNTY Ohio
QUADRANGLE Wheeling
SURFACE OWNER Raymond J. & J.M. Kozlowski ACREAGE 0.08
OIL & GAS ROYALTY OWNER Same LEASE ACREAGE _____
LEASE NO. _____
PROPOSED WORK: DRILL ___ CONVERT ___ DRILL DEEPER ___ REDRILL ___ FRACTURE OR STIMULATE ___ PLUG OFF OLD FORMATION ___ PERFORATE NEW FORMATION ___ OTHER PHYSICAL CHANGE IN WELL (SPECIFY) _____

PLUG AND ABANDON CLEAN OUT AND REPLUG ___
TARGET FORMATION NA ESTIMATED DEPTH NA
WELL OPERATOR Steve Duckworth DESIGNATED AGENT Same
ADDRESS Davison Route Gassaway WVA 26624 ADDRESS _____
AUG 17 1981