

10800'

LATITUDE 40°5'

2600

LONGITUDE 80°40'

June 6/30/96

0.49  
2.06

WELL  
TOPO

SW CORNER OF PORCH  
51 JOAN ST.

PL

S33°12'E 32'

NICKELSON  
WELL

N73°42'25" 22.5'

N77°42'W 160'

WHITE BLOCK  
GARAGE  
41 JOAN ST.

NE CORNER OF  
GARAGE

NORTH

JOAN ST.


CREEK

SW CORNER OF GARAGE

(+) DENOTES LOCATION OF POINT ON UNITED STATES TOPOGRAPHIC MAPS

FILE NO. \_\_\_\_\_  
DRAWING NO. 4-30-96  
SCALE 1"=10'  
MINIMUM DEGREE OF ACCURACY 1/4" 200'  
PROVEN SOURCE OF ELEVATION GOVERNMENT  
1 MILE NORTH EAST (423)

I THE UNDERSIGNED, HEREBY CERTIFY THAT THIS PLAT IS CORRECT TO THE BEST OF MY KNOWLEDGE AND BELIEF AND SHOWS ALL THE INFORMATION REQUIRED BY LAW AND THE REGULATIONS ISSUED AND PRESCRIBED BY THE DEPARTMENT OF MINES.  
(SIGNED) Walter Rept  
R.P.E. 7410 L.L.S. 1128

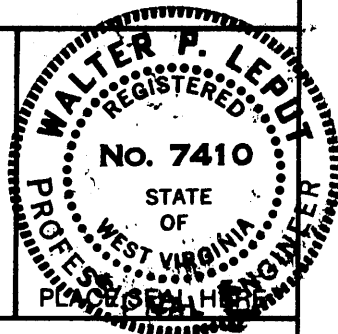

STATE OF WEST VIRGINIA  
DEPARTMENT OF MINES  
OIL AND GAS DIVISION



DATE \_\_\_\_\_, 19\_\_\_\_  
OPERATOR'S WELL NO. \_\_\_\_\_  
API WELL NO. \_\_\_\_\_

WELL TYPE: OIL \_\_\_ GAS \_\_\_ LIQUID INJECTION \_\_\_ WASTE DISPOSAL \_\_\_  
(IF "GAS,") PRODUCTION \_\_\_ STORAGE \_\_\_ DEEP \_\_\_ SHALLOW \_\_\_

LOCATION: ELEVATION 735 WATER SHED WHEELING CREEK  
DISTRICT TRIADAPHA COUNTY OHIO  
QUADRANGLE WHEELING 792

SURFACE OWNER NICKELSON ACREAGE \_\_\_\_\_  
OIL & GAS ROYALTY OWNER \_\_\_\_\_ LEASE ACREAGE \_\_\_\_\_

PROPOSED WORK: DRILL \_\_\_ CONVERT \_\_\_ DRILL DEEPER \_\_\_ REDRILL \_\_\_ FRACTURE OR  
STIMULATE \_\_\_ PLUG OFF OLD FORMATION \_\_\_ PERFORATE NEW  
FORMATION \_\_\_ OTHER PHYSICAL CHANGE IN WELL (SPECIFY) \_\_\_\_\_

PLUG AND ABANDON \_\_\_ CLEAN OUT AND REPLUG \_\_\_  
TARGET FORMATION \_\_\_\_\_ ESTIMATED DEPTH \_\_\_\_\_

WELL OPERATOR D.O.G. Oil & Gas DESIGNATED AGENT HYDROCARBON WELL SERVICES  
ADDRESS 10 McJannet Rd ADDRESS PO DRAWER 995 BUCKAMUNDA WVA  
PITCO WVA 26143 26201

COUNTY NAME

PERMIT

FORM IV-8 (8-78)

STATE OF WEST VIRGINIA  
DIVISION OF ENVIRONMENTAL PROTECTION  
SECTION OF OIL AND GAS

JUN 12 1996

AFFIDAVIT OF PLUGGING AND FILLING WELL

AFFIDAVIT SHOULD BE IN TRIPLICATE, one copy mailed to the Division, one copy to be retained by the Well Operator and the third copy (and extra copies if required) should be mailed to each coal operator at their respective addresses.

Farm name: Stackyard Hollow Creek Site Operator Well No.: #1

LOCATION: Elevation: 700 Quadrangle: Wheeling  
District: Glenwood County: Ohio  
Latitude: Feet South of 40 Deg. 05 Min. 00 Sec.  
Longitude: Feet West of 80 Deg. 40 Min. 00 Sec.

Well Type: OIL \_\_\_\_\_ GAS x

Company: State of WV \_\_\_\_\_  
\_\_\_\_\_  
\_\_\_\_\_

Coal Operator \_\_\_\_\_  
or Owner \_\_\_\_\_  
\_\_\_\_\_

Agent: \_\_\_\_\_

Coal Operator \_\_\_\_\_  
or Owner \_\_\_\_\_  
\_\_\_\_\_

Permit Issued: 02/06/96

AFFIDAVIT

STATE OF WEST VIRGINIA,  
County of Upshur ss:

Alvin Sorcan and Phillip Pulliam being first duly sworn according to law depose and say that they are experienced in the work of plugging and filling oil and gas wells and were employed by the above named well operator, and participated in the work of plugging and filling the above well, and Phil Tracy Oil and Gas Inspector representing the Director, say that said work was commenced on the 5 day of April, 1996, and that the well was plugged and filled in the following manner:

TYPE	FROM	TO	PIPE REMOVED	LEFT
6% gel	1000	960	6 1/2 62ft	N/A
cement	960	780	10 0ft	N/A
6% gel	780	300		
cement	300	surface		

*[Signature]* 6/13/96

Description of monument: Underground plate with API  
and that the work of plugging and filling said well was completed on the 26 day of April, 1996.


And further deponents saith not.

Phillip O. Pulliam  
Alvin Sorcan

Sworn and subscribe before me this 30 day of May, 1996  
My commission expires: August 4, 2003

Joyce Harlow  
Notary Public

Oil and Gas Inspector: Phillip Tracy JUN 14 1996

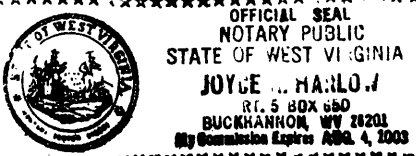

30005?  
30006?  
70011  
70013  
0.495  
2.066  
134-wheeling SW

21563