


*Contract Plugging*

(+) DENOTES LOCATION OF WELL ON UNITED STATES TOPOGRAPHIC MAPS

FILE NO. \_\_\_\_\_  
 DRAWING NO. 3-24-96  
 SCALE 1" = 20'  
 MINIMUM DEGREE OF ACCURACY 1 IN 200  
 PROVEN SOURCE OF ELEVATION BM (694)  
1 MILE SOUTH

I THE UNDERSIGNED, HEREBY CERTIFY THAT THIS PLAT IS CORRECT TO THE BEST OF MY KNOWLEDGE AND BELIEF AND SHOWS ALL THE INFORMATION REQUIRED BY LAW AND THE REGULATIONS ISSUED AND PRESCRIBED BY THE DEPARTMENT OF MINES.  
 (SIGNED) Walter P. Lopez  
 R.P.E. 7410 L.L.S. 1128

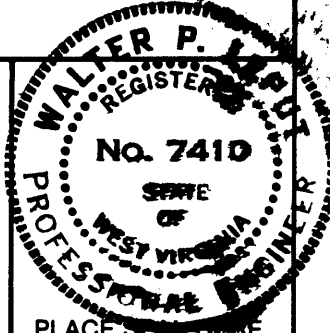

**STATE OF WEST VIRGINIA**  
 DEPARTMENT OF MINES  
 OIL AND GAS DIVISION



DATE 3-20 19 96  
 OPERATOR'S WELL NO. GOLDEN #7  
 API WELL NO. 47-069-00044P  
 STATE COUNTY PERMIT

WELL TYPE: OIL  GAS  LIQUID INJECTION  WASTE DISPOSAL   
 (IF "GAS,") PRODUCTION  STORAGE  DEEP  SHALLOW   
 LOCATION: ELEVATION 665 WATER SHED GLENN'S RUN  
 DISTRICT RICHLAND COUNTY OHIO  
 QUADRANGLE WHEELING W. VA. 7 1/2 MIN  
 SURFACE OWNER DOUG SARKIS ACREAGE \_\_\_\_\_  
 OIL & GAS ROYALTY OWNER \_\_\_\_\_ LEASE ACREAGE \_\_\_\_\_  
 LEASE NO. \_\_\_\_\_

PROPOSED WORK: DRILL  CONVERT  DRILL DEEPER  REDRILL  FRACTURE OR STIMULATE  PLUG OFF OLD FORMATION  PERFORATE NEW FORMATION  OTHER PHYSICAL CHANGE IN WELL (SPECIFY) \_\_\_\_\_

PLUG AND ABANDON  CLEAN OUT AND REPLUG

WEST VIRGINIA  
 DIVISION OF ENVIRONMENTAL PROTECTION  
 OFFICE OF OIL AND GAS  
 #10 McJUNKIN ROAD

ATED DEPTH \_\_\_\_\_  
 DESIGNATED AGENT AL SORCAN  
 ADDRESS PO DRAWER 976 BUCKHANNON, W.VA

FORM IV-6 (8-78)

COUNTY NAME \_\_\_\_\_  
 PERMIT \_\_\_\_\_

STATE OF WEST VIRGINIA  
DIVISION OF ENVIRONMENTAL PROTECTION  
SECTION OF OIL AND GAS

OCT 15 1996

Permitting  
Office of Oil & Gas  
AFFIDAVIT OF PLUGGING AND FILLING WELL

AFFIDAVIT SHOULD BE IN TRIPPLICATE, one copy mailed to the Division, one copy to be retained by the Well Operator and the third copy (and extra copies if required) should be mailed to each coal operator at their respective addresses.

Farm name: GOLDEN, ERIC/SUSAN SARKIS Operator Well No.:GOLDEN 1

LOCATION: Elevation: 665.00      Quadrangle: WHEELING  
District: RICHLAND              County: OHIO  
Latitude: 700 Feet South of 40 Deg. 7 Min. 30 Sec.  
Longitude 10050 Feet West of 80 Deg. 40 Min. 0 Sec.

Well Type: OIL \_\_\_\_\_ GAS   X  

Company: Department of Environmental Protection Coal Operator \_\_\_\_\_  
#10 McJunkin Road or Owner \_\_\_\_\_  
Nitro WV 25143 \_\_\_\_\_

Agent: \_\_\_\_\_ Coal Operator \_\_\_\_\_  
or Owner \_\_\_\_\_

Permit Issued: 04/08/96

AFFIDAVIT

STATE OF WEST VIRGINIA,  
County of Upshur ss:

Alvin Sorcan and Phillip Pulliam being first duly sworn according to law depose and say that they are experienced in the work of plugging and filling oil and gas wells and were employed by the above named well operator, and participated in the work of plugging and filling the above well, and Phillip Tracy Oil and Gas Inspector representing the Director, say that said work was commenced on the 11 day of March, 1996, and that the well was plugged and filled in the following manner:

TYPE	FROM	TO	PIPE REMOVED	LEFT
gel	TD	710	10" 0	120
cement	710	540		
gel	540	485		
cement	485	345		
gel	345	100		
cement	100	surface		


Description of monument: Underground marker with API  
and that the work of plugging and filling said well was completed on the 20 day of March, 1996.

And further deponents saith not.

Phillip O. Pulliam  
Alvin Sorcan

Sworn and subscribe before me this 17 day of April, 1996  
My commission expires: August 4, 2003

Joseph K. Harlow  
Notary Public  
Phillip Tracy 04/25/96

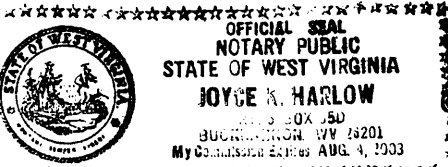

Oil and Gas Inspector: