

## **Final Well Report**


# Mark Hickman OHI 6H Ohio County, WV


Prepared for Mr. Matt Justus



Office of Oil and Gas
AUG 13 2018


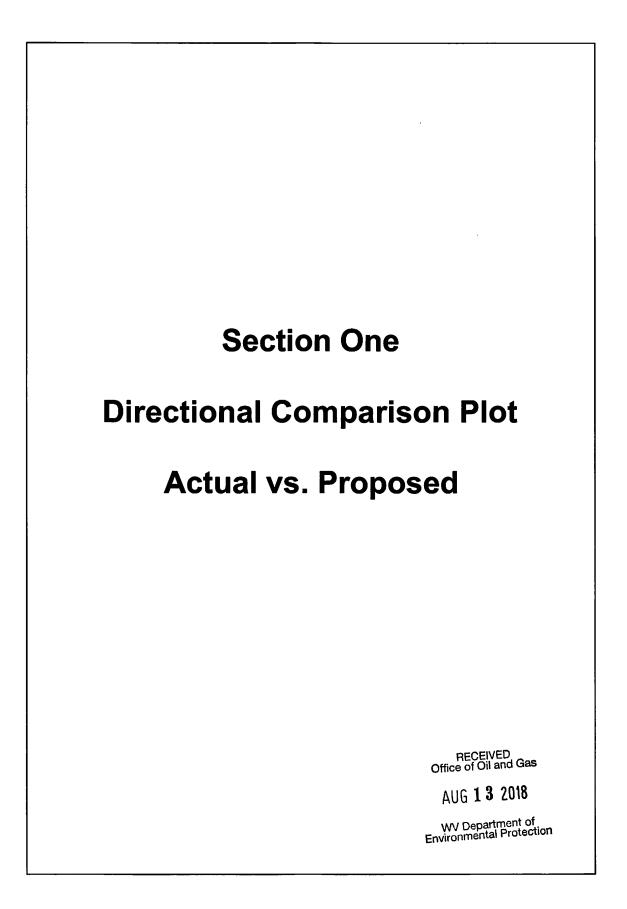

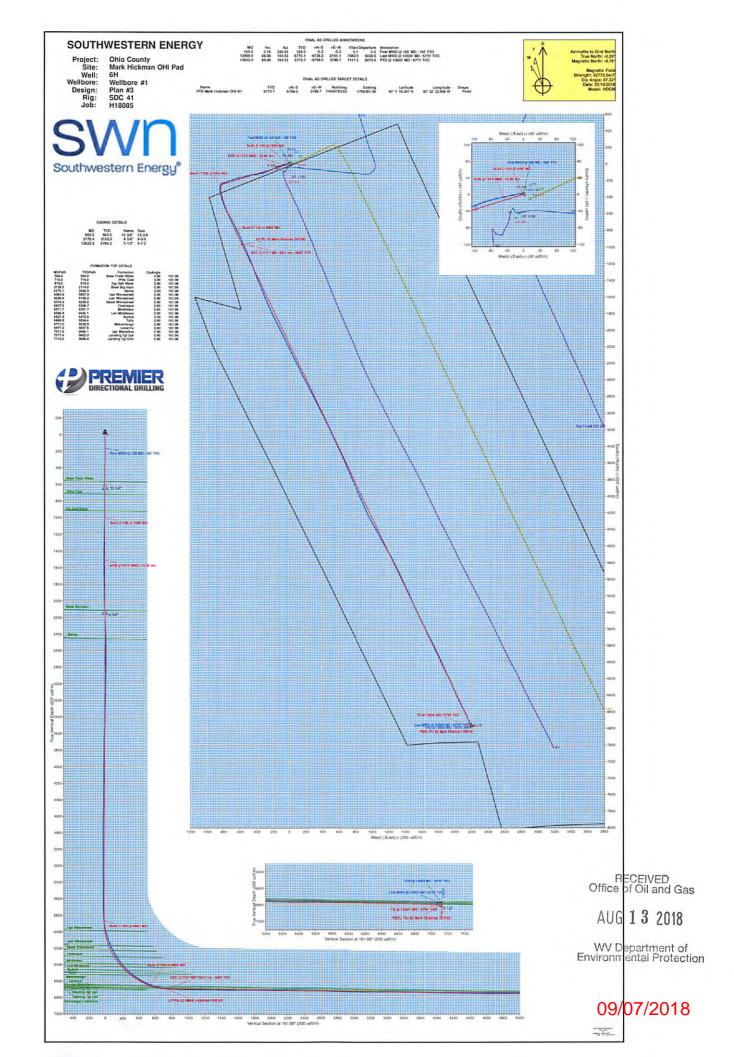



### **SOUTHWESTERN ENERGY**

Ohio County Mark Hickman OHI Pad 6H

Wellbore #1

Design: Wellbore #1

## **Standard Survey Report**

04 April, 2018

Office of Oil and Gas

AUG 13 2018

WV Department of Environmental Protection





#### PDD

#### Survey Report



Company:

SOUTHWESTERN ENERGY

Project: Ohio County

Site:

Mark Hickman OHI Pad

Well: 6H

Wellbore: Wellbore #1 Wellbore #1 Design:

Local Co-ordinate Reference:

TVD Reference:

MD Reference: North Reference:

Survey Calculation Method:

Database:

Well 6H

1281.8+26 @ 1307.8usft 1281.8+26 @ 1307.8usft

Grid

Minimum Curvature EDM 5000 14 Multi User

RECEIVED Office of Oil and Gas

AUG 13 2018

WV Department of Environmental Protection

Project Ohio County

Map System:

Universal Transverse Mercator (US Survey Fee System Datum:

NAD83 West Virginia - HARN

Geo Datum: Map Zone:

Zone 17N (84 W to 78 W)

Mean Sea Level

Site

Mark Hickman OHI Pad

Site Position: From: **Position Uncertainty:** 

Lat/Long

Northing: Easting:

Slot Radius:

14,541,552,86 usft 1,767,082.84 usft

13-3/16 '

Latitude: Longitude:

40° 2' 23.327 N 80° 32' 50.788 W

0.29

Well 6H

**Well Position** 

+N/-S +E/-W 0.0 usft 0.0 usft

0.0 usft

Northing: Easting:

14,541,552.85 usfl 1,767,082.84 usfl

Latitude: Longitude:

40° 2' 23.327 N 80° 32' 50.788 W

**Position Uncertainty** 

0.0 usft

Wellhead Elevation:

**Ground Level:** usfl

**Grid Convergence:** 

1,281.8 usfi

0.0

Wellbore

Wellbore #1

Field Strength Magnetics **Model Name** Declination Sample Date Dip Angle (°) (nT) 52,775.00000000 **HDGM** 02/19/18 -8.4767.32

Design

Wellbore #1

**Audit Notes:** 

Version: 1.0

Phase:

ACTUAL

0.0

Tie On Depth:

0.0

**Vertical Section:** 

Depth From (TVD)

(usft)

+N/-S (usft)

+E/-W (usft)

Direction (°)

161.98

**Survey Program** 

Date 04/04/18

From (usft) To

(usft)

Survey (Wellbore)

**Tool Name** 

0.0

Description

165.0

13,603.0 Survey #1 (Wellbore #1)

MWD+HRGM

OWSG MWD + HRGM

Survey

Measured Depth (usft)	Inclination (°)	Azimuth (°)	Vertical Depth (usft)	+N/-S (usft)	+E/-W (usft)	Vertical Section (usft)	Dogleg Rate (°/100usft)	Build Rate (°/100usft)	Turn Rate (°/100usft
0.0	0.00	0.00	0.0	0.0	0.0	0.0	0.00	0.00	0.0
165.0	0.16	220.92	165.0	-0.2	-0.2	0.1	0.10	0.10	0.0
First MWD	@ 165' MD / 1	165' TVD							
226.0	0.19	239.22	226.0	-0.3	-0.3	0.2	0.10	0.05	30.0
318.0	0.15	318.07	318.0	-0.3	-0.5	0.1	0.24	-0.04	85.7
409.0	0.04	23.76	409.0	-0.2	-0.6	0.0	0.15	-0.12	72.1
499.0	0.09	239.38	499.0	-0.2	-0.6	0.0	0.14	0.06	-160.4
589.0	0.27	288.93	589.0	-0.1	-0.9	-0.1	0.25	0.20	55.0
680.0	0.24	332.88	680.0	0.1	-1.2	-0.5	0.21	-0.03	48.3
764.0	0.34	304.71	764.0	0.4	-1.5	-0.8	0.20	0.12	-33.5
875.0	0.34	314.61	875.0	0.8	-2.0	-1.4	0.05	0.00	8.9



#### PDD Survey Report



RECEIVED Office of Oil and Gas

AUG 1 3 2018

WV Department of Environmental Protection

Company:

**SOUTHWESTERN ENERGY** 

Ohio County

Project: Site: Mark Hickman OHI Pad

Well: 6H

Wellbore: Wellbore #1 Wellbore #1 Design:

Local Co-ordinate Reference:

TVD Reference: MD Reference: North Reference:

**Survey Calculation Method:** 

Database:

1281.8+26 @ 1307.8usft Grid

1281.8+26 @ 1307.8usft

Well 6H

Minimum Curvature EDM 5000 14 Multi User

Measured			Vertical			Vertical	Dogleg	Build	Turn
Depth (usft)	Inclination (°)	Azimuth (°)	Depth (usft)	+N/-S (usft)	+E/-W (usft)	Section (usft)	Rate (°/100usft)	Rate (°/100usft)	Rate (°/100usft)
971.0	0.80	295.64	971.0	1.3	-2.8	-2.1	0.51	0.48	-19.76
1,065.0	3.56	268.15	1,064.9	1.5	-6.3	-3.4	3.06	2.94	-29.24
1,161.0	7.31	259.04	1,160.5	0.2	-15.3	-5.0	4.00	3.91	-9.49
1,257.0	11.07	258.00	1,255.2	-2.8	-30.3	-6.7	3.92	3.92	-1.08
1,354.0	14.42	258.71	1,349.8	-7.1	-51.2	-9.1	3.46	3.45	0.73
1,450.0	16.59	255.65	1,442.3	-12.9	-76.2	-11.3	2.41	2.26	-3.19
1,546.0	13.91	249.98	1,534.9	-20.2	-100.4	-11.8	3.19	-2.79	-5.91
1,642.0	13.50	246.95	1,628.2	-28.6	-121.5	-10.4	0.86	-0.43	-3.16
1,738.0	9.29	248.09	1,722.3	-35.8	-139.0	-8.9	4.39	-4.39	1.19
1,834.0	8.65	247.49	1,817.1	-41.5	-152.9	-7.8	0.67	-0.67	-0.63
1,930.0	11.16	247.30	1,911.7	-47.8	-168.1	-6.5	2.61	2.61	-0.20
2,026.0	12.92	247.30	2,005.6	-55.6	-186.6	-4.9	1.83	1.83	0.01
2,116.0	11.13	246.64	2,003.6	-62.9	-203.9	-3.2	1.99	-1.99	-0.74
2,110.0	10.96	244.80	2,193.7	-70.9	-203.9	-1.1	0.38	-0.17	-1.80
2,315.0	10.50	241.57	2,193.7	-70.9	-221.7	1.7	0.56	-0.17	-3.33
2,410.0	9.57	239.62	2,382.5	-87.4	-252.5	5.0	1.26	-1.21	-2.05
2,506.0	9.47	244.31	2,477.2	-94.8	-266.5	7.7	0.81	-0.10	4.89
2,603.0	9.30	252.17	2,572.9	-100.7	-281.2	8.8	1.33	-0.18	8.10
2,699.0	9.00	251.21	2,667.6	-105.5	-295.7	8.8	0.35	-0.31	-1.00
2,794.0	8.65	253.67	2,761.5	-109.9	-309.6	8.7	0.54	-0.37	2.59
2,890.0	8.85	258.95	2,856.4	-113.3	-323.7	7.6	0.86	0.21	5.50
2,987.0	8.90	262.63	2,952.2	-115.7	-338.5	5.3	0.59	0.05	3.79
3,082.0	8.09	258.10	3,046.2	-118.0	-352.3	3.2	1.11	-0.85	-4.77
3,178.0	8.15	253.71	3,141.2	-121.3	-365.5	2.3	0.65	0.06	-4.57
3,275.0	8.73	257.13	3,237.2	-124.9	-379.3	1.5	0.79	0.60	3.53
3,370.0	8.47	259.15	3,331.1	-127.8	-393.2	-0.1	0.42	-0.27	2.13
3,466.0	8.62	261.94	3,426.1	-130.2	-407.2	-2.2	0.46	0.16	2.91
3,562.0	9.90	264.95	3,520.8	-131.9	-422.6	-5.3	1.43	1.33	3.14
3,658.0	9.68	263.63	3,615.4	-133.5	-438.8	-8.8	0.33	-0.23	-1.38
3,755.0	8.89	262.57	3,711.1	-135.4	-454.3	-11.8	0.83	-0.81	-1.09
3,851.0	7.96	261.45	3,806.1	-137.3	-468.3	-14.3	0.98	-0.97	-1.17
3,947.0	8.72	259.56	3,901.1	-137.3		-14.3	0.98	0.79	-1.17
4,043.0	9.26	257.06	3,995.9	-142.7	-482.0 -496.7	-18.0	0.69	0.79	-2.60
4,140.0	7.59	250.34	4,091.8	-142.7	-496.7	-18.5	2.00	-1.72	-6.93
4,140.0	8.21	254.44	4,186.9	-150.6	-510.3	-18.5	0.87	0.65	4.27
4,230.0	0.21	254.44	4,100.9	-150.6	-522.9	-10.0	0.07	0.65	4.27
4,332.0	7.49	253.82	4,282.0	-154.2	-535.5	-19.1	0.76	-0.75	-0.65
4,428.0	6.57	254.76	4,377.3	-157.3	-546.8	-19.5	0.97	-0.96	0.98
4,525.0	8.01	259.39	4,473.5	-160.0	-558.8	-20.7	1.60	1.48	4.77
4,621.0	9.41	262.69	4,568.4	-162.3	-573.2	-23.0	1.55	1.46	3.44
4,716.0	10.00	258.56	4,662.1	-164.9	-589.0	-25.4	0.96	0.62	-4.35
4,813.0	9.92	253.06	4,757.6	-169.0	-605.2	-26.5	0.98	-0.08	-5.67
4,909.0	11.74	251.27	4,851.9	-174.5	-622.4	-26.5	1.93	1.90	-1.86
5,006.0	13.97	253.32	4,946.5	-181.1	-642.9	-26.7	2.35	2.30	2.11



#### PDD Survey Report



Company: Project: SOUTHWESTERN ENERGY

Ohio County

Site: Well: Mark Hickman OHI Pad

6H

6,785.0

6,833.0

6,881.0

6,929.0

6,977.0

7,026.0

7,079.0

7,122.0

7,219.0

7,270.0

7,365.0

7,462.0

7,557.0

7,653.0

7,749.0

7,845.0

56.75

59.43

63.22

67.31

71.78

74.44

77.76

81.10

87.33

87.31

88.08

90.47

90.27

89.99

88.82

88.47

150.47

151.10

152.13

152.81

152.79

154.03

155.07

156.31

155.92

156.29

156.80

159.76

157.99

157.75

158.35

158.40

6,567.3

6,592.7

6,615.7

6,635.8

6,652.6

6,666.8

6,679.5

6,687.4

6,697.2

6,699.6

6,703.4

6,704.6

6,704.0

6,703.8

6,704.8

6,707.1

-639.3

-674.9

-711.9

-750.6

-790.6

-832.5

-878.9

-917.4

-1,005.6

-1,052.2

-1,139.3

-1,229.4

-1,318.0

-1,406.9

-1,496.0

-1,585.2

-717.0

-697.1

-677.1

-657.0

-636.4

-615.5

-593.4

-576.0

-536.9

-516.3

-478.5

-442.6

-408.4

-372.2

-336.3

-300.9

386.1

426.1

467.5

510.5

554.9

601.3

652.3

694.3

790.2

840.9

935.4

1,032.2

1,127.0

1,222.8

1,318.5

1,414.3

4.93

5.69

8.12

8.62

9.31

5.94

6.55

8.27

6.44

0.73

0.97

3.92

1.87

0.38

1.37

0.37

Wellbore: Design:

Survey

Wellbore #1 Wellbore #1 Local Co-ordinate Reference:

TVD Reference: MD Reference:

North Reference: Survey Calculation Method:

Database:

Well 6H

1281.8+26 @ 1307.8usft 1281.8+26 @ 1307.8usft

Grid

Minimum Curvature EDM 5000 14 Multi User RECEIVED Office of Oil and Gas

AUG 1 3 2018

WV Department of Environmental Protection

5,102.0 5,198.0 5,294.0 5,391.0 5,487.0 5,583.0 5,679.0	14.07 13.59 13.09 11.48 10.19 10.67 10.43	250.76 251.78 252.59 246.92 250.46 253.33	5,039.6 5,132.8 5,226.2 5,321.0 5,415.3	-188.2 -195.6 -202.4 -209.5	-665.1 -686.8 -707.9	-26.7 -26.4	0.65 0.56	0.10 -0.50	-2.67 1.06
5,583.0	10.67	253.33	5,415.3	-209.5	-727.2	-25.8	2.07	-1.66	-5.85
				-216.1	-744.0	-24.7	1.51	-1.34	3.69
5,679.0	10.43		5,509.7	-221.4	-760.5	-24.7	0.74	0.50	2.99
		251.04	5,604.1	-226.8	-777.3	-24.8	0.50	-0.25	-2.39
5,775.0	10.10	248.97	5,698.5	-232.7	-793.4	-24.2	0.52	-0.34	-2.16
5,872.0	9.63	245.75	5,794.1	-239.0	-808.7	-22.8	0.75	-0.48	-3.32
5,920.0	10.07	232.69	5,841.4	-243.2	-815.7	-21.0	4.73	0.92	-27.21
5,967.0	11.54	216.64	5,887.6	-249.5	-821.8	-16.9	7.09	3.13	-34.15
6,015.0	13.82	203.32	5,934.4	-258.6	-826.9	-9.9	7.70	4.75	-27.75
6,063.0	15.77	193.92	5,980.8	-270.2	-830.7	0.0	6.43	4.06	-19.58
6,111.0	18.06	187.28	6,026.8	-283.9	-833.3	12.2	6.23	4.77	-13.83
6,160.0	20.34	182.77	6,073.0	-300.0	-834.6	27.1	5.55	4.65	-9.20
6,208.0	21.83	179.42	6,117.8	-317.2	-834.9	43.4	3.99	3.10	-6.98
6,256.0	22.59	173.65	6,162.3	-335.3	-833.8	60.9	4.81	1.58	-12.02
6,304.0	25.04	167.35	6,206.2	-354.4	-830.6	80.1	7.35	5.10	-13.13
6,352.0	27.98	164.46	6,249.1	-375.2	-825.3	101.5	6.69	6.13	-6.02
6,400.0	30.83	164.40	6,290.9	-397.9	-819.0	125.0	5.94	5.94	-0.13
6,449.0	33.83	162.61	6,332.3	-423.0	-811.6	151.2	6.43	6.12	-3.65
6,497.0	36.83	160.82	6,371.5	-449.3	-802.8	178.9	6.61	6.25	-3.73
6,545.0	39.81	160.42	6,409.2	-477.4	-793.0	208.7	6.23	6.21	-0.83
6,593.0	42.80	158.51	6,445.2	-507.1	-781.8	240.3	6.76	6.23	-3.98
6,641.0	46.05	156.97	6,479.5	-538.2	-769.1	273.8	7.13	6.77	-3.21
6,689.0	51.08	153.35	6,511.2	-570.8	-753.9	309.5	11.90	10.48	-7.54

-2.19

1.31

2.15

1.42

-0.04

2.53

1.96

2.88

0.73

0.54

3.05

-1.86

-0.25

0.63

4.58

5.58

7.90

8.52

9.31

5.43

6.26

7.77

6.42

-0.04

0.81

2.46

-0.21

-0.29

-1.22

-0.36



#### PDD Survey Report



Company: Project: **SOUTHWESTERN ENERGY** 

Ohio County

Site:

Mark Hickman OHI Pad

Well: 6H

Wellbore: Wellbore #1
Design: Wellbore #1

Local Co-ordinate Reference:

TVD Reference: MD Reference:

North Reference:

Survey Calculation Method:

Database:

Well 6H

1281.8+26 @ 1307.8usft 1281.8+26 @ 1307.8usft

Grid

Minimum Curvature EDM 5000 14 Multi User RECEIVED Office of Oil and Gas

AUG 1 3 2018

WV Department of Environmental Protection

#### Survey

Measured Depth (usft)	Inclination (°)	Azimuth (°)	Vertical Depth (usft)	+N/-S (usft)	+E/-W (usft)	Vertical Section (usft)	Dogleg Rate (°/100usft)	Build Rate (°/100usft)	Turn Rate (°/100usft)
7,940.0	90.08	156.87	6,708.3	-1,673.0	-264.8	1,509.0	2.34	1.69	-1.61
8,037.0	91.09	154.69	6,707.3	-1,761.5	-225.0	1,605.5	2.48	1.04	-2.25
8,132.0	90.56	153.50	6,705.9	-1,846.9	-183.5	1,699.6	1.37	-0.56	-1.25
8,228.0	88.82	153.59	6,706.4	-1,932.9	-140.8	1,794.5	1.81	-1.81	0.09
8,324.0	89.15	153.31	6,708.1	-2,018.7	-97.8	1,889.4	0.45	0.34	-0.29
8,421.0	89.37	153.68	6,709.4	-2,105.5	-54.6	1,985.4	0.44	0.23	0.38
8,517.0	89.00	153.81	6,710.8	-2,191.6	-12.1	2,080.4	0.41	-0.39	0.14
8,614.0	88.80	153.30	6,712.6	-2,278.4	31.1	2,176.3	0.56	-0.21	-0.53
8,710.0	88.82	154.65	6,714.6	-2,364.7	73.2	2,271.3	1.41	0.02	1.41
8,806.0	88.93	153.34	6,716.5	-2,450.9	115.3	2,366.4	1.37	0.11	-1.36
8,901.0	88.89	153.66	6,718.3	-2,536.0	157.7	2,460.3	0.34	-0.04	0.34
8,997.0	88.69	152.97	6,720.3	-2,621.7	200.8	2,555.2	0.75	-0.21	-0.72
9,093.0	88.60	152.37	6,722.6	-2,707.0	244.8	2,649.9	0.63	-0.09	-0.63
9,189.0	88.58	153.80	6,725.0	-2,792.5	288.3	2,744.7	1.49	-0.02	1.49
9,286.0	88.85	152.49	6,727.1	-2,879.1	332.1	2,840.6	1.38	0.28	-1.35
9,382.0	88.74	153.28	6,729.2	-2,964.5	375.8	2,935.3	0.83	-0.11	0.82
9,478.0	88.77	153.58	6,731.2	-3,050.3	418.8	3,030.2	0.31	0.03	0.31
9,574.0	88.63	153.93	6,733.4	-3,136.4	461.2	3,125.2	0.39	-0.15	0.36
9,670.0	90.01	154.27	6,734.6	-3,222,8	503.1	3,220.3	1.48	1.44	0.35
9,766.0	90.16	155.50	6,734.4	-3,309.7	543.9	3,315.6	1.29	0.16	1.28
9,861.0	90.25	155.26	6,734.1	-3,396.0	583.4	3,409.9	0.27	0.09	-0.25
9,957.0	89.68	155.31	6,734.1	-3,483.2	623.6	3,505.3	0.60	-0.59	0.05
10,053.0	89.29	155.54	6,735.0	-3,570.5	663.5	3,600.7	0.47	-0.41	0.24
10,149.0	89.29	157.44	6,736.2	-3,658.6	701.8	3,696.2	1.98	0.00	1.98
10,245.0	89.35	156.15	6,737.3	-3,746.8	739.6	3,791.8	1.35	0.06	-1.34
10,342.0	89.66	156.57	6,738.2	-3,835.6	778.5	3,888.3	0.54	0.32	0.43
10,437.0	89.53	156.28	6,738.8	-3,922.7	816.5	3,982.9	0.33	-0.14	-0.31
10,533.0	89.51	155.85	6,739.6	-4,010.5	855.5	4,078.4	0.45	-0.02	-0.45
10,629.0	89.53	155.95	6,740.5	-4,098.1	894.7	4,173.8	0.11	0.02	0.10
10,725.0	89.55	155.22	6,741.2	-4,185.5	934.3	4,269.2	0.76	0.02	-0.76
10,821.0	89.44	152.46	6,742.1	-4,271.7	976.6	4,364.2	2.88	-0.11	-2.88
10,917.0	89.53	150.85	6,742.9	-4,356.1	1,022.2	4,458.7	1.68	0.09	-1.68
11,013.0	89.55	150.47	6,743.7	-4,439.8	1,069.3	4,552.8	0.40	0.02	-0.40
11,109.0	89.75	151.70	6,744.3	-4,523.9	1,115.7	4,647.1	1.30	0.21	1.28
11,206.0	88.27	149.12	6,746.0	-4,608.2	1,163.6	4,742.1	3.07	-1.53	-2.66
11,302.0	90.19	151.79	6,747.3	-4,691.7	1,210.9	4,836.1	3.43	2.00	2.78
11,399.0	89.84	153.78	6,747.2	-4,777.9	1,255.2	4,931.9	2.08	-0.36	2.05
11,495.0	88.34	152.75	6,748.8	-4,863.7	1,298.4	5,026.8	1.90	-1.56	-1.07
11,591.0	88.58	155.27	6,751.3	-4,949.9	1,340.5	5,121.8	2.64	0.25	2.63
11,686.0	89.68	155.43	6,752.8	-5,036.2	1,380.1	5,216.1	1.17	1.16	0.17
11,782.0	90.56	153.15	6,752.6	-5,122.7	1,421.7	5,311.3	2.55	0.92	-2.38
11,877.0	90.47	157.66	6,751.7	-5,209.1	1,461.3	5,405.6	4.75	-0.09	4.75
11,973.0	89.13	155.10	6,752.1	-5,297.0	1,499.7	5,501.1	3.01	-1.40	-2.67
12,069.0	88.32	154.98	6,754.2	-5,384.0	1,540.2	5,596.4	0.85	-0.84	-0.13



### PDD

Survey Report



Company:

**SOUTHWESTERN ENERGY** 

Project:

Ohio County Mark Hickman OHI Pad

Site: Well:

Wellbore: Design: Wellbore #1 Wellbore #1 Local Co-ordinate Reference:

TVD Reference:

MD Reference: North Reference:

Survey Calculation Method:

Database:

Well 6H

1281.8+26 @ 1307.8usft 1281.8+26 @ 1307.8usft

Grid

Minimum Curvature EDM 5000 14 Multi User RECEIVED Office of Oil and Gas

AUG 1 3 2018

WV Department of Environmental Protection

Measured Depth (usft)	Inclination (°)	Azimuth (°)	Vertical Depth (usft)	+N/-S (usft)	+E/-W (usft)	Vertical Section (usft)	Dogleg Rate (°/100usft)	Build Rate (°/100usft)	Turn Rate (°/100usft)
12,165.0	88.89	155.14	6,756.5	-5,471.1	1,580.7	5,691.7	0.62	0.59	0.17
12,260.0	88.76	152.99	6,758.5	-5,556.5	1,622.2	5,785.8	2.27	-0.14	-2.26
12,356.0	89.02	153.05	6,760.3	-5,642.0	1,665.8	5,880.6	0.28	0.27	0.06
12,452.0	88.91	153.08	6,762.1	-5,727.6	1,709.3	5,975.4	0.12	-0.11	0.03
12,548.0	88.58	152.97	6,764.2	-5,813.1	1,752.8	6,070.2	0.36	-0.34	-0.11
12,643.0	89.31	156.40	6,765.9	-5,899.0	1,793.4	6,164.4	3.69	0.77	3.61
12,738.0	89.81	153.97	6,766.7	-5,985.2	1,833.3	6,258.7	2.61	0.53	-2.56
12,834.0	89.84	157.30	6,766.9	-6,072.6	1,872.9	6,354.1	3.47	0.03	3.47
12,931.0	89.75	154.34	6,767.3	-6,161.1	1,912.6	6,450.6	3.05	-0.09	-3.05
13,027.0	89.92	154.85	6,767.6	-6,247.8	1,953.8	6,545.8	0.56	0.18	0.53
13,123.0	89.88	157.52	6,767.7	-6,335.6	1,992.5	6,641.3	2.78	-0.04	2.78
13,219.0	89.86	153.86	6,768.0	-6,423.1	2,032.0	6,736.7	3.81	-0.02	-3.81
13,315.0	89.79	153.82	6,768.2	-6,509.3	2,074.4	6,831.7	0.08	-0.07	-0.04
13,411.0	90.08	153.89	6,768.4	-6,595.5	2,116.7	6,926.7	0.31	0.30	0.07
13,507.0	89.13	155.33	6,769.0	-6,682.2	2,157.8	7,021.9	1.80	-0.99	1.50
13,569.0	88.89	154.53	6,770.1	-6,738.3	2,184.1	7,083.5	1.35	-0.39	-1.29
Last MWD	@ 13569' MD	/ 6770' TVD							
13,603.0	88.89	154.53	6,770.7	-6,769.0	2,198.7	7,117.2	0.00	0.00	0.00

Design Targets									
Target Name - hit/miss target - Shape	Dip Angle	Dip Dir.	TVD (usft)	+N/-S (usft)	+E/-W (usft)	Northing (usft)	Easting (usft)	Latitude	Longitude
PTD Mark Hickman C	0.00	0.00	6,770.7	-6.769.0	2,198.7	14.534.783.83	1,769,281.56	40° 1' 16.297 N	80° 32' 22.958 W

- actual wellpath misses target center by 0.1usft at 13603.0usft MD (6770.7 TVD, -6769.0 N, 2198.7 E)

- Point

Measured	Vertical	Local Coo	rdinates	
Depth (usft)	Depth (usft)	+N/-S (usft)	+E/-W (usft)	Comment
165.0	165.0	-0.2	-0.2	First MWD @ 165' MD / 165' TVD
13,569.0	6,770.1	-6,738.3	2,184.1	Last MWD @ 13569' MD / 6770' TVD
13,603.0	6,770.7	-6,769.0	2,198.7	PTD @ 13603' MD / 6771' TVD

Checked By:	Approved By:	Date: