

### west virginia department of environmental protection

Office of Oil and Gas 601 57th Street, S.E. Charleston, WV 25304 (304) 926-0450 fax: (304) 926-0452 Jim Justice , Governor Austin Caperton , Cabinet Secretary www.dep.wv.gov

Tuesday, December 05, 2017 WELL WORK PERMIT Horizontal 6A / New Drill

SWN PRODUCTION COMPANY, LLC POST OFFICE BOX 12359

SPRING, TX 773914954

Re: Permit appr

Permit approval for ESTHER WEEKS OHI 201H

47-069-00256-00-00

This well work permit is evidence of permission granted to perform the specified well work at the location described on the attached pages and located on the attached plat, subject to the provisions of Chapter 22 of the West Virginia Code of 1931, as amended, and all rules and regulations promulgated thereunder, and to any additional specific conditions and provisions outlined in the pages attached hereto. Notification shall be given by the operator to the Oil and Gas Inspector at least 24 hours prior to the construction of roads, locations, and/or pits for any permitted work. In addition, the well operator shall notify the same inspector 24 hours before any actual well work is commenced and prior to running and cementing casing. Spills or emergency discharges must be promptly reported by the operator to 1-800-642-3074 and to the Oil and Gas Inspector.

Please be advised that form WR-35, Well Operators Report of Well Work is to be submitted to this office within 90 days of completion of permitted well work, as should form WR-34 Discharge Monitoring Report within 30 days of discharge of pits, if applicable. Failure to abide by all statutory and regulatory provisions governing all duties and operations hereunder may result in suspension or revocation of this permit and, in addition, may result in civil and/or criminal penalties being imposed upon the operators.

Per 35 CSR 4-5.2.g this permit will expire in two (2) years from the issue date unless permitted well work is commenced. If there are any questions, please feel free to contact me at (304) 926-0450.

James A. Martin Chief

Operator's Well Number: ESTHER WEEKS OHI 201H

Farm Name: ESTHER H WEEKS

U.S. WELL NUMBER: 47-069-00256-00-00

Horizontal 6A / New Drill

Date Issued: 12/5/2017

Promoting a healthy environment.

API Number: 69-00256

### **PERMIT CONDITIONS**

West Virginia Code § 22-6A-8(d) allows the Office of Oil and Gas to place specific conditions upon this permit. Permit conditions have the same effect as law. Failure to adhere to the specified permit conditions may result in enforcement action.

### **CONDITIONS**

- This proposed activity may require permit coverage from the United States Army Corps of Engineers (USACE). Through this permit, you are hereby being advised to consult with USACE regarding this proposed activity.
- 2. If the operator encounters an unanticipated void, or an anticipated void at an unanticipated depth, the operator shall notify the inspector within 24 hours. Modifications to the casing program may be necessary to comply with W. Va. Code § 22-6A-5a (12), which requires drilling to a minimum depth of thirty feet below the bottom of the void, and installing a minimum of twenty (20) feet of casing. Under no circumstance should the operator drill more than one hundred (100) feet below the bottom of the void or install less than twenty (20) feet of casing below the bottom of the void.
- 3. When compacting fills, each lift before compaction shall not be more than 12 inches in height, and the moisture content of the fill material shall be within limits as determined by the Standard Proctor Density test of the actual soils used in specific engineered fill, ASTM D698, Standard Test Method for Laboratory Compaction Characteristics of Soil Using Standard Effort, to achieve 95 % compaction of the optimum density. Each lift shall be tested for compaction, with a minimum of two tests per lift per acre of fill. All test results shall be maintained on site and available for review.
- 4. Operator shall install signage per § 22-6A-8g (6) (B) at all source water locations included in their approved water management plan within 24 hours of water management plan activation.
- 5. Oil and gas water supply wells will be registered with the Office of Oil and Gas and all such wells will be constructed and plugged in accordance with the standards of the Bureau for Public Health set forth in its Legislative rule entitled *Water Well Regulations*, 64 C.S.R. 19. Operator is to contact the Bureau of Public Health regarding permit requirements. In lieu of plugging, the operator may transfer the well to the surface owner upon agreement of the parties. All drinking water wells within fifteen hundred feet of the water supply well shall be flow tested by the operator upon request of the drinking well owner prior to operating the water supply well.
- 6. Pursuant to the requirements pertaining to the sampling of domestic water supply wells/springs the operator shall, no later than thirty (30) days after receipt of analytical data provide a written copy to the Chief and any of the users who may have requested such analyses.
- 7. 24 hours prior to the initiation of the completion process the operator shall notify the Chief or his designee.
- 8. During the completion process the operator shall monitor annular pressures and report any anomaly noticed to the chief or his designee immediately.
- 9. If any explosion or other accident causing loss of life or serious personal injury occurs in or about a well or well work on a well, the well operator or its contractor shall give notice, stating the particulars of the explosion or accident, to the oil and gas inspector and the Chief, within 24 hours of said accident.
- 10. During the casing and cementing process, in the event cement does not return to the surface, the oil and gas inspector shall be notified within 24 hours.

API Number: <u>69 - 00256</u>

### **PERMIT CONDITIONS**

11. The operator shall provide to the Office of Oil and Gas the dates of each of the following within 30 days of their occurrence: completion of construction of the well pad, commencement of drilling, cessation of drilling, cessation of drilling, sending an email to DEPOOGNotify@wv.gov.

WW-6B (04/15)

API NO. 47-088 -		
OPERATOR WEL	L NO.	Esther Weeles CHi 201H
Well Pad Name	Esther	Weeks OHI Pad

### STATE OF WEST VIRGINIA DEPARTMENT OF ENVIRONMENTAL PROTECTION, OFFICE OF OIL AND GAS WELL WORK PERMIT APPLICATION

1) Well Operato	or: SWN	Production C	io., LLC	494512924	069-Ohio	Triadelhp 648- Valley Grove
				Operator ID	County	District Quadrangle
2) Operator's W	Vell Numbe	Esther We	eks OH	201H Well Pa	d Name: Esth	er Weeks OHI Pad
3) Farm Name/	Surface Ow	ner: Karla J	. Weeks	Public Ros	ad Access: Ok	fahoma Road
4) Elevation, cu	rrent groun	id: 1256'	E	levation, proposed	TIOST-CONSTRUCT	ion: 1256'
5) Well Type	(a) Gas	x	Oil			
	Other		_		erground Stora	ge
	(b)If Gas	Shallow	Х	Dеер		
		Horizontal	X		1	<del></del>
<ol><li>6) Existing Pad:</li></ol>	: Yes or No	Yes			C10	LQ 11-29-17
7) Proposed Tar	get Format	ion(s), Depth	(s). Antic	ipated Thickness a	nd Experted P	recouratele
Target Formatio	n- Marcellus,	Target Top TVD-	6639' Tan	get Base TVD- 6682',	Anticipated Thick	ness- 43', Associated Pressure-4330
8) Proposed Tot						
9) Formation at				)	····	
10) Proposed To	otal Measur	ed Depth: 1	2598'	-		
II) Proposed Ho	orizontal Le	g Length: 5	150.13			
12) Approximat	e Fresh Wa	ter Strata Dep	oths:	569'		
13) Method to D	etermine F	resh Water D	enths: f	rom nearby water	wells	
14) Approximat				, , , , , , , , , , , , , , , , , , , ,	170110	
15) Approximat		-				
I6) Approximat	e Depth to )	Possible Void	(coal mi	ne, karst, other):	Vone that we	are aware of.
17) Does Propos				_		
lirectly overlyin	g or adjace	ut to an active	coan sear	Yes	No	X
(a) If Yes, prov	ride Mine I	nfo: Name:				
		Depth:	***			
		Seam:			RECE	EIVED
		Owner				il and Gas
					<del></del>	

NOV 29 2017

WV Department of Environmental Protection Section 19 Protection 19 Prote

WW-6B (04/15)

API NO. 47- 069

OPERATOR WELL NO. Esther Weeks OHI 201H

Well Pad Name: Esther Weeks OHI Pad

18)

### CASING AND TUBING PROGRAM

TYPE	Size (in)	New or Used	Grade	Weight per ft. (lb/ft)	FOOTAGE: For Drilling (ft)	INTERVALS: Left in Well (ft)	CEMENT: Fill-up (Cu. Ft.)/CTS
Conductor	20"	New	H-40	94#	100'	100'	CTS
Fresh Water	13 3/8"	New	H-40	48#	669'	669'	626 sx/CTS
Coal	9 5/8"	New	J-55	36#	2157'	2157'	812 sx/CTS
Intermediate	7"	New	J-55	20#	If Needed	If Needed	If Needed/As Needed
Production	5 1/2"	New	HCP-110	20#	12,598'	12,598'	lead 950 sx Tail 1373 ax inside intermedia
Tubing	2 3/8"	New	HCP-110	4.7#	Approx. 6662'	Approx. 6662'	
Liners							

C. 800 8.15.17

ТҮРЕ	Size (in)	Wellbore Diameter (in)	Wall Thickness (in)	Burst Pressure (psi)	Anticipated Max. Internal Pressure (psi)	Cement Type	Cement Yield (cu. ft./k)
Conductor	20"	30"	0.25	2120	81	Class A	1.19/50% Excess
Fresh Water	13 3/8"	17.5"	0.380	2740	633	Class A	1.19/50% Excess
Coal	9 5/8"	12 1/4"	0.395	3950	1768	Class A	1.19/50% Excess
Intermediate	7"	8 3/4"	0.317	4360	3250	Class A	1.20/50% Excess
Production	5 1/2"	8 3/4"	0.361	12360	9500	Class A	1.20/50% Excess
Tubing	2 3/8"	4.778"	0.190	Approx 8193'	Approx 8193'		
Liners							

**PACKERS** 

RECEIVED Office of Oil and Gas

Kind:	10K Arrowset AS-1X	SEP - 5-2017  WV Department of Environmental Protect
Sizes:	5 1/2"	Environmental Protect
Depths Set:		

WW-6B (10/14)

API NO. 47- 069 -

OPERATOR WELL NO. Esther Weeks OHI 201H
Well Pad Name: Esther Weeks OHI Pad

19) Describe proposed well work, including the drilling and plugging back of any pilot hole:

Drill and stimulate any potential zones between and including the Benson to Marcellus. \*\*If we should encounter a void place basket above and below void area- balance cement to bottom of void and grout from basket to surface. Run casing not less than 20' below void nor more than 50' below void. (\*If freshwater is encountered deeper than anticipated it must be protected, set casing 50' below and cts.)

20) Describe fracturing/stimulating methods in detail, including anticipated max pressure and max rate:

Well will be perforated within the target formation and stimulated with a slurry of water, sand, and chemical additives at a high rate. This will be performed in stages with the plug and perf method along the wellbore until the entire lateral has been stimulated within the target formation. All stage plugs are then drilled out and the well is flowed back to surface. The well is produced through surface facilities consisting of high pressure production unites, vertical separation units, water and oil storage tanks. Max press and anticipated max rate- 9000 lbs @ 80 barrels a minute.

- 21) Total Area to be disturbed, including roads, stockpile area, pits, etc., (acres): 18.41
- 22) Area to be disturbed for well pad only, less access road (acres): 8.70
- 23) Describe centralizer placement for each casing string:

All casing strings will be ran with a centralizer at a minimum of 1 per every 3 joints of casing.

24) Describe all cement additives associated with each cement type:

See Attachment \*\*\*

RECEIVED
Office of Oil and Gas

SEP - 5 2017

WV Department of Environmental Protection

25) Proposed borehole conditioning procedures:

All boreholes will be conditioned with circulation and rotation for a minimum of one bottoms up and continuing until operator is satisfied with borehole conditions.

\*Note: Attach additional sheets as needed.

**Schlumberger Cement Additives** 

		- Januari Berg	ger Centent Additives	
	Product Name	Product Use	Chemical Name	CAS Number
Surface	5001	accelerator	calcium chloride	10043-52-4
ntermedlate Surface	5001	accelerator	calcium chloride	10043-52-4
	D080	dispersant	sodium polynaphthalene sulfonate	9008-63-3
ő "	D801	retarder	aromatic polymer derivative	propriatary
Kick Off Plug	D047	antifoam	polypropylene glycol	25322-69-4
	D167	fluid loss	aliphatic amide polymer	propriatary
	D154	extender	non-crystalline silica	7631-86-9
	D400	gas migration	boric acid	10043-35-3
þ	D046	antifoam	polypropylene glycol fullers earth (attapulgite)	25322-69-4 8031-18-3
ilon-Le	D201	retarder	chrystalline silica metal oxide	14808-60-7 propriatary
Production-Lead	D202	dispersant	sulphonated synthetic polymer formaldehyde (impurity)	propriatary propriatary
	D046	antifoam	polypropylene glycol fullers earth (attapulgite)	25322-69-4 8031-18-3
	D167	fluid loss	aliphatic amide polymer	propriatary
-Tall	D065	dispersant	sodium polynaphthalene sulfonate sodium sulfate	9008-63-3 7757-82-6
Production-Tall	D201	retarder	chrystalline silica	14808-60-7 propriatary
Po	D153	anti-settling	chrystalline silica	14808-60-7

Office of Oil and Gas

SEP - 5 2017

WV Department of Environmental Protection



SWN Production Company, LLC P O Box 12359 Spring, Texas 77391-2359 www.swn.com

August 10, 2017

Ms. Laura Adkins Office of Oil & Gas 601 57<sup>th</sup> Street Charleston, WV 25304

RE: Proposed New Well Esther Weeks OHI 201H

Dear Ms. Adkins

SWN has reviewed the area of the above mentioned well and discovered no shallow wells within 500' of the lateral. This well is situated on the Weeks' property, in Triadelphia District, Ohio County, West Virginia.

If you have any questions or desire additional information, please me at 304-884-1614

Thank you

Sincerely,


Brittany Woody Regulatory Analyst Southwestern Energy Production Company, LLC PO Box 1300 Jane Lew, WV 26378

RECEIVED Office of Oil and Gas

SEP - 5 2017

WV Department of Environmental Protection

R2 wV+°

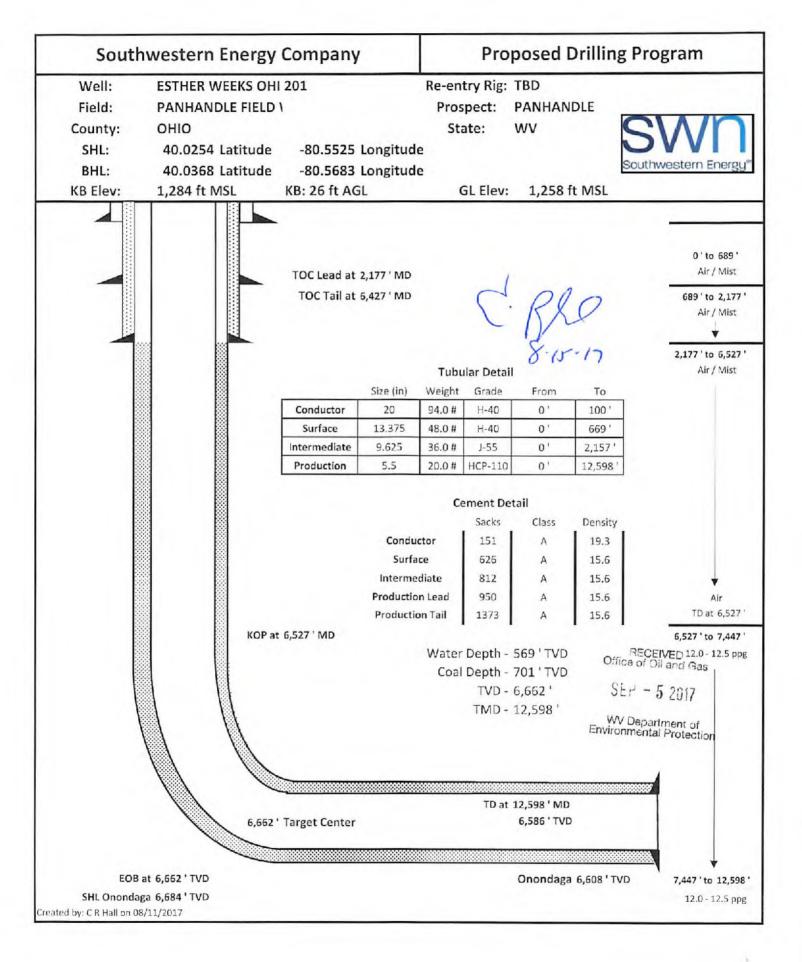

12/08/2017

WW-9 (4/16)

API Number	47 - 69	
Open	ator's Well 1	No. Esther Weeks OHI 201H

### STATE OF WEST VIRGINIA DEPARTMENT OF ENVIRONMENTAL PROTECTION OFFICE OF OIL AND GAS

FLUIDS/ CUTTINGS DISPO	OSAL & RECLAMATION PLAN
perator Name SWN Production Company, LLC	OP Code 494512924
atershed (HUC 10) Upper Ohio South	Quadrangle Valley Grove
o you anticipate using more than 5,000 bbls of water to comply vill a pit be used? Yes No	
If so, please describe anticipated pit waste: closed loop	p system in place at this time- cuttings will be taken to a permitted landfill
Will a synthetic liner be used in the pit? Yes	No If so, what ml.?
Proposed Disposal Method For Treated Pit Wastes:	
Land Application	
Underground Injection (UIC Permit	(Number)
	ed well, API # will be included with the WR-34/DDMR &/or permit addendum
Off Site Disposal (Supply form WW	/-9 for disposal location) put in steel tanks and reused or taken to a permitted disposal facility
Other (Explain now back fluids will be	put in steel talks and reused of taken to a permitted disposal radiity
Vill closed loop system be used? If so, describe: Yes	
rilling medium anticipated for this well (vertical and horizonta	al)? Air, freshwater, oil based, etc. air drill to KOP, fluid cell with SOBM from KCP to TD
-If oil based, what type? Synthetic, petroleum, etc. syn	nthetic oil base
dditives to be used in drilling medium? see attached sheets	
	- Chita ata  andfill
Orill cuttings disposal method? Leave in pit, landfill, removed	
	used? (cement, lime, sawdust)
-Landfill or offsite name/permit number?	S grading SWF-4902, Northwestern SWF-1025, Short Croek 1034WV0109517/CID28726, Carbon Limeston 28726-CID28725
	Gas of any load of drill cuttings or associated waste rejected at any within 24 hours of rejection and the permittee shall also disclose
on August 1, 2005, by the Office of Oil and Gas of the West Vir provisions of the permit are enforceable by law. Violations of aw or regulation can lead to enforcement action.	conditions of the GENERAL WATER POLLUTION PERMIT issued reginia Department of Environmental Protection. I understand that the fany term or condition of the general permit and/or other applicable rexamined and am familiar with the information submitted on this don my inquiry of those individuals immediately responsible for rue, accurate, and complete. I am aware that there are significant of fine of Oil and SEP - 5 20
Company Official Title Regulatory Supervisor	WV Department Environmental Prot
company Official Title (Cognition) Supervisor	
. Ih	
Subscribed and sworn before me this   0 day of	OFFICIAL SEAL Notary Public, State of West Vir
Buttary & Noody	Notary Public Sale BRITTANY R WOOD Sale Elkins Road Buckhannon, WV 25201
My commission expires U 117772	My commission expires November 27

Operator's Well No. Esther Weeks OHI 201H

Proposed Revegetation Treatment: Acres Disturbed	18.41	Prevegetation pl	I
Limes determined by pH test min. 2 Tons/acre or to co	rrect to pH 8.70		
Fertilizer type 10-20-20			
Fertilizer amount 600	lbs/acre		
Mulch_ Hay/Straw 2.5	Tons/acre		
	Seed Mixtures		
Temporary		Perma	nent
Seed Type Ibs/acre **See Attachment		Seed Type	lbs/acre
Attach: Maps(s) of road, location, pit and proposed area for lorovided). If water from the pit will be land applied.			
Maps(s) of road, location, pit and proposed area for larovided). If water from the pit will be land applied, creage, of the land application area.	include dimensions (L	.x W x D) of the pit, and	dimensions (L x W), and area in
Maps(s) of road, location, pit and proposed area for I rovided). If water from the pit will be land applied, creage, of the land application area. Thotocopied section of involved 7.5' topographic she	include dimensions (L	x W x D) of the pit, and	dimensions (L x W), and area in

### **Drilling Mediums**

Synthetic Oil
Brine
Barite
Calcium Chloride
Lime
Organophilic Bentonite
Primary and Secondary Emulsifiers
Gilsonite
Calcium Carbonate

**Friction Reducers** 





### **WVD Seeding Specification**



Pelletized Lime @ 2 Tons per Acre

Oct. 15th- April 15th

To Order Seed contact Lyndsi Eddy Flippo office 570-996-4271 cell 501-269-5451 lyndsi\_eddy@swn.com

(please allow 7 to 10 days for delivery)

### **NON-ORGANIC PROPERTIES**

Seed Mixture: ROW Mix	SWI	N Supplied
Orchardgrass	40%	
Timothy	15%	
Annual Ryegrass	15%	
Brown Top Millet	5%	
Red Top	5%	
Medium Red Clover	5%	All legumes are
White Clover	5%	innoculated at 5x normal
Birdsfoot Trefoil	5%	rate
Rough Bluegrass	5%	
Apply @ 100lbs per acre April 16th- Oct. 14th		Apply @ 200lbs per acre Oct. 15th- April 15th PLUS

### SOIL AMENDMENTS

10-20-20 Fertilizer	*Apply @ 500lbs per Acre
Pelletized Lime	Apply @ 2 Tons per Acre
	*unless otherwise dictated by soil test results

#### Seeding Calculation Information:

1452	of 30' ROW/LOD IS One Acre
871'	of 50' ROW/LOD is One Acre
622'	of 70' ROW/LOD is One Acre

#### Synopsis:

Every 622 linear feet in a 70' ROW/LOD, you should be using (2) 50lb bags of seed, (4) 50lb bags of fertilizer and (80) 50lb bags of Lime (2x seed in winter months + 50lb Winter Wheat/ac).

#### Special Considerations:

Landowner Special Considerations including CREP program participants require additional guidance that is not given here. Discuss these requirements with SWN supervision at the beginning of tle project to allow time for special seed delivery.

### ORGANIC PROPERTIES

Seed Mixture: SWN Production Organ	nic Mix	SWN Supplied
Organic Timothy	50%	
Organic Red or White Clover	50%	
OR		
Organic Perennial Ryegrass	50%	
Organic Red or White Clover	50%	
Apply @ 100lbs per acre		Apply @ 200lbs per acre
April 16th- Oct. 14th		Oct. 15th- April 15th

### WETLANDS (delineated as jurisdictional wetlands)

Organic Fertilizer @ 200lbs per Acre

April 16th- Oct. 14th

Seed Mixture: Wetland Mix	SWN Supplied
VA Wild Ryegrass	20%
Annual Ryegrass	20%
Fowl Bluegrass	20%
Cosmos 'Sensation'	10%
Redtop	5%
Golden Tickseed	5%
Maryland Senna	5%
Showy Tickseed	5%
Fox Sedge	2.5%
Soft Rush	2.5%
Woolgrass	2.5%
Swamp Verbena	2.5%
Apply @ 25lbs per acre	Apply @ 50lbs per acre

NO FERTILIZER OR LIME INSIDE WETLAND LIMITS

## MARCELLUS WELL DRILLING PROCEDURES AND WELL SITE SAFETY PLAN



SWN Production Company, LLC 179 Innovation Drive Jane Lew, West Virginia 26378

API NO. 47-XXX-XXXXX
WELL NAME: Esther Weeks OHI 201H
Valley Grove QUAD
Triadelphia DISTRICT
Ohio COUNTY, WEST VIRGINIA


Submitted by:		
Dee Southall	Date:	8/10/2017
Title:	SWN P	roduction Co., LLC
Title: 671 & kes Zupentr	Date:	8.15.17
Approved by:	_ Date:	
Title:	-	


SWN PRODUCTION COMPANY, LLC - CONFIDENTIAL

RECEIVED Office of Oil and Gas

SEP - 5 2017

WV Department of Environmental Protection

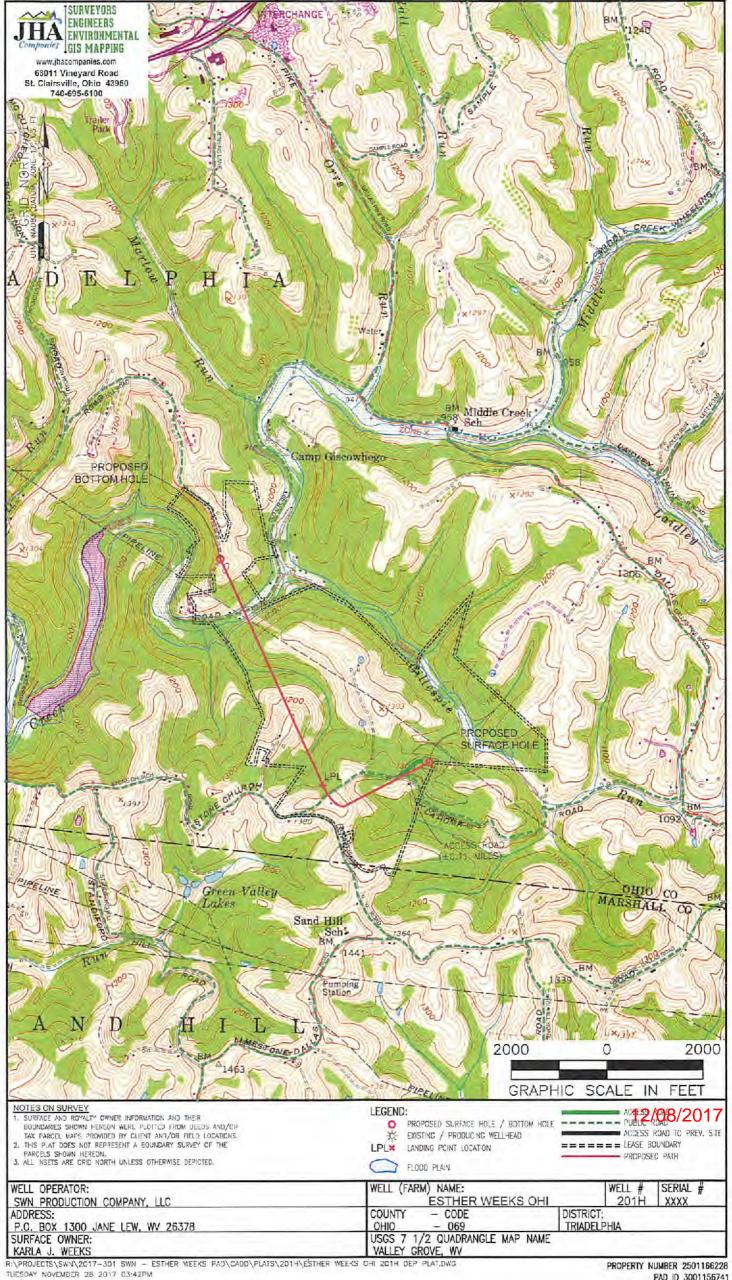

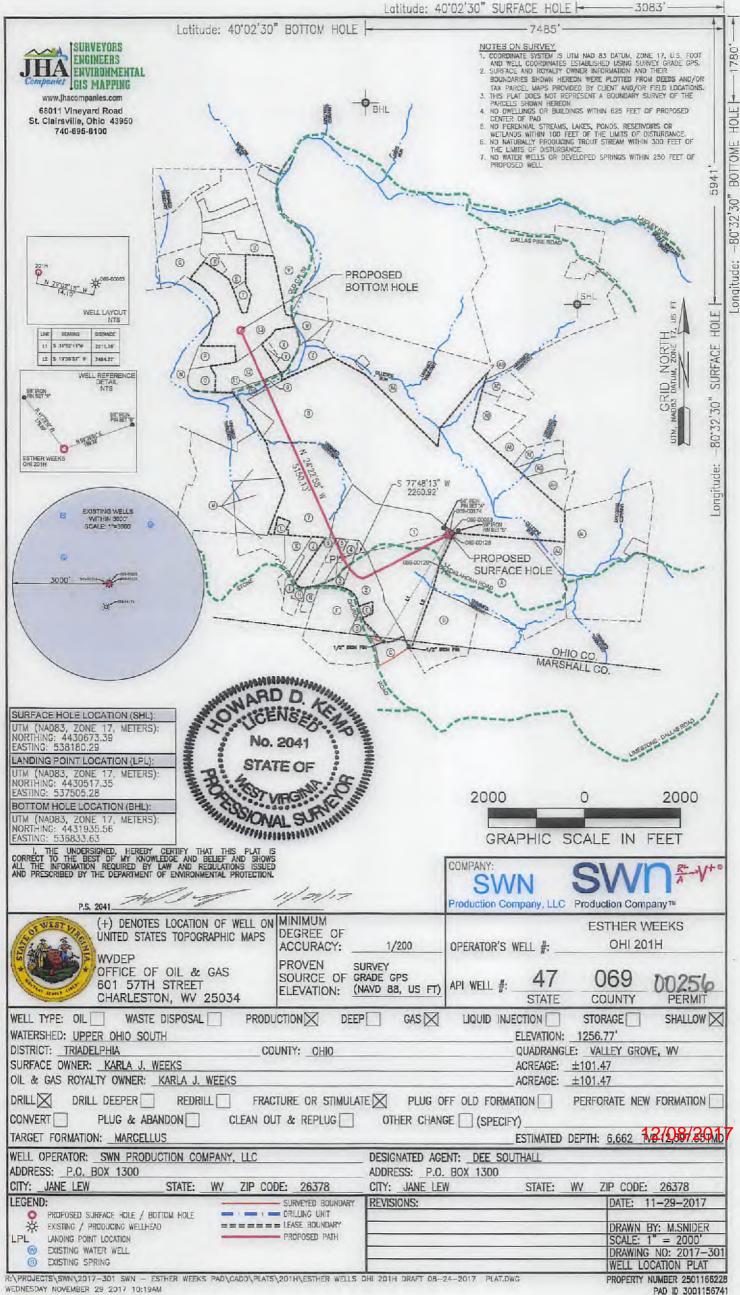

3083'-

	WELL BORE TABLE FOR SURFACE / ROYALTY	OWNERS	
TRACT	SURFACE OWNER (S) / ROYALTY OWNER (R)	TAX PARCEL	ACRES
1	KARLA J. WEEKS (S)/(R)	05-T19-0012.0000	101.47
TRACT	SURFACE OWNER	TAX PARCEL	ACRES
2	KEITH A. & NANCY J. MCCORD	06-T19-0017.0000	23.19
3	JOHN E. BARTON	06-T19-0004.0000	0.716
4	JAMES S. HAUGHT	06-T19-0004.0002	4.84
5	JAMES S. HAUGHT	06-T19-0004.0004	5.22
6	MICHAEL TODD & ROBERTA MARLENE CLUTTER	06-T19-0004.0003	5.420
7.	MITCHELL R. HOLMES & PATRICIA A. HOLMES	06-T19-0005.0000	60.00
8	JOHN E. WEEKS AND MARIMAR WEEKS	06-T19-0006.0000	262.043
9	WHEELING CREEK WATERSHED PROTECTION AND FLOOD PREVENTION COMMISSION	06-T14-0006.0001	2.00
10	JOHN E. AND TRINA M .WEITZEL	06-T14-0017.0000	19.96
11	WEST VIRGINIA DEPARTMENT OF TRANSPORTATION, DIVISION OF HIGHWAYS	OLD C.R. 39	UNK
12	COLLEEN MARIE SOEHNLEIN, BETH ANN STEPHEN, CAROLINE LOUISE BOYD, JAMES C. BOYD, III, JENNIFER LEE BOYD AND THELMA JANECE BOYD	06-T14-0008.0000	14.25
13	CHRISTY M. BOPP	06-T14-0010.0000	55.66

TRACT	SURFACE OWNER	TAX PARCEL	ACRES
A	JOHN E. AND MARIMAR WEEKS	06-T19-0011.0000	114.544
В	CHARLES R. AND JUDITH ANN AUBER	12-4-7.7	29.72
С	CONSOLIDATION COAL COMPANY	12-4-3	5.60
D	WENDELL & LUELLA M. HANLIN	06-T19-0017.0001	4.57
Ε	JOHN E. & R S MCCORD	06-T19-0017.0002	1.298
F	WENDELL ET UX HANLIN	12-4-3.6	38.96
G	SUSAN E. OBERLE	06-T19-0003.0002	2.375
Н	SUSAN E. OBERLE	06-T19-0003.0001	1.00
1	JOHN E. BARTON	06-T19-0003.0007	4.00
J	JOHN E. BARTON	06-T19-0004.0006	4.895
К	JOHN E. BARTON	06-T19-0004.0001	5.008
- 1	LONDON C. STADLER, ERIC STADLER AND CHRISTOPHER M. STADLER	06-T19-0005.0001	2.00
М	JACK A. MITCHAM AND BERNICE A. MITCHAM	05-T14-0001.0012	96.72
N	WHEELING CREEK WATERSHED PROT	06-T14-0006.0000	251.16
0	CHARLES T. HOHMAN AND MARY SUSANNE HOHMAN (LIFE ESTATE); HEIDI SUE HOHMAN; JODIE KAY HOHMAN	05-T14-0007.0000	5.848
P	CHARLES THOMAS HOHMAN AND MARY SUSANNE HOHMAN (LIFE ESTATE); HEIDI SUE HOHMAN; JODIE KAY HOHMAN	06-T14-0010.0003	8.514
Q	JEFFREY O. AND ANN LUZADER	06-T14-0011.0008	21.168
R	JASON R. & HEATHER S. HINERMAN	D5-T14-D010.0002	1.47
5	JOHN E, BOPP JR. AND CHRISTY M, BOPP	D5-T14-D010.0004	5.302
T	LOIS K. HINERMAN	06-T14-0010.0005	2.768
U	KIRK D. AND JUDY L. LUZADER	06-T14-0011.0004	6.94
٧	BETH ANN STEPHEN ET AL	06-T14-D015.0000	42.449
W	DANA EUGENE & RITA JEAN CLOVIS	06-T14-0019.0000	5.23
X	JOHN E. & T M WEITZEL	06-T14-0009.0000	9.10
Y	JOHN M. WETZEL AND ANGELA L. WETZEL	06-T14-0009.0001	1,695
Z	JOHN E. & TRINA M. WEITZEL	06-T14-0017.0000	19.96
AA	MARK A. & AMY M. FOSTER	06-T14-0021.0001	87.28
AB	LG HICKMAN, JM HICKMAN, CL HICKMAN, CS HICKMAN	06-T14-0038.0000	143.77
AC	ERIN E. SCHUL	06-T14-0052.0005	7.256
AD	PATRICK R. & CLARA L. MOCZEK	06-T14-0052.0000	11.73
AE	MITCHELL J. ANTHONY	06-T19-0013.0001	6.06
AF	MARK F. & KATHLEEN A. LICHWA	05-T19-0019.0000	5.00
AG	MARK F. LICHWA	05-T19-0022.0000	5.00
АН	KATHLEEN A. LICHWA	06-T19-0024.0000	9.994
Al	HERBERT & A M SHARP	06-T19-D009.000D	101.56
AJ	LYNN E. & KELLEY S. MOORE	06-T19-D010.0000	4.833

12/08/2017

REVISIONS:	COMPANY:	SWN Production Company, LLC		
	OPERATOR'S WELL #:	ESTHER OHI 2		DATE: 11-29-2017  DRAWN BY: M.SNIDER
	DISTRICT: TRIADELPHIA	COUNTY: OHIO	STATE: WV	SCALE: N/A DRAWING NO: 2017-301 WELL LOCATION PLAT

WW-6A1 (5/13) Operator's Well No. Esther Weeks OHI 201H

### INFORMATION SUPPLIED UNDER WEST VIRGINIA CODE Chapter 22, Article 6A, Section 5(a)(5) IN LIEU OF FILING LEASE(S) AND OTHER CONTINUING CONTRACT(S)

Under the oath required to make the verification on page 1 of this Notice and Application, I depose and say that I am the person who signed the Notice and Application for the Applicant, and that —

- the tract of land is the same tract described in this Application, partly or wholly depicted in the accompanying plat, and described in the Construction and Reclamation Plan;
- (2) the parties and recordation data (if recorded) for lease(s) or other continuing contract(s) by which the Applicant claims the right to extract, produce or market the oil or gas are as follows:

Number	Grantor, Lessor, etc.	Grantee, Lessee, etc.	Royalty	Book/Page
--------	-----------------------	-----------------------	---------	-----------

See Exhibit

### Acknowledgement of Possible Permitting/Approval In Addition to the Office of Oil and Gas

The permit applicant for the proposed well work addressed in this application hereby acknowledges the possibility of the need for permits and/or approvals from local, state, or federal entities in addition to the DEP, Office of Oil and Gas, including but not limited to the following:

WV Division of Water and Waste Management

WV Division of Natural Resources WV Division of Highways

- U.S. Army Corps of Engineers
- U.S. Fish and Wildlife Service
- County Floodplain Coordinator

Office of Oil and Gas

SEP - 5 2017

WV Department of Environmental Protection

The applicant further acknowledges that any Office of Oil and Gas permit in no way overrides, replaces, or nullifies the need for other permits/approvals that may be necessary and further affirms that all needed permits/approvals should be acquired from the appropriate authority before the affected activity is initiated.

Well Operator:	SWN Production Company	
By:	N ST	
Its:	Staff Landman	

Page 1 of \_\_\_\_

							768/8
					Fortuna Energy, Inc. Range Resources-Appalachia, LLC		849/767 786/392
					Cherapeake Appalachia, LLC		820/657
1) 06-119-0012-0000	Karia J. Weeks	101.469	729274-000	Esther H. Weeks, a widow	SWN Production Company, LLC	12.50%	883/144
	The Sales Services			Kelth A. McCord and Nancy J. McCord, husband and	Chetapeake Appalachia, LLC.		815/544
2) 06-T19-0017-0000	Keith A. and Nancy J. McCard	23.194	729442-000	wife	SWN Production Company, LLC	18 00%	883/168
8) 06-T19-0004-0000	John E. Barton	0.716	734822-000	Robert M. Burgy, a wildower	Chesapeake Appalachia, LLC. SWN Production Company, LLC		858/675 884/385
08/119/0004-0000	John E, partien	0./16	7,3482,740,00	Rosemary Kahle Comstock, a widow	3W/W Production Company, LLC	18.00%	859/81
			734738-001	Melvin W. Kahle, Jr., and Carol M. Kahle, Husband and	Chasapeake Appalachia, LLC.		859/85
() 06-719-0004-0002	James S. Haught	4.840	734739-001	Wife	SWN Production Company, LLC	18 00%	884/289
				Stephen D. Shields and Patrida L. Shields, husband and			812/624
			731481-000	wife			859/81
				Rosemary Kahle Comstock, a widow			B59/B5
5) 06-119-0004-0004	transferrations.	5.220	734738-001 734739-001	Melvin W. Kahle, Jr., and Carol M. Kahle, Husband and Wife		18.00%	854/289
06-119-0004-0004	James S. Haught	5.770	714/19-001		SWN Production Company, LLC	18.00%	884/253
			734738-001	Rosemary Kahle Comstock, a widow Melvin W. Kahle, Jr., and Carol M. Kahle, Husband and	Chesapeake Appalachia LLC		859/81 859/85
5) 06-719-0004-0003	Michael Todd and Roberts Mariene Elutter	5,420	784739-001	Wife	SWN Production Company, LLC	18.00%	884/289
					Great Lakes Energy Partners, LLC.		768/505
				Mitchell R. Holmes and Patricia A. Holmes, hosband	Chesapeake Appalachia, LLC.		808/434
7) 06-719-0005-0000	Mitchell R, and Patricla A. Holmes	60.000	730203-000	and wife	SWN Production Company, LLC	15.50%	883/204
					Fortuna Energy, Inc.		767/158
					Range Resources - Appalachia, LLC		786/372
06-T19-0006-0000	John E. and Markmar Weeks	262.044	729275-000	John E. Weeks and Marimar Weeks, husband and wife	Chesapeake Appalachia, LLC SWN Production Company LLC	12,50%	820/657 883/144
					Chevron U.S.A., Inc.		827/254
	Wheeling Creek Watershed Protection and Floor	1		Wheeling Creek Watershed Protection and Flood	Chesapeake Appalachia, L.L.C.		867/713
6 06-T14-0005-0001	Prevention Commission	2.000	734035-009	Preventian Commission	SWN Production Company, LLC	18.75%	885/308
	and the second second				Chesapeake Appalachia, L.L.C.		816/203
(0) 06-T14-0017-0000	John E. and Trina M. Welszel	19.950	731579-000	John E. Weitzel and Trina M. Weitzel, husband and wife		18,00%	B84/265
1) Old CR 39	West Virginia Department of Transportation, Division of Highways	Uninows.	734707-000	West Virginia Department of Transportation, Division of Highways	Chesapeake Appalachia, L.L.C. SWN Production Company, LLC	18.00%	BS7/213 BS4/289
			700000				
			725116-001	Beth Stephen Martin, a married woman dealing in her			
			725116-002	sole and separate property Colleen Soehnlein, a married woman dealing in her			791/404
			723210-001	sole and separate property			792/6
			725116-003	Jennifer Boyd, a single woman			792/11
	and the second second second		725116-004	James C. Boyd, III, a married man dealing in his sole			792/16
	Colleen Marie Scehnisin, Bath Ann Stephen, Caroline Louise Boyd, James C. Boyd, III, Jenniter		725116-005	and separate property	Character Associates 4 to 6		797/203
12) D5-T14-0008-0000	Lee Boyd and Theims Janece Boyd	14.250	725134-001	Thelma Boyd, a single woman Caroline Boyd, a single woman	Chesapeake Appalachia, L.L.C. SWN Production Company, ILC	17.50%	885/500 885/512
(3) D6-T14-D010-D000	Christy M. Bopp	55.660	725386-000	Christy M. Bopp, a single woman	SWN Production Company, LLC	12,50%	885/512
T)							
2							
5.5							
- 53	50						
30	The state of						
0.0	- 8 -						
20	, 0,2						
75	300						
En Woonmental Protection	Office of Oil and Gas SEP - 5 2017						
5.3	N AZ						
80	0 20						
# 5	7 40						
0	(1)						
5	(D)						



SWN Production Company, LLC P O Box 12359 Spring, Texas 77391-2359 www.swn.com

August 25, 2017

Ms. Laura Adkins WV DEP Office of Oil & Gas 601 57<sup>th</sup> St., SE Charleston, WV 25304

RE: SWN's proposed New Well: Esther Weeks OHI 201H Ohio County, West Virginia, Drilling under Old C.R. 39 and Oklahoma Road.

Dear Ms. Adkins:

SWN Production Company, LLC ("SWN") is applying for a drilling permit for the above referenced well. The State of West Virginia has raised some concern as to SWN's right to drill under Old C.R. 39 and Oklahoma Road. Please be advised that SWN has leased all mineral owners under said route as it relates to the above-referenced well and unit.

Thank you.

Sincerely,

Robert Walter Staff Landman

SWN Production Company, LLC

PO Box 12359

Spring, TX 77391-2359

Office of Oil and Gas

SEP - 5 2017

WW Department of Environmental Protection

R2 NV+°

### STATE OF WEST VIRGINIA DEPARTMENT OF ENVIRONMENTAL PROTECTION, OFFICE OF OIL AND GAS NOTICE CERTIFICATION

Date of Notic	ce Certification: 5/3/1		API No. 4	7- 069 -	
	- commence - planti				er Weeks OHI 201H
				Name: Esther	
Notice has l	oeen given:				
	ie provisions in West Virginia Code §	§ 22-6A, the Operator has prov	ided the rec	uired parties v	with the Notice Forms listed
	tract of land as follows:	•			
State:	West Virginia	UTM NAD 83	Easting:	538180.29	
County:	069-Ohio	OTM NAD 85	Northing:	4430673.39	
District:	Triadelphia	Public Road Acce		Oklahoma Road	
Quadrangle:	Valley Grove	Generally used far	rm name:	Esther Weeks	
Watershed:	Upper Ohio South				
requirements Virginia Codo of this article	surface owner notice of entry to su of subsection (b), section sixteen of a § 22-6A-11(b), the applicant shall thave been completed by the applicant west Virginia Code § 22-6A, the Op	f this article were waived in ender proof of and certify to that.	writing by e secretary	the surface ov that the notice	vner; and Pursuant to Wes
	rator has properly served the require				OOG OFFICE USE
*PLEASE CHI	ECK ALL THAT APPLY				ONLY
☐ 1. NO	TICE OF SEISMIC ACTIVITY or	☐ NOTICE NOT REQUIR SEISMIC ACTIVITY WAS			RECEIVED/ NOT REQUIRED
☐ 2. NO	TICE OF ENTRY FOR PLAT SURV	/EY or 🔳 NO PLAT SURVE	Y WAS C	ONDUCTED	☐ RECEIVED
■ 3. NO	TICE OF INTENT TO DRILL or	NOTICE NOT REQUIR NOTICE OF ENTRY FOR P			RECEIVED/ NOT REQUIRED
		☐ WRITTEN WAIVER B (PLEASE ATTACH)	SY SURFA	CE OWNER	
■ 4. NO	TICE OF PLANNED OPERATION		Offi	RECEIVED se of Oil and G	RECEIVED
☑ 5. PUI	BLIC NOTICE		SE	P - 5 2017	RECEIVED
☐ 6. NO	TICE OF APPLICATION		Environ	Department of	RECEIVED

### Required Attachments:

The Operator shall attach to this Notice Certification Form all Notice Forms and Certifications of Notice that have been provided to the required parties and/or any associated written waivers. For the Public Notice, the operator shall attach a copy of the Class II Legal Advertisement with publication date verification or the associated Affidavit of Publication. The attached Notice Forms and Certifications of Notice shall serve as proof that the required parties have been noticed as required under West Virginia Code § 22-6A. Pursuant to West Virginia Code § 22-6A-11(b), the Certification of Notice to the person may be made by affidavit of personal service, the return receipt eard or other postal receipt for certified mailing.

, have read and understand the notice requirements within West Virginia Code § 22-

THEREFORE, I

### Certification of Notice is hereby given:

6A. I certify tha	at as required i	under West Virg	inia Code § 22-6A, I have so	erved the attached copies of the Notice Forms, identified
above, to the re	equired parties	through persona	al service, by registered mail	or by any method of delivery that requires a receipt or
				examined and am familiar with the information submitted
				nquiry of those individuals immediately responsible for
				d complete. I am aware that there are significant penalties
for submitting fa	alse informatio	n, including the p	possibility of fine and impriso	nment.
200 2012 17 17				
Well Operator:	SWN Production	n Co., LC	Address:	P.O. Box 1300
By:	Dee Southall			Jane Lew, WV 26378
Its:	Regulatory Sup	ervisor	Facsimile:	
Telephone:	304-884-1614		Email:	Dee_Southall@swn.com
		SEAL OFFICIAL SEAI lary Public, State of We BRITTANY R WC 3302 Old Elkins R Buckhannon, WV 2 commission expires Novem	DODY BUTTONY	orn before me this 1th day of 11111111111111111111111111111111111
Conse	11.77.2		I WIVE COMMISSION DZ	pires

### Oil and Gas Privacy Notice:

The Office of Oil and Gas processes your personal information, such as name, address and telephone number, as part of our regulatory duties. Your personal information may be disclosed to other State agencies or third parties in the normal course of business or as needed to comply with statutory or regulatory requirements, including Freedom of Information Act requests. Our office will appropriately secure your personal information. If you have any questions about our use or your personal information, please contact DEP's Chief Privacy Officer at <a href="mailto:deprivacyofficer@wv.gov">deprivacyofficer@wv.gov</a>.

Notice Time Requirement: notice shall be provided no later than the filing date of permit application.

API NO. 47- 069 OPERATOR WELL NO. Esther Weeks OHI 201H
Well Pad Name: Esther Weeks OHI Pad

### STATE OF WEST VIRGINIA DEPARTMENT OF ENVIRONMENTAL PROTECTION, OFFICE OF OIL AND GAS $\underline{\text{NOTICE OF APPLICATION}}$

Date of Notice: Date Permit Application F	Filed: 8 35 17	
	E OF APPROVAL FOR THE ION OF AN IMPOUNDMENT OR PIT	
Delivery method pursuant to West Virginia Code §	22-6A-10(b)	
□ PERSONAL ☑ REGISTERED □ SERVICE MAIL	METHOD OF DELIVERY THAT REQUIRES A RECEIPT OR SIGNATURE CONFIRMATION	
registered mail or by any method of delivery that requires sediment control plan required by section seven of this art the surface of the tract on which the well is or is proposed oil and gas leasehold being developed by the proposed we described in the erosion and sediment control plan submit operator or lessee, in the event the tract of land on which the more coal seams; (4) The owners of record of the surface well work, if the surface tract is to be used for the placement impoundment or pit as described in section nine of this art have a water well, spring or water supply source located we provide water for consumption by humans or domestic and proposed well work activity is to take place. (c)(1) If more subsection (b) of this section hold interests in the lands, the records of the sheriff required to be maintained pursuant to provision of this article to the contrary, notice to a lien hold Code R. § 35-8-5.7.a requires, in part, that the operator slip water purveyor or surface owner subject to notice and water purveyor or surface owner subject to notice	ment or pit as required by this article shall deliver, by personal a receipt or signature confirmation, copies of the application, the ficle, and the well plat to each of the following persons: (1) The it to be located; (2) The owners of record of the surface tract or the located; (2) The owners of record of the surface tract or the located; (3) The surface tract is to be used for roads or other land the ted pursuant to subsection (c), section seven of this article; (3) The well proposed to be drilled is located [sic] is known to be used tract or tracts overlying the oil and gas leasehold being developent, construction, enlargement, alteration, repair, removal or absticle; (5) Any surface owner or water purveyor who is known to within one thousand five hundred feet of the center of the well primals; and (6) The operator of any natural gas storage field with the than three tenants in common or other co-owners of interests of the applicant may serve the documents required upon the person of section eight, article one, chapter eleven-a of this code. (2) Noted is not notice to a landowner, unless the lien holder is the land hall also provide the Well Site Safety Plan ("WSSP") to the surface testing as provided in section 15 of this rule.	ne erosion and owners of record of racts overlying the disturbance as The coal owner, inderlain by one or ed by the proposed andonment of any the applicant to ad which is used to alin which the described in described in the otwithstanding any indowner. W. Va.
☑ SURFACE OWNER(s)	COAL OWNER OR LESSEE	
Name: Karla J. Weeks	Name: Alliance Resources GP, LLC	
Address: 12045 Heather Down Dr.		
A COLOR CONTROL CONTRO	Address: 2596 Battle Run Road	
Herndon , VA 20170	Address: 2596 Battle Run Road Triadelhpia, WV 26059	-
Name:	Triadelhpia, WV 26059  ☐ COAL OPERATOR Name:	
Name:Address:	Triadelhpia, WV 26059  COAL OPERATOR  Name: Address:	Office of Olived
Name: Address: □ SURFACE OWNER(s) (Road and/or Other Disturba	Triadelhpia, WV 26059  COAL OPERATOR  Name:  Address:	Office of Oil and Gas
Name: Address:  ☐ SURFACE OWNER(s) (Road and/or Other Disturba Name:	Triadelhpia, WV 26059  COAL OPERATOR Name: Address:  COAL OPERATOR Name: Address:	Office of Oil and Gas
Name: Address:  ☐ SURFACE OWNER(s) (Road and/or Other Disturba Name:	Triadelhpia, WV 26059  COAL OPERATOR Name: Address:  Ince)  SURFACE OWNER OF WATER WELL AND/OR WATER PURVEYOR(s)	SEP - 5 2017
Name:	Triadelhpia, WV 26059  COAL OPERATOR Name: Address:  COAL OPERATOR Name: Address:  COAL OPERATOR Name: Address:  COAL OPERATOR Name: None	SEP - 5 2017
SURFACE OWNER(s) (Road and/or Other Disturba Name: Address: Name:	Triadelhpia, WV 26059  COAL OPERATOR Name: Address:  Ince)  SURFACE OWNER OF WATER WELL AND/OR WATER PURVEYOR(s)	Office of Oil and Gas
Name:	Triadelhpia, WV 26059  COAL OPERATOR Name: Address:  COAL OPERATOR Name: Address:  COAL OPERATOR Name: Address:  COAL OPERATOR Name: Address:	SEP - 5 2017  WW Department of Environmental Protection
Name: Address:  SURFACE OWNER(s) (Road and/or Other Disturba Name: Address:  Name: Address:	Triadelhpia, WV 26059  COAL OPERATOR Name: Address:  SURFACE OWNER OF WATER WELL AND/OR WATER PURVEYOR(s) Name: None Address:	SEP - 5 2017  WV Department of Environmental Protection  RAGE FIELD
Name: Address:  SURFACE OWNER(s) (Road and/or Other Disturba Name: Address:  Name: Address:  SURFACE OWNER(s) (Impoundments or Pits)	Triadelhpia, WV 26059  COAL OPERATOR Name: Address:  SURFACE OWNER OF WATER WELL AND/OR WATER PURVEYOR(s) Name: None Address:  OPERATOR OF ANY NATURAL GAS STOR	SEP - 5 2017  WV Department of Environmental Protection  RAGE FIELD
Name: Address:  SURFACE OWNER(s) (Road and/or Other Disturba Name: Address:  Name: Address:	Triadelhpia, WV 26059  COAL OPERATOR Name: Address:  SURFACE OWNER OF WATER WELL AND/OR WATER PURVEYOR(s) Name: None Address:	SEP - 5 2017  WV Department of Environmental Protection  RAGE FIELD

WW-6A (9-13) API NO. 47- 069 OPERATOR WELL NO. Esther Weeks OHI 20111
Well Pad Name: Esther Weeks OHI Pad

### STATE OF WEST VIRGINIA DEPARTMENT OF ENVIRONMENTAL PROTECTION, OFFICE OF OIL AND GAS NOTICE OF APPLICATION

Not	ice Time Requirement: notice shall be provide	d no later than the filing date of permit application.	
	e of Notice: Date Permit Application	n Filed: \$\\\3\\\\\\\\\\\\\\\\\\\\\\\\\\\\\\\\\	
<b>V</b>		TTE OF APPROVAL FOR THE CTION OF AN IMPOUNDMENT OR PIT	
Deli	very method pursuant to West Virginia Cod	§ 22-6A-10(b)	
	PERSONAL  REGISTERED	☐ METHOD OF DELIVERY THAT REQUIRES A	
	SERVICE MAIL	RECEIPT OR SIGNATURE CONFIRMATION	
regis sedin the soil a description of the soil and descrip	stered mail or by any method of delivery that requirement control plan required by section seven of this purface of the tract on which the well is or is proported as leasehold being developed by the proposed ribed in the erosion and sediment control plan substant or lessee, in the event the tract of land on whe e coal seams; (4) The owners of record of the surface work, if the surface tract is to be used for the plan and the water well, spring or water supply source located water for consumption by humans or domestic osed well work activity is to take place. (c)(1) If the ection (b) of this section hold interests in the land rods of the sheriff required to be maintained pursualision of this article to the contrary, notice to a lieue R. § 35-8-5.7.a requires, in part, that the operation	andment or pit as required by this article shall deliver, by personal stress a receipt or signature confirmation, copies of the application, the article, and the well plat to each of the following persons: (1) The sed to be located; (2) The owners of record of the surface tract or the well work, if the surface tract is to be used for roads or other land an interest pursuant to subsection (c), section seven of this article; (3) The the well proposed to be drilled is located [sie] is known to be under tract or tracts overlying the oil and gas leasehold being development, construction, enlargement, alteration, repair, removal or above article; (5) Any surface owner or water purveyor who is known to diviting one thousand five hundred feet of the center of the well planning; and (6) The operator of any natural gas storage field with sore than three tenants in common or other co-owners of interests of the applicant may serve the documents required upon the personant to section eight, article one, chapter eleven-a of this code. (2) No holder is not notice to a landowner, unless the lien holder is the lar shall also provide the Well Site Safety Plan ("WSSP") to the surface testing as provided in section 15 of this rule.	the erosion and cowners of record of cracts overlying the disturbance as The coal owner, anderlain by one or ed by the proposed andonment of any the applicant to ad which is used to in which the described in described in the otwithstanding any andowner. W. Va.
☑ A	application Notice	Plan Notice	
	JRFACE OWNER(s)	☐ COAL OWNER OR LESSEE Name: Alliance Resources GP, LLC	
Nam	ress:	Address: 2596 Battle Run Road	
Add	ress:	Triadelhpia, WV 26059	3
Nan	no.	COAL OPERATOR	Office OF ON and Ga
			Office OF ECEIVED
Add	ress:	Name:Address:	SEP - 5 2017
	merce oundendary to the out of the		SEP GE
	JRFACE OWNER(s) (Road and/or Other Distr		3 2017
Nan	ne:	☑ SURFACE OWNER OF WATER WELL	Environmental Protection
Add	ress:	AND/OR WATER PURVEYOR(s)	mental pent of
-		Name: NONE	Totection
Nan	ne:	Address:	
Add	ress:		
_	Contact to Search School Contact to School Conta	OPERATOR OF ANY NATURAL GAS STOR	
_	JRFACE OWNER(s) (Impoundments or Pits)	Name:	
Nan	ne:	Address:	
Add	ress:		
		*Please attach additional forms if necessary	

API NO. 47- 069 OPERATOR WELL NO. Esther Wooks OHI 201H
Well Pad Name: Esther Weeks OHI Pad

### STATE OF WEST VIRGINIA DEPARTMENT OF ENVIRONMENTAL PROTECTION, OFFICE OF OIL AND GAS NOTICE OF APPLICATION

Notice Time Requir	ement: notice shall be provid	ed no later than the filing date of permit application.
Date of Notice:	Date Permit Applicati	on Filed: 131117
PERMIT FOR A	ANY D CERTIFIC	ATE OF APPROVAL FOR THE
WELL WORK		JCTION OF AN IMPOUNDMENT OR PIT
Delivery method pu	rsuant to West Virginia Coo	le § 22-6A-10(b)
☐ PERSONAL	☑ REGISTERED	☐ METHOD OF DELIVERY THAT REQUIRES A
SERVICE	MAIL	RECEIPT OR SIGNATURE CONFIRMATION
registered mail or by a sediment control plan the surface of the tract oil and gas leasehold be described in the erosio operator or lessee, in the more coal seams; (4) The well work, if the surfaci impoundment or pit as have a water well, spriprovide water for consproposed well work as subsection (b) of this streeords of the sheriff in provision of this article Code R. § 35-8-5.7.a.	ny method of delivery that required by section seven of the on which the well is or is proposed in and sediment control plan such event the tract of land on which event the tract of land on which event the tract of land on which event is to be used for the plan described in section nine of the ng or water supply source local umption by humans or domesticativity is to take place. (c)(1) If the section hold interests in the land equired to be maintained pursue to the contrary, notice to a lie requires, in part, that the operation	sundment or pit as required by this article shall deliver, by personal service or by ires a receipt or signature confirmation, copies of the application, the erosion and is article, and the well plat to each of the following persons: (1) The owners of record of cosed to be located; (2) The owners of record of the surface tract or tracts overlying the divided well work, if the surface tract is to be used for roads or other land disturbance as somitted pursuant to subsection (c), section seven of this article; (3) The coal owner, ich the well proposed to be drilled is located [sic] is known to be underlain by one or face tract or tracts overlying the oil and gas leasehold being developed by the proposed cement, construction, enlargement, alteration, repair, removal or abandonment of any is article; (5) Any surface owner or water purveyor who is known to the applicant to ed within one thousand five hundred feet of the center of the well pad which is used to be animals; and (6) The operator of any natural gas storage field within which the more than three tenants in common or other co-owners of interests described in less, the applicant may serve the documents required upon the person described in the lant to section eight, article one, chapter eleven-a of this code. (2) Notwithstanding any in holder is not notice to a landowner, unless the lien holder is the landowner. W. Va. or shall also provide the Well Site Safety Plan ("WSSP") to the surface owner and any water testing as provided in section 15 of this rule.
☐ Application Notice	e 🛮 WSSP Notice 🔟 E&S	Plan Notice
☐ SURFACE OWNE	R(s)	☐ COAL OWNER OR LESSEE
Name:		Name: Murray American Energy, INC:
Address:		Address: 6126 Energy Road
		Moundsville, WV 26041
		☐ COAL OPERATOR
Address:		Name:
		Address:
□ SURFACE OWNE	R(s) (Road and/or Other Distr	Name:  Address:  SEP  SURFACE OWNER OF WATER WELL  AND/OR WATER PURVEYOR(s)  Name:  SEP  SEP  SEP  SENWIND Dense  SENWIND Dense
Name:		□ SURFACE OWNER OF WATER WELL
		AND/OR WATER PURVEYOR(s)
		Name:
Name:		Address:
Address:		AND/OR WATER PURVEYOR(s)  Name:  Address:  DOPERATOR OF ANY NATURAL GAS STORAGE FIELD
		□ OPERATOR OF ANY NATURAL GAS STORAGE FIELD
I SURFACE OWNE	R(s) (Impoundments or Pits)	
		Name:Address:
Address:	778 77 77 10 10	Auditess.
Address.		*Diagra attack additional farms if response
-		*Please attach additional forms if necessary

WW-6A (8-13)

SEP - 5 2017

API NO. 47- 069 OPERATOR WELL NO. Esther Weeks OHI 201H

Well Pad Name: Esther Weeks OH Pad

#### WV Department of Environmental Protection

Notice is hereby given:

Pursuant to West Virginia Code § 22-6A-10(b), notice is hereby given that the undersigned well operator has applied for a permit for well work or for a certificate of approval for the construction of an impoundment or pit.

#### This Notice Shall Include:

Pursuant to W. Va. Code § 22-6A-10(b), this notice shall include: (1) copies of the application; (2) the erosion and sediment control plan required by section seven of this article; and (3) the well plat.

Pursuant to W. Va. Code § 22-6A-10(f), this notice shall include: (1) a statement of the time limits for filing written comments; (2) who may file written comments; (3) the name and address of the secretary for the purpose of filing the comments and obtaining additional information; and (4) a statement that the persons may request, at the time of submitting written comments, notice of the permit decision and a list of persons qualified to test water.

Pursuant to W. Va. Code R. § 35-8-5.7.a, the operator shall provide the Well Site Safety Plan to the surface owner and any water purveyor or surface owner subject to notice and water testing as provided in section 15 of this rule.

Pursuant to W. Va. Code R. § 35-8-15.2.c, this notice shall: (1) contain a statement of the surface owner's and water purveyor's right to request sampling and analysis; (2) advise the surface owner and water purveyor of the rebuttable presumption for contamination or deprivation of a fresh water source or supply; advise the surface owner and water purveyor that refusal to allow the operator to conduct a pre-drilling water well test constitutes a method to rebut the presumption of liability; (3) advise the surface owner and water purveyor of his or her independent right to sample and analyze any water supply at his or her own expense; advise the surface owner and water purveyor whether or not the operator will utilize an independent laboratory to analyze any sample; and (4) advise the surface owner and or water purveyor that he or she can obtain from the Chief a list of water testing laboratories in the subject area capable of and qualified to test water supplies in accordance with standard acceptable methods.

Additional information related to horizontal drilling may be obtained from the Secretary, at the WV Department of Environmental Protection headquarters, located at 601 57<sup>th</sup> Street, SE, Charleston, WV 25304 (304-926-0450) or by visiting <a href="https://www.dep.wv.gov/oil-and-gas/pages/default.aspx">www.dep.wv.gov/oil-and-gas/pages/default.aspx</a>.

### Well Location Restrictions

Pursuant to W. Va. Code § 22-6A-12. Wells may not be drilled within two hundred fifty feet measured horizontally from any existing water well or developed spring used for human or domestic animal consumption. The center of well pads may not be located within six hundred twenty-five feet of an occupied dwelling structure, or a building two thousand five hundred square feet or larger used to house or shelter dairy cattle or poultry husbandry. This limitation is applicable to those wells, developed springs, dwellings or agricultural buildings that existed on the date a notice to the surface owner of planned entry for surveying or staking as provided in section ten of this article or a notice of intent to drill a horizontal well as provided in subsection (b), section sixteen of this article was provided, whichever occurs first, and to any dwelling under construction prior to that date. This limitation may be waived by written consent of the surface owner transmitted to the department and recorded in the real property records maintained by the clerk of the county commission for the county in which such property is located. Furthermore, the well operator may be granted a variance by the secretary from these distance restrictions upon submission of a plan which identifies the sufficient measures, facilities or practices to be employed during well site construction, drilling and operations. The variance, if granted, shall include terms and conditions the department requires to ensure the safety and protection of affected persons and property. The terms and conditions may include insurance, bonding and indemnification, as well as technical requirements. (b) No well pad may be prepared or well drilled within one hundred feet measured horizontally from any perennial stream, natural or artificial lake, pond or reservoir, or a wetland, or within three hundred feet of a naturally reproducing trout stream. No well pad may be located within one thousand feet of a surface or ground water intake of a public water supply. The distance from the public water supply as identified by the department shall be measured as follows: (1) For a surface water intake on a lake or reservoir, the distance shall be measured from the boundary of the lake or reservoir. (2) For a surface water intake on a flowing stream, the distance shall be measured from a semicircular radius extending upstream of the surface water intake. (3) For a groundwater source, the distance shall be measured from the wellhead or spring. The department may, in its discretion, waive these distance restrictions upon submission of a plan identifying sufficient measures, facilities or practices to be employed during well site construction, drilling and operations to protect the waters of the state. A waiver, if granted, shall impose any permit conditions as the secretary considers necessary. (c) Notwithstanding the foregoing provisions of this section, nothing contained in this section prevents an operator from conducting the activities permitted or authorized by a Clean Water Act Section 404 permit or other approval from the United States Army Corps of Engineers within any waters of the state or within the restricted areas referenced in this section. (d) The well location restrictions set forth in this section shall not apply to any well on a multiple well pad if at least one of the wells was permitted prior to the effective date of this article. (e) The secretary shall, by December 31, 2012, report to the Legislature on the noise, light, dust and volatile organic compounds generated by the drilling of horizontal wells as they relate to the well location restrictions regarding occupied dwelling structures pursuant to this section. Upon a finding, if any, by the secretary that the well location restrictions regarding occupied dwelling structures are inadequate or otherwise require alteration to address the items

WW-6A (8-13)

API NO. 47-069

OPERATOR WELL NO. Esther Weeks OHI 201H

Well Pad Name: Esther Weeks OHI Pad

examined in the study required by this subsection, the secretary shall have the authority to propose for promulgation legislative rules establishing guidelines and procedures regarding reasonable levels of noise, light, dust and volatile organic compounds relating to drilling horizontal wells, including reasonable means of mitigating such factors, if necessary.

### Water Well Testing:

Pursuant to West Virginia Code § 22-6A-10(d), notification shall be made, with respect to surface landowners identified in subsection (b) or water purveyors identified in subdivision (5), subsection (b) of this section, of the opportunity for testing their water well. The operator shall provide an analysis to such surface landowner or water purveyor at their request.

### Water Testing Laboratories:

Pursuant to West Virginia Code § 22-6A-10(i), persons entitled to notice pursuant to subsection (b) of this section may contact the department to ascertain the names and locations of water testing laboratories in the subject area capable and qualified to test water supplies in accordance with standard accepted methods. In compiling that list of names the department shall consult with the state Bureau for Public Health and local health departments. A surface owner and water purveyor has an independent right to sample and analyze any water supply at his or her own expense. The laboratory utilized by the operator shall be approved by the agency as being certified and capable of performing sample analyses in accordance with this section.

### Rebuttable Presumption for Contamination or Deprivation of a Fresh Water Source or Supply:

W. Va. Code § 22-6A-18 requires that (b) unless rebutted by one of the defenses established in subsection (c) of this section, in any action for contamination or deprivation of a fresh water source or supply within one thousand five hundred feet of the center of the well pad for horizontal well, there is a rebuttable presumption that the drilling and the oil or gas well or either was the proximate cause of the contamination or deprivation of the fresh water source or supply. (c) In order to rebut the presumption of liability established in subsection (b) of this section, the operator must prove by a preponderance of the evidence one of the following defenses: (1) The pollution existed prior to the drilling or alteration activity as determined by a predrilling or prealteration water well test. (2) The landowner or water purveyor refused to allow the operator access to the property to conduct a predrilling or prealteration water well test. (3) The water supply is not within one thousand five hundred feet of the well. (4) The pollution occurred more than six months after completion of drilling or alteration activities. (5) The pollution occurred as the result of some cause other than the drilling or alteration activity. (d) Any operator electing to preserve its defenses under subdivision (1), subsection (c) of this section shall retain the services of an independent certified laboratory to conduct the predrilling or prealteration water well test. A copy of the results of the test shall be submitted to the department and the surface owner or water purveyor in a manner prescribed by the secretary. (e) Any operator shall replace the water supply of an owner of interest in real property who obtains all or part of that owner's supply of water for domestic, agricultural, industrial or other legitimate use from an underground or surface source with a comparable water supply where the secretary determines that the water supply has been affected by contamination, diminution or interruption proximately caused by the oil or gas operation, unless waived in writing by that owner. (f) The secretary may order the operator conducting the oil or gas operation to: (1) Provide an emergency drinking water supply within twenty-four hours; (2) Provide temporary water supply within seventy-two hours; (3) Within thirty days begin activities to establish a permanent water supply or submit a proposal to the secretary outlining the measures and timetables to be used in establishing a permanent supply. The total time in providing a permanent water supply may not exceed two years. If the operator demonstrates that providing a permanent replacement water supply cannot be completed within two years, the secretary may extend the time frame on case-by-case basis; and (4) Pay all reasonable costs incurred by the real property owner in securing a water supply. (g) A person as described in subsection (b) of this section aggrieved under the provisions of subsections (b), (e) or (f) of this section may seek relief in court... (i) Notwithstanding the denial of the operator of responsibility for the damage to the real property owner's water supply or the status of any appeal on determination of liability for the damage to the real property owner's water supply, the operator may not discontinue providing the required water service until authorized to do so by the secretary or a court of competent jurisdiction.

### Written Comment:

Pursuant to West Virginia Code § 22-6A-11(a), all persons described in subsection (b), section ten of this article may file written comments with the secretary as to the location or construction of the applicant's proposed well work within thirty days after the application is filed with the secretary. All persons described in West Virginia Code § 22-6A-10(b) may file writter permanents as to the location or construction of the applicant's proposed well work to the Secretary at:

SFD

SFD

Gas

Chief, Office of Oil and Gas
Department of Environmental Protection
601 57<sup>th</sup> St. SE
Charleston, WV 25304
(304) 926-0450

Such persons may request, at the time of submitting written comments, notice of the permit decision and a list of persons qualified to test water. NOTE: YOU ARE NOT REQUIRED TO FILE ANY COMMENT.

Environmental Protection

WW-6A (8-13)

API NO. 47-069

OPERATOR WELL NO. Esther Weeks OH (201H

Well Pad Name: Esther Weeks OHI Pad

### Time Limits and Methods for Filing Comments.

The law requires these materials to be served on or before the date the operator files its Application. You have THIRTY (30) DAYS after the filing date to file your comments. Comments must be filed in person or received in the mail by the Chief's office by the time stated above. You may call the Chief's office to be sure of the date. Check with your postmaster to ensure adequate delivery time or to arrange special expedited handling. If you have been contacted by the well operator and you have signed a "voluntary statement of no objection" to the planned work described in these materials, then the permit may be issued at any time.

Pursuant to West Virginia Code § 22-6A-11(c)(2), Any objections of the affected coal operators and coal seam owners and lessees shall be addressed through the processes and procedures that exist under sections fifteen, seventeen and forty, article six of this chapter, as applicable and as incorporated into this article by section five of this article. The written comments filed by the parties entitled to notice under subdivisions (1), (2), (4), (5) and (6), subsection (b), section ten of this article shall be considered by the secretary in the permit issuance process, but the parties are not entitled to participate in the processes and proceedings that exist under sections fifteen, seventeen or forty, article six of this chapter, as applicable and as incorporated into this article by section five of this article.

### **Comment Requirements**

Your comments must be in writing and include your name, address and telephone number, the well operator's name and well number and the approximate location of the proposed well site including district and county from the application. You may add other documents, such as sketches, maps or photographs to support your comments.

Disclaimer: All comments received will be placed on our web site <a href="http://www.dep.wv.gov/oil-and-gas/Horizontal-Permits/Pages/default.aspx">http://www.dep.wv.gov/oil-and-gas/Horizontal-Permits/Pages/default.aspx</a> and the applicant will automatically be forwarded an email notice that such comments have been submitted. The applicant will be expected to provide a response to comments submitted by any surface owner, water purveyor or natural gas storage operator noticed within the application.

#### Permit Denial or Condition

The Chief has the power to deny or condition a well work permit. Pursuant to West Virginia Code § 22-6A-8(d), the permit may not be issued or be conditioned, including conditions with respect to the location of the well and access roads prior to issuance if the director determines that:

- (1) The proposed well work will constitute a hazard to the safety of persons;
- (2) The plan for soil erosion and sediment control is not adequate or effective;
- (3) Damage would occur to publicly owned lands or resources; or
- (4) The proposed well work fails to protect fresh water sources or supplies.

A permit may also be denied under West Virginia Code § 22-6A-7(k), the secretary shall deny the issuance of a permit if the secretary determines that the applicant has committed a substantial violation of a previously issued permit for a horizontal well, including the applicable erosion and sediment control plan associated with the previously issued permit, or a substantial violation of one or more of the rules promulgated under this article, and in each instance has failed to abate or seek review of the violation within the time prescribed by the secretary pursuant to the provisions of subdivisions (1) and (2), subsection (a), section five of this article and the rules promulgated hereunder, which time may not be unreasonable.

Pursuant to West Virginia Code § 22-6A-10(g), any person entitled to submit written comments to the secretary pursuant to subsection (a), section eleven of this article, shall also be entitled to receive from the secretary a copy of the permit as issued or a copy of the order modifying or denying the permit if the person requests receipt of them as a part of the written comments submitted concerning the permit application. Such persons may request, at the time of submitting written comments, notice of the permit decision and a list of persons qualified to test water.



WW-6A (8-13)

API NO. 47-069 OPERATOR WELL NO. Esther Weeks OHI 201H
Well Pad Name: Esther Weeks OHI Pad

day of ()

Notice is hereby given by:

Well Operator: SWN Production Co., LLC

Telephone: 304-884-1614

Email: Dee\_Southall@swn.com

Address: P.O. Box 1300 Jane Lew, WV 26378

Facsimile:

### Oil and Gas Privacy Notice:

The Office of Oil and Gas processes your personal information, such as name, address and telephone number, as part of our regulatory duties. Your personal information may be disclosed to other State agencies or third parties in the normal course of business or as needed to comply with statutory or regulatory requirements, including Freedom of Information Act requests. Our office will appropriately secure your personal information. If you have any questions about our use or your personal information, please contact DEP's Chief Privacy Officer at <a href="mailto:deprivacyofficer@wv.gov">deprivacyofficer@wv.gov</a>.

OFFICIAL SEAL
Notary Public, State of West Virginia
BRITTANY R WOODY
- 3302 Old Elkins Road
Buckhannon, WV 26201
My commission expires November 27, 2022

Subscribed and sworn before me this


Notary Public

My Commission Expires


Office of Oil and Gas

SEP - 5 2017

Environmental Protection

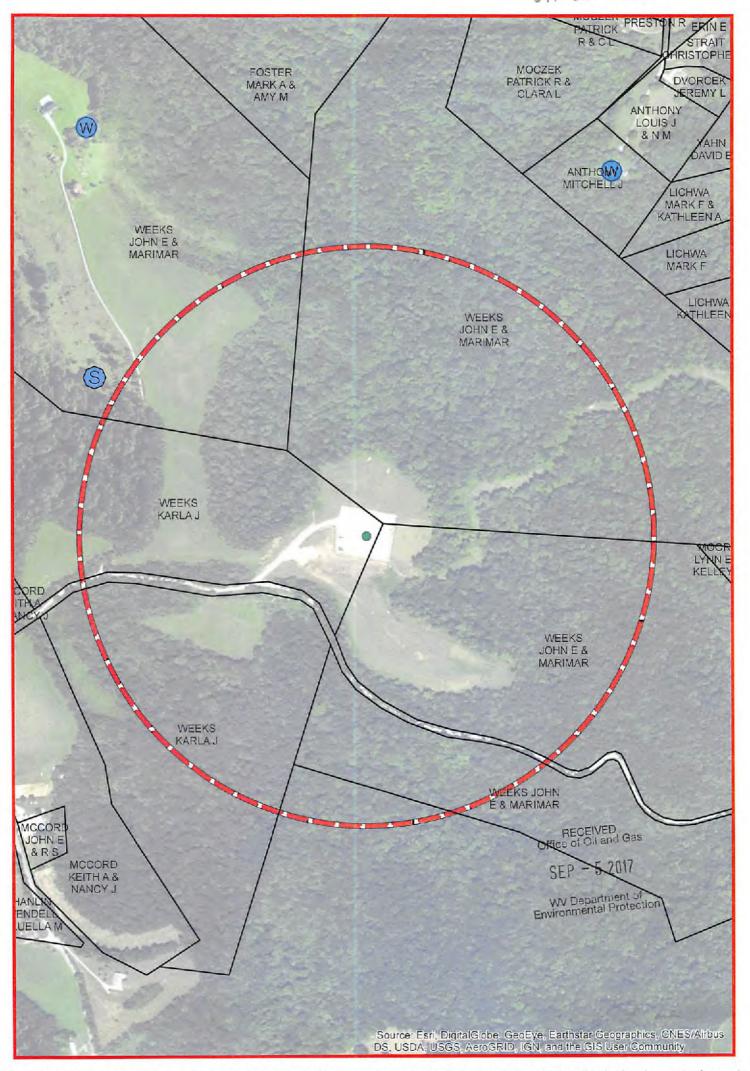

The intent of this map is for general reference only. Information on this map was created using the best available data at the time but is not guaranteed accurate. 12/08/2017

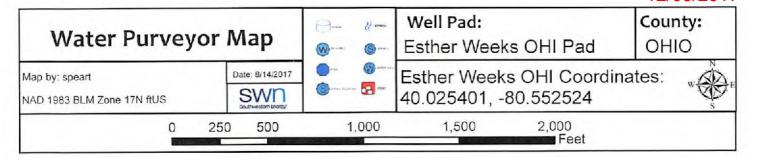

### STATE OF WEST VIRGINIA DEPARTMENT OF ENVIRONMENTAL PROTECTION, OFFICE OF OIL AND GAS NOTICE OF INTENT TO DRILL

Pursuant to W. Va. Code § 22-6A-16(b), the Notice of Intent to Drill is only required if the notice requirements of W. Va. Code § 22-6A-10(a) have NOT been met or if the Notice of Intent to Drill requirement has NOT been waived in writing by the surface owner.

e of Notice	e: 08/15/2017	Da	te Permit Application Filed:	
livery meth	od pursuant	to West Virginia Co	ode § 22-6A-16(b)	
HAND		CERTIFIED MAIL		
DELIVE		RETURN RECEIP		
ceipt request illing a horiz this subsect bsection ma	ed or hand del contal well: P ion as of the de y be waived in	ivery, give the surface rovided. That notice ate the notice was pro- writing by the surface	ten days prior to filing a permit application, be owner notice of its intent to enter upon to given pursuant to subsection (a), section to ovided to the surface owner: <i>Provided, how</i> the owner. The notice, if required, shall included mail address of the operator and the operator	the surface owner's land for the purpose of en of this article satisfies the requirements wever, That the notice requirements of this lude the name, address, telephone number,
		d to the SURFAC		
ame: Karla J. W	leeks Heather Down Dr.		Name:Address:	
	DEGINE DOWN UT.			
otice is her ursuant to W e surface ow ate:	eby given: est Virginia C ner's land for West Virginia		notice is hereby given that the undersigned g a horizontal well on the tract of land as for the l	ollows: 538,180.29
otice is her arsuant to W e surface ow ate: ounty: istrict:	eby given: est Virginia C ner's land for	the purpose of drillin	notice is hereby given that the undersigned g a horizontal well on the tract of land as for	ollows:
otice is her arsuant to W e surface ow ate: ounty: istrict:	eby given: est Virginia Coner's land for West Virginia Ohio Triadelphia	the purpose of drillin	notice is hereby given that the undersigned g a horizontal well on the tract of land as for the desired by the contract of land as for the contract of land as for the contract of land as for the contract of	ollows: 538,180.29 4,430,673.39 Oklahama Road
otice is her ursuant to W e surface ow ate: ounty: istrict: uadrangle: /atershed: his Notice is ursuant to W csimile num elated to hori cated at 601	eby given: est Virginia Coner's land for West Virginia Chio Triadelphia Valley Grove, WV Upper Ohio South Shall Include Jest Virginia ber and electric zontal drilling 57th Street, SE	e: Code § 22-6A-16(b) conic mail address o may be obtained fro Charleston, WV 2:	notice is hereby given that the undersigned g a horizontal well on the tract of land as for the undersigned.  UTM NAD 83  Public Road Access:  Generally used farm name:  On this notice shall include the name, add the operator and the operator's authorized the undersigned from the Secretary, at the WV Department of the undersigned from the undersigned f	ollows: 538,180.29 4,430,673,39 Oklahoma Road Esther Weeks OHI  ress, telephone number, and if available, and representative. Additional information of Environmental Protection headquarters, ep.wv.gov/oil-and-gas/pages/default.aspx.





The Office of Oil and Gas processes your personal information, such as name, address and telephone number, as part of our regulatory duties. Your personal information may be disclosed to other State agencies or third parties in the normal course of business or as needed to comply with statutory or regulatory requirements, including Freedom of Information Act requests. Our office will appropriately secure your personal information. If you have any questions about our use or your personal information, please contact DEP's Chief Privacy Officer at depprivacyofficer@wv.gov.

WW-6A5 (1/12)

### STATE OF WEST VIRGINIA DEPARTMENT OF ENVIRONMENTAL PROTECTION, OFFICE OF OIL AND GAS NOTICE OF PLANNED OPERATION

Date		2: 08/15/2017		no later than the filing Application Filed:	8 3 1 1	аррисанов.
Delive	ery meth	od pursuant to West	Virginia Code §	§ 22-6A-16(c)	1 1	
	CERTIE	IED MAIL		l hand		
		N RECEIPT REQUES	RTED	DELIVERY		
	KLICK	TARLELLI I REQUE.	1110	DEGITIER		
return the plane require drillin damag (d) The of not	receipt r anned op red to be lig of a ho ges to the ne notices ice.	requested or hand deli- peration. The notice provided by subsection prizontal well; and (3 surface affected by o s required by this section	very, give the sur required by this n (b), section ten ) A proposed sur il and gas operation on shall be given	face owner whose land subsection shall inclu- of this article to a surf- face use and compens ons to the extent the da- to the surface owner a	I will be used for de: (1) A copy ace owner whost ation agreement mages are com	cation, an operator shall, by certified mail or the drilling of a horizontal well notice of of this code section; (2) The information se land will be used in conjunction with the not containing an offer of compensation for pensable under article six-b of this chapter, sted in the records of the sheriff at the time
		by provided to the SI				
	: address : Karla J. W	listed in the records o	the sheriff at the	Name:		
		Heather Down Dr.		Addres	V:	
Addre						
Notice Pursua	e is herel ant to We	by given: est Virginia Code § 22		e is hereby given that the		well operator has developed a planned
Notice Pursua operat State: Count	e is herel ant to We tion on the	by given: est Virginia Code § 22		e is hereby given that the of drilling a horizonta UTM NAD 8	l well on the tra Easting: Northing:	
Notice Pursua operat State: Count District	e is herel ant to We tion on the	by given: est Virginia Code § 22 he surface owner's lan West Virginia Ohio Triadelphia		e is hereby given that the of drilling a horizonta  UTM NAD 8  Public Road	I well on the tra  Easting: Northing: Access:	nct of land as follows: 533,180.29 4,430,673.39 Oklahoma Road
Notice Pursua operat State: Count District Quadr	e is herel ant to We tion on the ct: angle:	by given: est Virginia Code § 22 he surface owner's lan West Virginia Ohio Triadelphia Valley Grove, WV		e is hereby given that the of drilling a horizonta  UTM NAD 8  Public Road	l well on the tra Easting: Northing:	533,180.29 4,430,673.39
Notice Pursua operat State: Count District	e is herel ant to We tion on the ct: angle:	by given: est Virginia Code § 22 he surface owner's lan West Virginia Ohio Triadelphia		e is hereby given that the of drilling a horizonta  UTM NAD 8  Public Road	I well on the tra  Basting: Northing: Access:	nct of land as follows: 533,180.29 4,430,673.39 Oklahoma Road
Notice Pursua operat State: Count District Quadr Water This N Pursua to be horizo surfac inform headq	e is herel ant to We tion on the ty: ct: rangle: rshed:  Notice SI ant to We provided ontal well be affecte nation re	by given: est Virginia Code § 22 he surface owner's lan West Virginia Ohio Triadelphia Valley Grove, WV Upper Ohio South hall Include: est Virginia Code § 23 h by W. Va. Code § h; and (3) A proposed d by oil and gas oper lated to horizontal dr located at 601 57th S	2-6A-16(c), this n 22-6A-10(b) to a surface use and cations to the exterilling may be obtained.	e is hereby given that the of drilling a horizontal UTM NAD 8  ———————————————————————————————————	I well on the tra Easting: Northing: Access: d farm name:  A copy of this land will be understand arry, at the WV	nct of land as follows: 533,180.29 4,430,673.39 Oklahoma Road



The Office of Oil and Gas processes your personal information, such as name, address and telephone number, as part of our regulatory duties. Your personal information may be disclosed to other State agencies or third parties in the normal course of business or as needed to comply with statutory or regulatory requirements, including Freedom of Information Act requests. Our office will appropriately secure your personal information. If you have any questions about our use or your personal information, please contact DEP's Chief Privacy Officer at depprivacyofficer@wv.gov.

Environmental Protect 12/08/2017



### WEST VIRGINIA DEPARTMENT OF TRANSPORTATION

### Division of Highways 1900 Kanawha Boulevard East • Building Five • Room 110

Charleston, West Virginia 25305-0430 • (304) 558-3505

Jim Justice Governor

Thomas J. Smith, P. E. Secretary of Transportation/ Commissioner of Highways

August 11, 2017

James A. Martin, Chief Office of Oil and Gas Department of Environmental Protection 601 57th Street, SE Charleston, WV 25304

Subject: DOH Permit for the Ester Weeks Pad, Ohio County Esther Weeks OHI 201H Well Site

Dear Mr. Martin.

The West Virginia Division of Highways has transferred Permit #06-2010-0343 for the subject site to Southwestern Energy for access to the State Road for the well site located off of Ohio County Route 23/4 SLS.

The operator has signed an OIL AND GAS ROAD MAINTENANCE BONDING AGREEMENT and provided the required Bond. This operator is currently in compliance with the DOH OIL AND GAS POLICY dated January 3, 2012.

> Very Truly Yours, Gary K. Clayton

Gary K. Clayton

Regional Maintenance Engineer Central Office Oil & Gas Coordinator

Brittany Woody Cc: Southwestern Energy CH, OM, D-6 File


Environmental Protection

Product Name	Product Use	Chemical Name	CAS Number
		Hydrogen Peroxide	7722-84-1
EC6734A (Champion Technologies)	Biocide	Acetic Acid	64-19-7
		Peroxyacetic Acid	79-21-0
GYPTRON T-390 (Champion	Caala labibibaa	Methanol	67-56-1
Technologies)	Scale Inhibitor	Nonylphenol Ethoxylate	Proprietary
		Glutaraldehyde	111-30-8
Bactron K-139 (Champion	Biocide	Quaternary Ammonium Compounds, Benzyl-C12-	60434.05.4
Technologies)	Biocide	16-Alkyldimethyl, Chlorides	68424-85-1
		Ethanol	64-17-5
Bactron K-219 (Champion	Biocide	Methanol	67-56-1
Technologies)		Quaternary Ammonium Compounds, Benzyl-C12- 16-Alkyldimethyl, Chlorides	68424-85-1
		Methanol	67-56-1
A264 (Schlumberger)	Corrosion	Aliphatic Acids	Proprietary
A204 (schlumberger)	Inhibitor	Prop-2-yn-1-ol	107-19-7
		Aliphatic Alcohols, Ethoxylated #1	Proprietary
Name ide CA 35 (5.1)	Biocide	Water	7732-18-5
Myacide GA 25 (Schlumberger)	Biocide	Glutaral	111-30-8
Coole Inhihiten D217 (c	Carla Inhihitan	Trisodium Ortho Phosphate	7601-54-9
Scale Inhibitor B317 (Schlumberger)	Scale Inhibitor	Ethane-1,2-diol	107-21-1
H215 (Schlumberger)	Hydrochloric Acid	Hydrochloric Acid	7647-01-0
J218 (Schlumberger)	Breaker	Diammonium Peroxidisulphate	7727-54-0
EB-Clean* J475 (Schlumberger)	Breaker	Diammonium Peroxidisulphate	7727-54-0
Water Gelling Agent J580 (Schlumberger)	Gel	Carbohydrate Polymer	Proprietary
Friction Reducer J609W	Friction	Ammonium Sulfate	7783-20-2
(Schlumberger)	Reducer	Urea	57-13-6
Crosslinker J610 (Schlumberger)	Crosslinker	Potassium Hydroxide	1310-58-3
CIOSSIIIKEI JOTO (Schlumberger)	Crossilikei	Aliphatic Polyol	Proprietary
Iron Stabilizer L58 (Schlumberger)	Iron Stabilizer	Sodium Erythorbate	6381-77-7
40/70-Mesh Sand S012 (Schlumberger)	Sand	Crystalline Silica	14808-60-7
Sand S100 (Schlumberger)	Sand	Crystalline Silica	14808-60-7
EC6486A (Nalco Champion)	Scale Inhibitor	Amine Triphosphate	Proprietary
		Ethylene Glycol	107-21-1
SSA-2 (Halliburton)	Sand	Crystalline Silica	14808-60-7
FR-76 (Halliburton)	Friction	Inorganic salt	64742-47-8
	Reducer	Hydrotreated light petroleum distillate	
LCA-1 (Halliburton)		Hydrotreated light petroleum distillate of रंग बनत Ga	Proprietary
SP BREAKER (Halliburton)	Breaker	Sodium Persulfate	\$ 7775-27 <b>-</b> 1

### 047-069-00256

Product Name	Product Use	Chemical Name	CAS Number
		Methanol	
HAI-150E (Halliburton)	Corrosion —	Aliphatic Acids	NA NA
	Inhibitor	Prop-2-yn-1-ol	
		Aliphatic Alcohols, Ethoxylated #1	_
Hydrochloric Acid 10-30% (Halliburton)		Hydrochloric Acid	7647-01-0
WG-36 Gelling Agent (Halliburton)	Gel	Polysaccharide	9000-30-0
BC-140C (Halliburton)	Crosslinker		NA



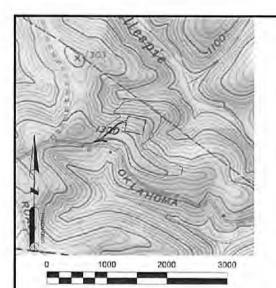

SCALE 1" = 1000"

# ESTHER WEEKS PAD CONSTRUCTION AS-BUILT TRIADELPHIA DISTRICT, OHIO COUNTY, WV SEPTEMBER 26, 2017

C-102 **EVACUATION ROUTE / PREVAILING WINDS** C-201 CONSTRUCTION/AS-BUILT OVERVIEW C-301 CONSTRUCTION/AS-BUILT C-302 CONSTRUCTION/AS-BUILT C-303 CONSTRUCTION/AS-BUILT C-401 CONSTRUCTION/AS-BUILT ACCESS ROAD PROFILE R-501 RECLAMATION OVERVIEW R-601 RECLAMATION PLAN R-602 RECLAMATION PLAN R-603 RECLAMATION PLAN R-701 RECLAMATION DETAILS R-702 RECLAMATION DETAILS R-703 RECLAMATION DETAILS

COVER SHEET

**EVACUATION ROUTE / PREVAILING WINDS** 

SHEET INDEX

C-001


C-101

COORDINATES: SITE ENTRANCE (NAD 83) LAT: 40.024634 LONG: -80.554602

AT WEEKS PAD (NAD 83) LAT: 40.025513 LONG: -80.553108


(NAD 83) LAT: 40.025341 LONG: -80.552522

(NAD 83) LAT: 40.024639 LONG: -80.554686 EXISTING WELLS: API 4706900063 WEEKS 1H (NAD 83) LAT: 40.025403 LONG: -80.552498

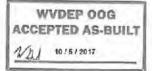





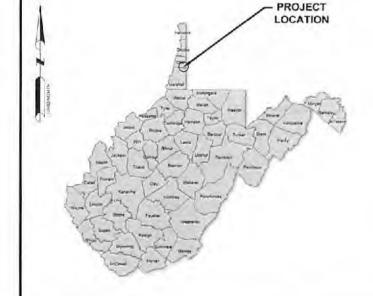

LOD		
DESCRIPTION	ACRES	
ROAD DISTURBED AREA	9.71	
PAD DISTURBED AREA	8.70	
TOTAL	18.41	



SWN Preduction Company LLC

20011


Production Company \*\*\*

ESTHER WEEKS COVER SHEET C-001

	TR	IADELPE	HA DISTRI	CT, OHIC	COUNTY,	WV.
WARY.	1001	CHOCKER	DATE	YMAGGGG	DATE	100
DK	09428417	445.50	19x 19x 17	(20)	190 - 26 - 1 d	449

ERANNA 2017-301 Weeks\_As-But\_Plans.dwg

THE MAPPING

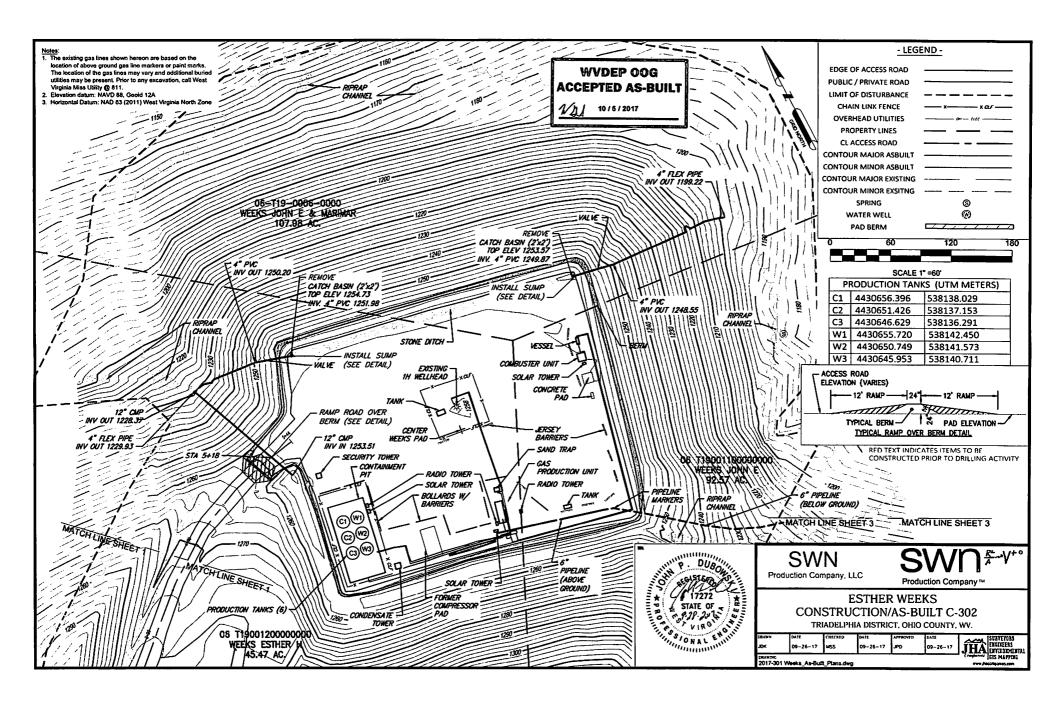

# 0 1000 2000 3000 SCALE 1" =1000'

# ESTHER WEEKS PAD CONSTRUCTION AS-BUILT TRIADELPHIA DISTRICT, OHIO COUNTY, WV MAY 12, 2017

Office of Oil and Gas SEP - 5 2017

MECOORDINATES:

SITE ENTRANCE

(NAD 83)

LAT: 40.024634

LONG: -80.554602


AT WEEKS PAD (NAD 83) LAT: 40.025513 LONG: -80.553108

CENTER OF PAD (NAD 83) LAT: 40.025341 LONG: -80.552522


GATHERING AREA (NAD 83) LAT: 40.024639 LONG: -80.554686 EXISTING WELLS: API 4706900063 WEEKS 1H (NAD 83) LAT: 40.025403 LONG: -80.552498

d. W.


SHEET IN	DEX
C-001	COVER SHEET
C-101	<b>EVACUATION ROUTE / PREVAILING WINDS</b>
C-102	EVACUATION ROUTE / PREVAILING WINDS
C-201	CONSTRUCTION/AS-BUILT OVERVIEW
C-301	CONSTRUCTION/AS-BUILT
C-302	CONSTRUCTION/AS-BUILT
C-303	CONSTRUCTION/AS-BUILT
C-401	CONSTRUCTION/AS-BUILT ACCESS ROAD PROFILE
R-501	RECLAMATION OVERVIEW
R-601	RECLAMATION PLAN
R-602	RECLAMATION PLAN
R-603	RECLAMATION PLAN
R-701	RECLAMATION DETAILS
R-702	RECLAMATION DETAILS
R-703	RECLAMATION DETAILS

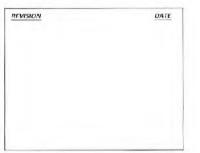



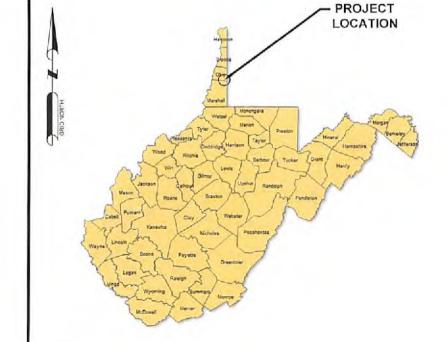

LOD		
DESCRIPTION	ACRES 9.71	
ROAD DISTURBED AREA		
PAD DISTURBED AREA	8.70	
TOTAL	18.41	

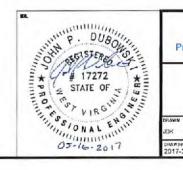

### SWN

Production Company, LLC



### ESTHER WEEKS COVER SHEET C-001

TRIADELPHIA DISTRICT, OHIO COUNTY, WV.

	DATE 04-28-17	MSS	04-28-17	JPD JPD	D5-14-17	JHA SURVEYORS ENGINEERS ENVERONMENTAL
301	Weeks_As-Bul	t_Plans.dwg	1			www.jhacompanies.com