WW-7 8-30-06




## West Virginia Department of Environmental Protection Office of Oil and Gas WELL LOCATION FORM: GPS

API: 47-069-00304		
FARM NAME: Warwood M	larina	WELL NO.: Warwood Marina
RESPONSIBLE PARTY NAME: Hydrocarbon Well Services, Inc.		
COUNTY: Ohio  QUADRANGLE: Whee lin g		
SURFACE OWNER: Warwood Marina Inc.		
ROYALTY OWNER: Warwood	Marina Inc.	
UTM GPS NORTHING: 4441243.5N		
UTM GPS EASTING:	E (	GPS ELEVATION: 653
The Responsible Party named above has chosen to submit GPS coordinates in lieu of preparing a new well location plat for a plugging permit or assigned API number on the above well. The Office of Oil and Gas will not accept GPS coordinates that do not meet the following requirements:  1. Datum: NAD 1983, Zone: 17 North, Coordinate Units: meters, Altitude: height above mean sea level (MSL) – meters.  2. Accuracy to Datum – 3.05 meters  3. Data Collection Method: Survey grade GPS: Post Processed Differential		
Real-Time Differential		
Mapping Grade GPS: Post Processed Differential		
Real-Time Differential		
4. Letter size copy of the topography map showing the well location.  I the undersigned, hereby certify this data is correct to the best of my knowledge and belief and shows all the information required by law and the regulations issued and prescribed by the Office of Oil and Gas.		
17-2-	President	7/10/2020
Signature	Title	Date

RECEIVED
Office of Oil and Gas

FED 18 ....

WV Department of Environmental Protection

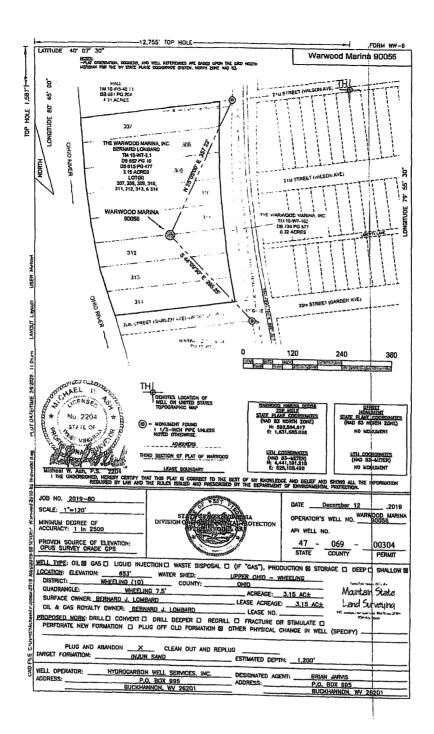

## RECEIVED Office of Oil and Gas

FEF 18 2020

WW Department of Environmental Protection

