

BOTTOM HOLE

Latitude: 40°07'30"

9,684



SURFACE HOLE LOCATION (SHL):	
UTM (NADB3, ZONE 17, METERS): NORTHING: 4,435,793.108 EASTING: 531,963.186	
LANDING POINT LOCATION (LPL):	AZIMUTH POINT LOCATION-5 (AZL5):
UTM (NADB3, ZONE 17, METERS): NORTHING: 4,435,481,861 EASTING: 531,420,540	UTM (NAD83, ZONE 17, METERS): NORTHING: 4,439,645.275 EASTING: 529,275.369
AZIMUTH POINT LOCATION-1 (AZL1):	AZIMUTH POINT LOCATION-6 (AZL6):
UTM (NAD83, ZONE 17, METERS): NORTHING: 4,437,363.837 EASTING: 530,494.071	UTM (NADB3, ZONE 17, METERS): NORTHING: 4,439,696,488 EASTING: 529,249.064
AZIMUTH POINT LOCATION-2 (AZL2):	AZIMUTH POINT LOCATION-7 (AZL7):
UTM (NAD83, ZONE 17, METERS): NORTHING: 4,437,389.599 EASTING: 530,480.889	UTM (NADB3, ZONE 17, METERS): NORTHING: 4,439,877,116 EASTING: 529,160.008
AZIMUTH POINT LOCATION-3 (AZL3):	AZIMUTH POINT LOCATION-8 (AZL8).
UTM (NAD83, ZONE 17, METERS): NORTHING: 4,438,822,792 EASTING: 529,748,084	UTM (NAD83, ZONE 17, METERS): NORTHING: 4,439,903.173 EASTING: 529,147.410
AZIMUTH POINT LOCATION-4 (AZL4):	BOTTOM HOLE LOCATION (BHL):
UTM (NADB3, ZONE 17, METERS): NORTHING: 4,438,898,453 EASTING: 529,707,402	UTM (NADB3, ZONE 17, METERS); NORTHING: 4,440,185,727 EASTING: 529,006,730

SHI

4.926

HOLE

BOTTOM

80.37'30"

ongitude:

2000



AZLB TO BH DISTANCE

2000

RESTRICTIONS THE DWELLINGS > 2500 SO FT. WITHIN 625 FEET OF OCCUPIED WITTINGS > 2500 SO FT. WITHIN 625 FEET OF NEER OF PAD.

OAGRICULTURE BUILDINGS > 2500 SQ FT. WITHIN 625 FEET OF NEER OF PAD.

ATER WELLS OR DEVELOPED SPRINGS ARE WITHIN 250 FEET OF NOPOSED WELL.

ET OF THE LIMITS OF DISTURBANCE.


O NATURALLY PRODUCING TROUT STREAM WITHIN 300 FEET OF MITS OF DISTURBANCE.

O GROUND INTAKE OR PUBLIC WATER SUPPLY WITHIN 1000 FEET OF WELL PAD, LIMITS OF DISTURBANCE.

O GROUND INTAKE OR PUBLIC WATER SUPPLY WITHIN 1000 FEET OF WELL PAD, LIMITS OF DISTURBANCE.

WELL PAD, LIMITS OF DISTURBANCE, E & S CONTROLS OR UBLIC WATER SUPPLY.

David I Jacks

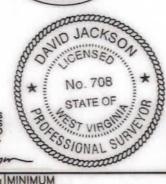

NTS

GRAPHIC SCALE IN FEET COMPANY: Production Company, LLC Production Company™

0

(+) DENOTES LOCATION OF WELL ON MINIMUM DEGREE

OFFICE OF OIL & GAS 601 57TH STREET CHARLESTON, WV 25034 DEGREE OF ACCURACY:

PROVEN SURVEY SOURCE OF GRADE GPS ELEVATION: (NAVD 88, US FT)

MELVIN KAHLE OHI 201H OPERATOR'S WELL #:

00347 069 47 API WELL #: PERMIT STATE

COUNTY

WELL TYPE:	OIL WASTE	DISPOSAL	PRODUCTION	DEEP	GAS X	LIQUID INJ	ECTION	STORAGE	SHALLOW)
WATERSHED	: MCCOY RUN OF	LITTLE WHEELING	CREEK OF WHEELING	CREEK (H	UC-10)		ELEVATION:	1,276.1	
DISTRICT:	TRIADELPHIA		COUNTY: OHIO				QUADRANGLE	: WHEELING, WV	
SURFACE O	WNER: MELVIN W.	KAHLE JR. & CAI	ROL M. KAHLE				ACREAGE:	±84.99	
OIL & GAS	ROYALTY OWNER:	MELVIN W. KAHLE	JR. & CAROL M. K	AHLE			ACREAGE:	±84.99	
DRILL	DRILL DEEPER	REDRILL	FRACTURE OR STIN	MULATE	PLUG OFF	OLD FORM	ATION	PERFORATE NEW I	FORMATION
CONVERT	PILIC & AR	ANDON CI	FAN OUT & REPLUC	OT	HER CHANGE	X (SPECIE	MODIFICATI	ION	

TARGET TORMATION. MARKOLLEGO	COTHETIC
WELL OPERATOR: SWN PRODUCTION COMPANY, LLC	DESIGNATED AGENT: BRITTANY WOODY
ADDRESS. 1300 FORT DIEPRONT POAD SHITE 200	ADDRESS: 1300 FORT PIERPONT ROAL

=

ESTIMATED DEPTH: 06/30/2023 TMD


1300 FORT PIERPONT ROAD, SUITE 200 W ZIP CODE: MORGANTOWN CITY: MORGANTOWN STATE: 26508 STATE: WV ZIP CODE: REVISIONS: DATE: 06-01-2023

LEGEN):
0	PROPOSED SURFACE HOLE / BOTTOM HOLE
茶	EXISTING / PRODUCING WELLHEAD
LPL*	LANDING POINT LOCATION
(90)	EXISTING WATER WELL

(S) EXISTING SPRING

TARCET FORMATION - MARCELLIS

	SURVEYED BOUNDARY DRILLING UNIT
	= LEASE BOUNDARY
	ASDRILLED PATH PROPOSED PATH
AZLX	AZIMUTH POINT LOCATIO

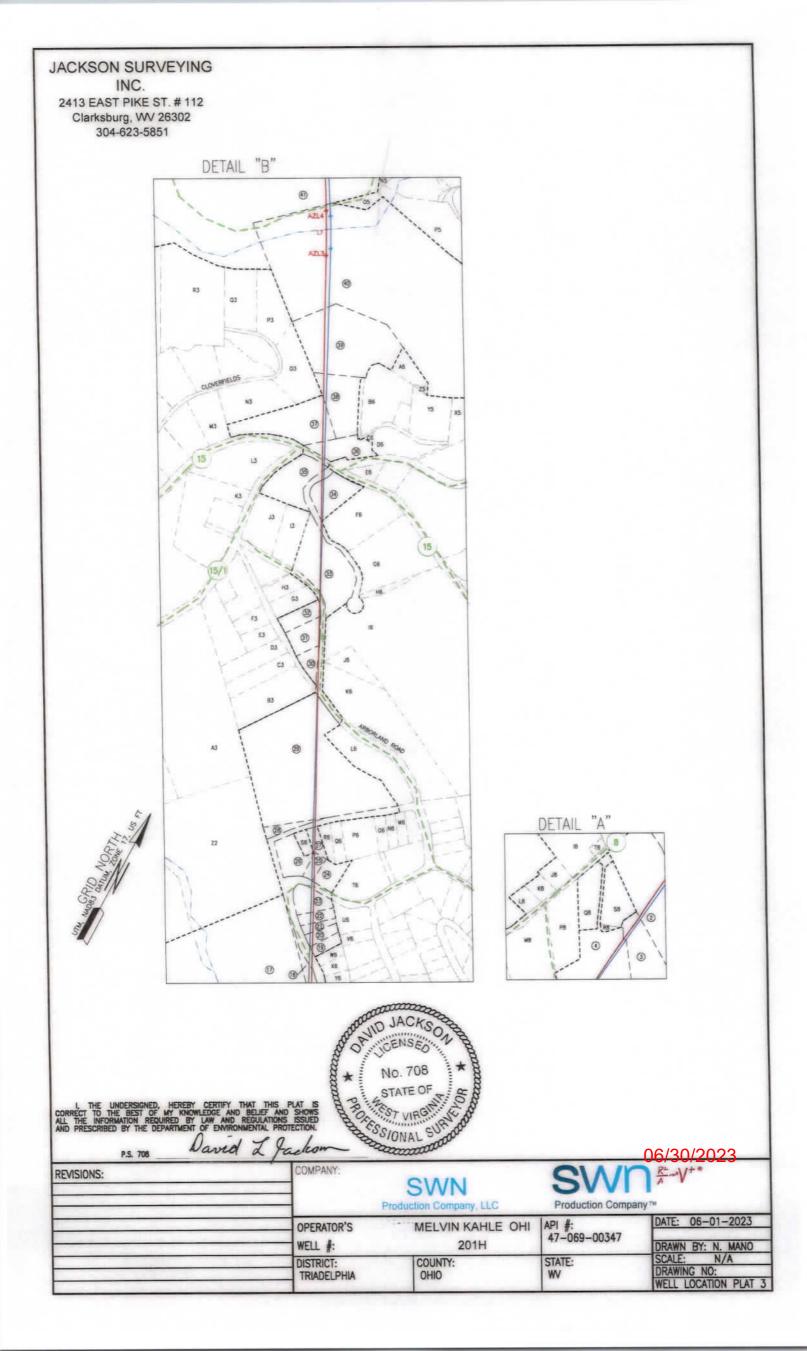

JACKSON SURVEYING

INC.

2413 EAST PIKE ST. # 112 Clarksburg, WV 26302 304-623-5851

	WELL BORE TRACTS		
TRACT	SURFACE OWNER (S) / ROYALTY OWNER (R)	TAX PARCEL	
1	KAHLE MELVIN W JR & CAROL M (5)	6-17-170	
TRACT	SURFACE OWNER (S)	TAX PARCEL	
2	DICKEY THOMAS O III ET AL(S)	6-77-171	
3	DAVIS CONNIE (S)	6-T7-172.16	
4	PAXTON DAVID M & CLAIRE (S)	6-T7-172.19	
5	TOMINACK THOMAS S & M D (S)	6-T7-172.8	
6	TOMINACK THOMAS SCOTT (S)	6-T7-172.7	
7	ANDERSON CLIFFORD R ET AL (S)	6-17-172	
8	HEARN LYLE & KIMBERLIE (S)	6-T7-173	
9	POLUS JODY & ALEXANDRIA (5)	6-T7-158	
10	DANEHART ARTHUR W & P R(LIFE) ENGLAND CYNTHIA A ET AL (5)	6-17-141	
11	CROFT REVOCABLE TRUST (S)	6-17-139	
12	SAPORITO MICHAEL A & RAEL(S)	6-17-136	
13	DICKERSON CYNTHIA ANN ET AL (S)	6-T2-22	
14	HATCHER EDWARD A (5)	6-T2-21	
15	HATCHER EDWARD A SR (S)	6-T2-21.4	
16	HALL EULA BERNICE (S)	4-R18-3	
17	MINCH TIMMY B & AMY L (5)	6-T2-18	
18	VEMURI HOME & GARDEN LLC (S)	4-R17H-1	
19	HOLT CHRISTINE L (5)	4-R17D-33.1	
20	MEEKER JO ANN (S)	4-R17D-31.1	
21	STORM CAROLANNE (5)	4-R17D-31	
22	DEEDS J G & M K GARRISON (S)	4-R17D-30	
23	SOVINSKI V J & H G (S)	4-R17D-28	
24	KNIERIM PHILIP & SANDRA (S)	4-R17D-24	
25	BARRY JON J & JAYMIE J (5)	4-R17D-26	
26	BARRY JON & JAYMIE (S)	4-R17D-3	
27	BARRY JON J & JAYMIE J (5)	4-R17D-5	
28	L&B DEVELOPMENT LLC (S)	4-R17D-1	
29	NUTTING G OGDEN TRUST (5)	4-R17-34	
30	GRINDLEY JOHN K & LINDA M (5)	4-R17-31	
31	GRINDLEY JOHN K & LINDA M (S)	4-R14-81	
32	PEYTON EDWARD L & J A (S)	4-R14-80	
33	CUFFARO PETER L (5)	4-R14-82.6	
34	GRUBLER MICHAEL J (S)	4-R14-82.3	
35	CRUTCHFIELD JAMES K & DIANA H (5)	4-R14-82.1	
36	YBANEZ-MORANO JESSICA (S)	10-W17D-8	
37	KAHLE KAREN E (S)	4-R14-72	
38	HERRON SARA & ROBERT D III (S)	10-W17D-8.	
39	HITCHMAN ROBERT R & STEPHANIE Z (S)	10-W17D-9	
40	WHEELING PARK COMMISSION (5)	10-W17D-7	
41	CITY OF WHEELING (S)	4-R14-15	

RACT	SURFACE OWNER	TAX PARCEL
A	MINNOTTE HOLDINGS II LLC	7-TW7-1.1
В	MINNOTTE HOLDINGS II LLC	7-TW7-2
	NAGLE FAMILY IRREVOCABLT TRUST C/O WESBANCO TRUST	7-TW7-3
C	SERVICES	771/744
D	OHIO COUNTY PUBLIC SERV DIST	7-TW7-4.1 7-TW7-5
F	OHIO COUNTY PUBLIC SERV DIST OHIO COUNTY PUBLIC SERV DIST	7-TW7-6
G	COOK DENNIS L SR	7-TW7-7
н	KOSEM KEVIN S & BRENDA A	7-TW7-8
1	LAUFFER JEAN C LE & GUTMAN CL LAUFFER ME; HESS MA	7-TW7-9
1	KOSEM KEVIN S & BRENDA A	7-TW7-10
K	KOSEM KEVIN S & BRENDA A	7-TW7-11
L	KOSEM KEVIN 5 & BRENDA A	7-TW8-1
M	K & B RENTALS LLC	7-TW8-2.1
N	MCKEE FAMILY IRREVOCABLE TRUST	6-T7-174
0	BARTLETT RANDALL E	7-17-172.15
P	BARTLETT RANDALL E & D M	6-T7-172.4
Q	KOPYAR JERRY L AND CYNTHIA L	6-17-172.6
R	DICKEY DAVID A GRAYNOVSKY MARGARET	6-17-172.3
5	BARTLETT RANDALL E & D M	6-T7-172.4
T	FURBEE DAVID L & MARY LOU	6-T7-172.5
U	STRAUB WILLIAM F & NINA J	6-17-172.20
V	ABUNDANT LIFE BAPTIST CHURCH ET AL	6-17-172.12
W	TEUFEL THOMAS M MILLER GARY & JODY IRREVOCABLE TRUST	6-T7-164 6-T7-163.4
X	MILLER GARY & JODY IRREVOCABLE TRUST	6-17-163.14
Z	LUCKY FARMS LLC	6-T7-163
A2	LAUDERMILT MARY ANN & GARY E SR	6-T7-142
B2	DANEHART ARTHUR W & P R (LIFE) ENGLAND CYNTHIA A ET AL	6-T7-140
C2	FIGARETTI ANTHONY FRANK	6-17-137
D2	FIGARETTI ANTHONY FRANK	6-T7-180
E2	WALLACE R W JR & SHOCKEY DAVID G	6-T7-134
F2	BAUER HOLLY K & PAUL M	6-17-112.1
G2	FRITTER RALPH LEE II FRITTER MELISSA EDITH	6-T7-111
H2	ORUM WILLIAM A & CYNTHIA	6-T7-178
12	ORUM M D 6/9 INT, W B ORUM 1/9 K D ORUM 1/9 & J E ORUM 1/9	6-17-135.1
12	ORUM WILLIAM A & CYNTHIA E	6-T2-19.1
K2	JUNIPER LODGE INC	6-T2-19
L2	WHEELING PARK COMMISSION	6-17-95
M2	DANEHART LUANN AND ARTHUR W JR	6-T2-16.2
N2	VILLANOVA DONALD G AND BECKY J	6-T2-16
02	VILLANOVA DONALD G AND BECKY J	6-T2-15.2
P2	FRANKE RODD A & LISA R	6-T2-15.3
Q2	MONFRADI CHARLES AND DOLORES	4-R17-58
R2	MINCH TIMMY B & AMY L	4-R17-63
52 T2	MINCH DANNY AND GINA HANSEN WILLIAM J & KAYLA M	4-R17-61 4-R17-62
U2	POCKL RONALD J	6-T2-20.1
V2	WOJCHOWSKI MORGAN A	6-T2-20
W2	MINCH TIMMY B & AMY L	4-R17-58.1
X2	MINCH ROBERT WILLIAM JR MINCH BARBARA JEAN	4-R17-57.2
Y2	MINCH ROBERT WILLIAM JR MINCH HERBERT PAUL	4-R17-57
22	NUTTING G OGDEN TRUST	4-R17-57.1
A3	NUTTING G OGDEN TRUST	4-R17-35
B3	GRINDLEY JOHN K & LINDA H	4-R17-32
C3	CONNER MICHAELT & B J	4-R17-30
D3	KEITH CAROLYN E	4-R17-29
E3	NIELSEN DOUGLAS P & LISA A	4-R17-28
F3	NIELSEN DOUGLAS P & LISA A	4-R17-27
G3	PEYTON EDWARD L & J A	4-R14-79
Н3	MUSICARO ARTHUR E & VICTORIA S	4-R14-78
13	CUFFARO PETER L	4-R14-82.7
13	KERSHUK JODI	4-R14-82.2
K3	BRAMMER KEITH F & BRAMMER SARAH G	4-R14-68
1.3	TIU WILFREDO A & MARTHA E	4-R14-71
M3	MOLNAR JOHN G & MARGARET L	4-R14-62 4-R14-61
N3	ZILLIS MICHAEL M & WHITNEY K WARD MARY LOUISE (LE) BOARD SUSAN WARD	4-R14-60
O3	LAPP SAMUEL J II & HEATHER A	4-R14-50.1
Q3	GOMPERS KATHLEEN M	4-R14-50.3
R3	GOMPERS KATHLEEN M	4-R14-50.2
53	FRIEND HARRIETTE E FRIEND L EDWARD II	4-R14-51
T3	HITCHMAN EDWARD T III HITCHMAN HELEN G	4-R14-53
U3	HINEBAUGH SAM	4-R17-8.1
V3	PARK VIEW MEMORIAL GARDENS INC	4-R17-8
W3	GACS LP	10-W27A-1
Х3	WHEELING PARK COMMISSION	4-R14-14.1
¥3	ELM HILL HOLDINGS LLC	4-R14-14
Z3	SCHULTZ JEFFREY 5	4-R14-13

ADJOINING OWNERS TABLE

				06/30/2023
REVISIONS:	COMPANY:	SWN Production Company, LLC	SWI Production Company	R*-V+*
	OPERATOR'S WELL #:	MELVIN KAHLE OHI 201H	API #: 47-069-00347	DATE: 06-01-2023 DRAWN BY: N. MANO
	DISTRICT: TRIADELPHIA	COUNTY: OHIO	STATE: WV	SCALE: N/A DRAWING NO: WELL LOCATION PLAT 4

JACKSON SURVEYING INC.

2413 EAST PIKE ST. # 112 Clarksburg, WV 26302 304-623-5851

	ADJOINING OWNERS TABLE	-
ACT	SURFACE OWNER	TAX PARCEL
A4	WHEELING PARK COMMISSION	10-W17A-1
B4 C4	PELUCHETTE JOHN M & C L POLACK EDWARD P	4-R14J-1 4-R14-95
D4	JOSEPH ELIAS E	4-R14A-53
E4	ALLEN THOMAS E	4-R14E-4
F4	SCHMITT JAMES A	4-R14-4.6
G4	SCHMITT JAMES A	4-R14-4.5
H4	HARROLD PAMELA SUE C/O GC&P ANIMAL HOSPITAL INC	4-R14-6
14	JONES WILBUR S JR JEFFERSON JOYCE P	4-R14-90
J4	SISTERS OF ST JOSEPH OF WHEELING INC	4-R11-21
K4	SISTERS OF ST JOSEPH OF WHG	4-R11-20
L4	PARKS SYSTEM TRUST FUND OF WHEELING	4-R11-21.3
M4	WHEELING PARK COMMISSION	4-R14-91
N4	WHEELING PARK COMMISSION	4-R14-20.4
04	WHEELING PARK COMMISSION	4-R14-15.2
P4 Q4	HOSFELT WILLIAM J & PATRICIA HOSFELT ESTATES RANSOM CHARLES M & CRYSTAL G	10-W12D-2 10-W12D-1
R4	BURKE SUSAN R	10-W14D-1
54	SATTERFIELD DOROTHY	10-W14D-2
T4	TUCKER ROBERT A & R	10-W14D-3
U4	MCKINLEY BETTY J	10-W14D-4
V4	BONAR RILEY L	10-W14D-5
W4	QUEEN THOMAS R & CYNTHIA A	10-W14D-6
X4	RIGGS DAVID V & KERRIE L	10-W14D-7
Y4	ROBINSON TONY A	10-W14D-8
Z4	BTCT RENTALS LLC	10-W14D-9
A5	KUHAR DOROTHY RES'V L/E KUHAR CHRISTINE	10-W14D-10
85	BERRY ETHAN E & MATHES SUSAN M	10-W14D-11
C5	PEARCE CRAGO PAULA	10-W14D-12
D5	SMITH CODY A	10-W14D-13
E5	SAFCSAK KATHLEEN	10-W14D-14
F5	DOEPKEN DAVID W & CHRISTINE B	10-W14D-15
G5	BAUER JESSICA L & CHAD	10-W14D-16
H5	NEUMAN CHARLES & B J WOTRING	10-W14D-17
15	YOUNG MARK K & SAMANTHA	10-W14D-18
J5	PETRI DANIELS & D	10-W14D-19
K5	WATSON STEVEN A & SHERI HANNA STEPHEN L & C H	10-W17D-2 10-W17D-3
MS	MILLER DAVID W & JUNKERSFELD PETER J	10-W17D-4
N5	MILLER DAVID W & JUNKERSFELD P	10-W17D-5
05	MCBANE DANIEL J & CLARE	10-W17D-6
P5	FITZSIMMONS CLAYTON J	4-R14-46.13
Q5	HIGH PHILIP D	4-R14-46.9
R5	TAYLOR CHRISTOPHER T & BRITTANY N TAYLOR	4-R14-46.12
55	TIU CHRISTOPHER & DANA K	4-R14-46.18
T5	JAMISON LINDA G KOLAS	4-R14M-3.1
U5	FULTON JOAN E	4-R14M-35
V5	BRINSKY JAMES 5 & MARY T	4-R14R-1.3
W5	SHEETS DON E	4-R14R-1.1
X5	DUPLAGA MICHAEL III & ALYSSA	4-R14-49
Y5	STRAUSS CARTER W & B S	4-R14-48
Z5	RANDOLPH LOUIS R.& CANDICE A	4-R14-48.1
A6	RANDOLPH LOUIS R & CANDICE A	10-W17D-9.
B6	FREEMAN CHRISTOPHER C BRADAC CHARLES J JR	4-R14-97 10-W17D-8
C6 D6	BRADAC CHARLES J JR	4-R14-47
E6	GORDON SCOTT LIR & CHARLENE A GORDON - TOD	4-R14-73
F6	ROCKEY BRIAN R & JULIANNE	4-R14-82.4
G6	MENDENHALL TT & C B	4-R14-82.5
H6	MENDENHALL THOMAS T & CHERYL B	4-R14-82.8
16	KRAMER JOHN N	4-R14-82
16	KRAMER JOHN N	4-R17-60.1
K6	WILMOTH WILLIAM D & REBECCA W	4-R17-60
L6	NUTTING G OGDEN TRUST	4-R17-60.2
M6	MANSUETTO MATTHEW J & MELISSA A	4-R17D-13
N6	MANSUETTO MATTHEW J & MELISSA A	4-R17D-12
06	MANSUETTO MATTHEW J & MELISSA A	4-R17D-11
P6	MANSUETTO MATTHEW J & MANSUETTO MELISSA A	4-R17D-9
Q6	MASUETTO MATTHEW J & MELISSA A	4-R17D-7
R6	BARRY JON & JAYMIE	4-R17D-6
56	BARRY JON & JAYMIE	4-R17D-4
T6	KNIERIM PHILIP G	4-R17D-1
U6	WEST THOMAS P IR	4-R17D-4
V6	WEST THOMAS P JR	4-R17D-4
W6	HOLT CHRISTINE L WEST THOMAS P	4-R17D-3
X6 Y6	EMANE THOMAS C/O PUGMIRE JUDITH ANN	4-R17D-3
Z6	WEATHERSON PENNY	4-R17H-2
A7	ALBERT ELVIRA	4-R17H-4
1. 555	ALDENI LETIMA	+ all the

	ADJOINING OWNERS TABLE	
RACT	SURFACE OWNER	TAX PARCEL
C7	ROGER K COTTRELL SR-TOD ET AL	4-R17H-7
D7	FLUHARTY DAVID L	4-R17H-8
E7	JACK PHYLLIS ANN & REUTHER JACQUELINE ANN	4-R17H-10
F7	NIZAMI SALEEM AHMAD & NIZAMI DENITRA DAWN	4-R17H-18
G7	NIZAMI SALEEM & DENITRA	4-R17H-21.1
H7	HUMWAY ROSE	4-R17D-81
17	ROBINSON RICHARD J	4-R18A-2
17	HOPKINS CLARENCE E III	4-R18-4.2
K7	CRONIN AMY PERKO CRONIN CHEYENNE WILLIAM	4-R18-21.4
L7	LAFOLLETT MARY BETH LAFOLLET CHRISTOPHER NEAL	4-R18-21
M7	HOFFMAN FAMILY IRREVOCABLE TRUST	4-R18-25
N7	JOSHUA D MILLER	4-R18-21.1
07	JOSHUA D MILLER	4-R18-21.5
P7	HOFFMAN FAMILY IRREVOCABLE TRUST	4-R18-21.2
Q7	HOFFMAN FAMILY IRREVOCALBE TRUST	4-R18-27.1
R7	HOFFMAN ROBERT LEE JR & BIERKORETTE BERNADINE	4-R18-27
57	HESS KEITH R & CAROLYN S	4-R18-2.1
17	JOHNSON HARRY E - TOD	4-R18-2
U7	HATCHER HOWARD W JR & L J	6-T2-21.6
V7	COVEY ON RISE, LLC	6-T2-21.5
W7	DAILER JAMES M & MARILYN D	6-T2-21.7
X7	NEUMAN MICHAEL C & COCHRAN SARAH	6-T2-21.1
Y7	BARON JAMES C & CAROLYN J	6-T2-21.2
27	BARON JAMES C & CAROLYN J	6-T2-21.3
A8	NEUMAN MICHAEL C & COCHRAN SARAH	6-T2-25
88	LAUDERMILT GARY E & M A	6-T2-26.1
C8	LAUDERMILT MARY A & G E	6-T2-26
D8	CROFT SAMUEL E & ROSE M TRUST CROFT SAMUEL E & ROSE M; TEES	6-T2-24
E8	CROFT SAMUEL & ROSE	6-T2-24.2
F8	JONES LAMBERT	6-T2-24.1
G8	JONES LAMBERT T II	6-T7-138
H8	KAHLE MELVIN W.JR	6-T2-30
18	BUTLER KAREN J	6-T7-160
18	BAKER JOHN & TERRIE	6-T7-170.1
К8	WYCHERLEY TAMMY & JOSEPH E SR	6T7-161
L8	WYCHERLEY TAMMY & JOSEPH E SR	6-77-161.1
MB	HELMS AMY J & HUBBARD ROBERT 5	6-T7-172.9
N8	KNOX MARK A & ALAIRE S	6-17-172.10
08	MCCONNELL SAMANTHA A & DAVID	6-T7-162
P8	MILLER THOMAS & CATHY	6-T7-172.1
Q8	PAXTON DAVID M & CLAIRE E	6-17-172.1
R8	SELAK ROBERT T & TAMMY L	6-T7-172.1
58	SELAK ROBERT T & TAMMY L	6-T7-172.1
T8	BUTLER RICHARD R & K J	6-T7-160.1
UB	KAHLE MELVIN WJR & C M	6-T7-170.2
V8	KAHLE MELVIN W JR	6-T2-36
W8	OCH CHARLES R III & MELISSA R C/O OCH MELISSA RENEE	6-T8-1
X8	MARSHALL GARY E & D A	6-T8-2.1
Y8	RIGGS FRANCIS A & D M	6-T8E-3

REVISIONS:	COMPANY:	SWN Production Company, LLC	SWI Production Company	06/30/2023 R+ V+
	OPERATOR'S WELL #:	MELVIN KAHLE OHI 201H	API #: 47-069-00347	DATE: 06-01-2023 DRAWN BY: N. MANO
	DISTRICT: TRIADELPHIA	COUNTY: OHIO	STATE: WV	SCALE: N/A DRAWING NO: WELL LOCATION PLAT