


Latitude 40° 10'

Longitude 80° 35'

0
1
2
3



+

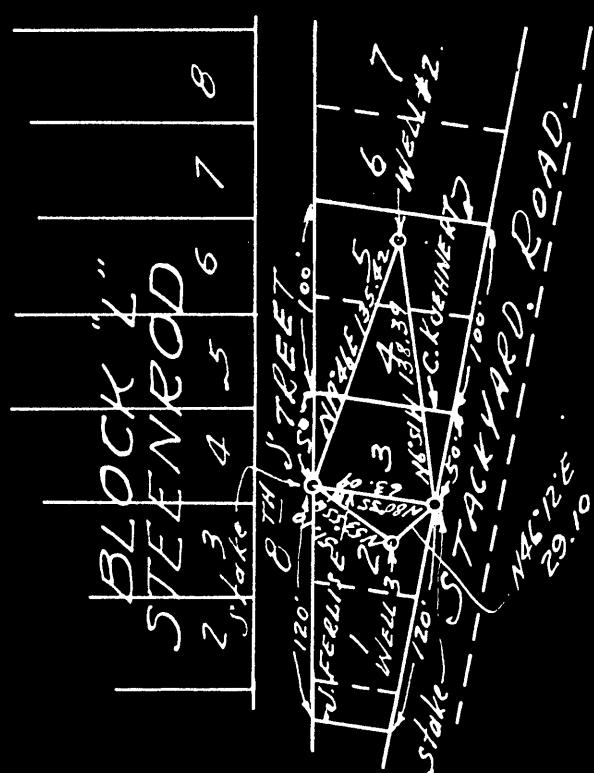

New Location
Drill Deeper
Abandonment

Company C.G. BROADDUS
Address WINDSOR HOTEL, WHEELING, W.VA
Farm (3) JOHN FERLISE - (2) C. KUEHNERT.
Tract 3 - 2 Acres CITY Lease No. _____
Well (Farm) No. 3 - 2 Serial No. _____
Elevation (Spirit Level) 670.4 (3) 673.4 (2)
Quadrangle WHEELING
County OHIO District TRIADDELPHIA
Engineer N. JAMES SCHELLHASE
Engineer's Registration No. 1673
File No. _____ Drawing No. _____
Date FEB. 21, 1949 Scale 1 IN. = 100 FT.

STATE OF WEST VIRGINIA
DEPARTMENT OF MINES
OIL AND GAS DIVISION
CHARLESTON

WELL LOCATION MAP

FILE NO. OHIO - 6-A - #3
OHIO - 7-A - #2

+ Denotes location of well on United States Topographic Maps, scale 1 to 62,500, latitude and longitude lines being represented by border lines as shown.

- Denotes one inch spaces on border line of original tracing.