

47-085-00557P

WW-7
8-30-06



West Virginia Department of Environmental Protection
Office of Oil and Gas

WELL LOCATION FORM: GPS

API: 47-085-00557 WELL NO.: 4

FARM NAME: Nutter, M.B.

RESPONSIBLE PARTY NAME: VIRCO

COUNTY: Ritchie DISTRICT: Clay

QUADRANGLE: Pullman

SURFACE OWNER: Coastal Lumber Co.

ROYALTY OWNER: _____

UTM GPS NORTHING: 4344259.70000

UTM GPS EASTING: 508389.0000 GPS ELEVATION: 926'

The Responsible Party named above has chosen to submit GPS coordinates in lieu of preparing a new well location plat for a plugging permit or assigned API number on the above well. The Office of Oil and Gas will not accept GPS coordinates that do not meet the following requirements:

1. Datum: NAD 1983, Zone: 17 North, Coordinate Units: meters, Altitude: height above mean sea level (MSL) – meters.
2. Accuracy to Datum – 3.05 meters
3. Data Collection Method:

Survey grade GPS : Post Processed Differential _____
Real-Time Differential

Mapping Grade GPS _____ : Post Processed Differential _____
Real-Time Differential _____

RECEIVED
Office of Oil and Gas
OCT 01 2020
WV Department of
Environmental Protection


4. Letter size copy of the topography map showing the well location.

I the undersigned, hereby certify this data is correct to the best of my knowledge and belief and shows all the information required by law and the regulations issued and prescribed by the Office of Oil and Gas.

Bruce Carpenter
Signature

Sr. Manager, ESHR
Title

09/22/2020
Date

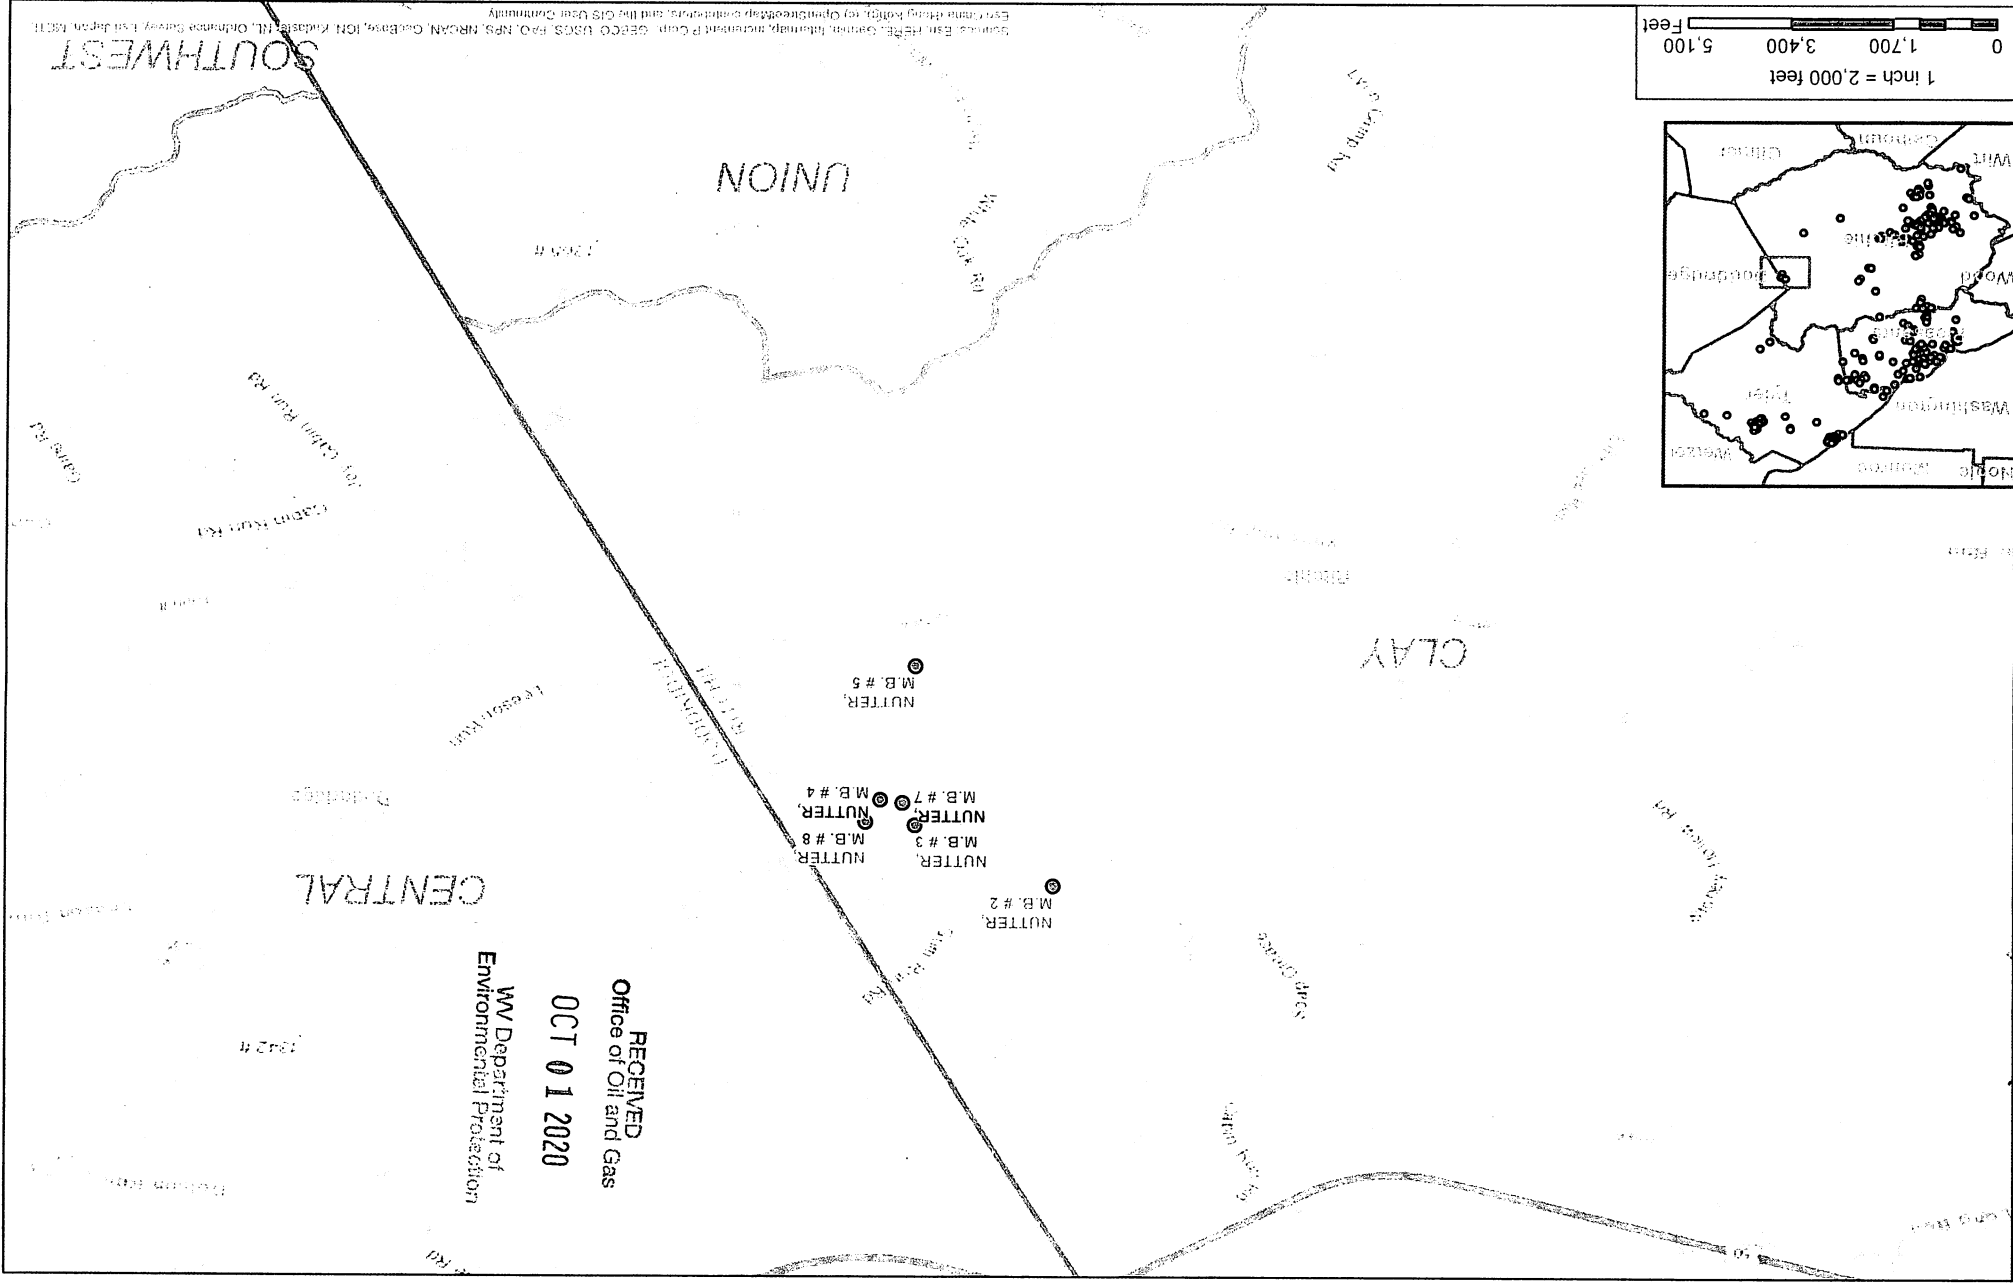

RECEIVED
 Office of Oil and Gas
 OCT 01 2020
 WV Department of
 Environmental Protection

47-085-00577P